


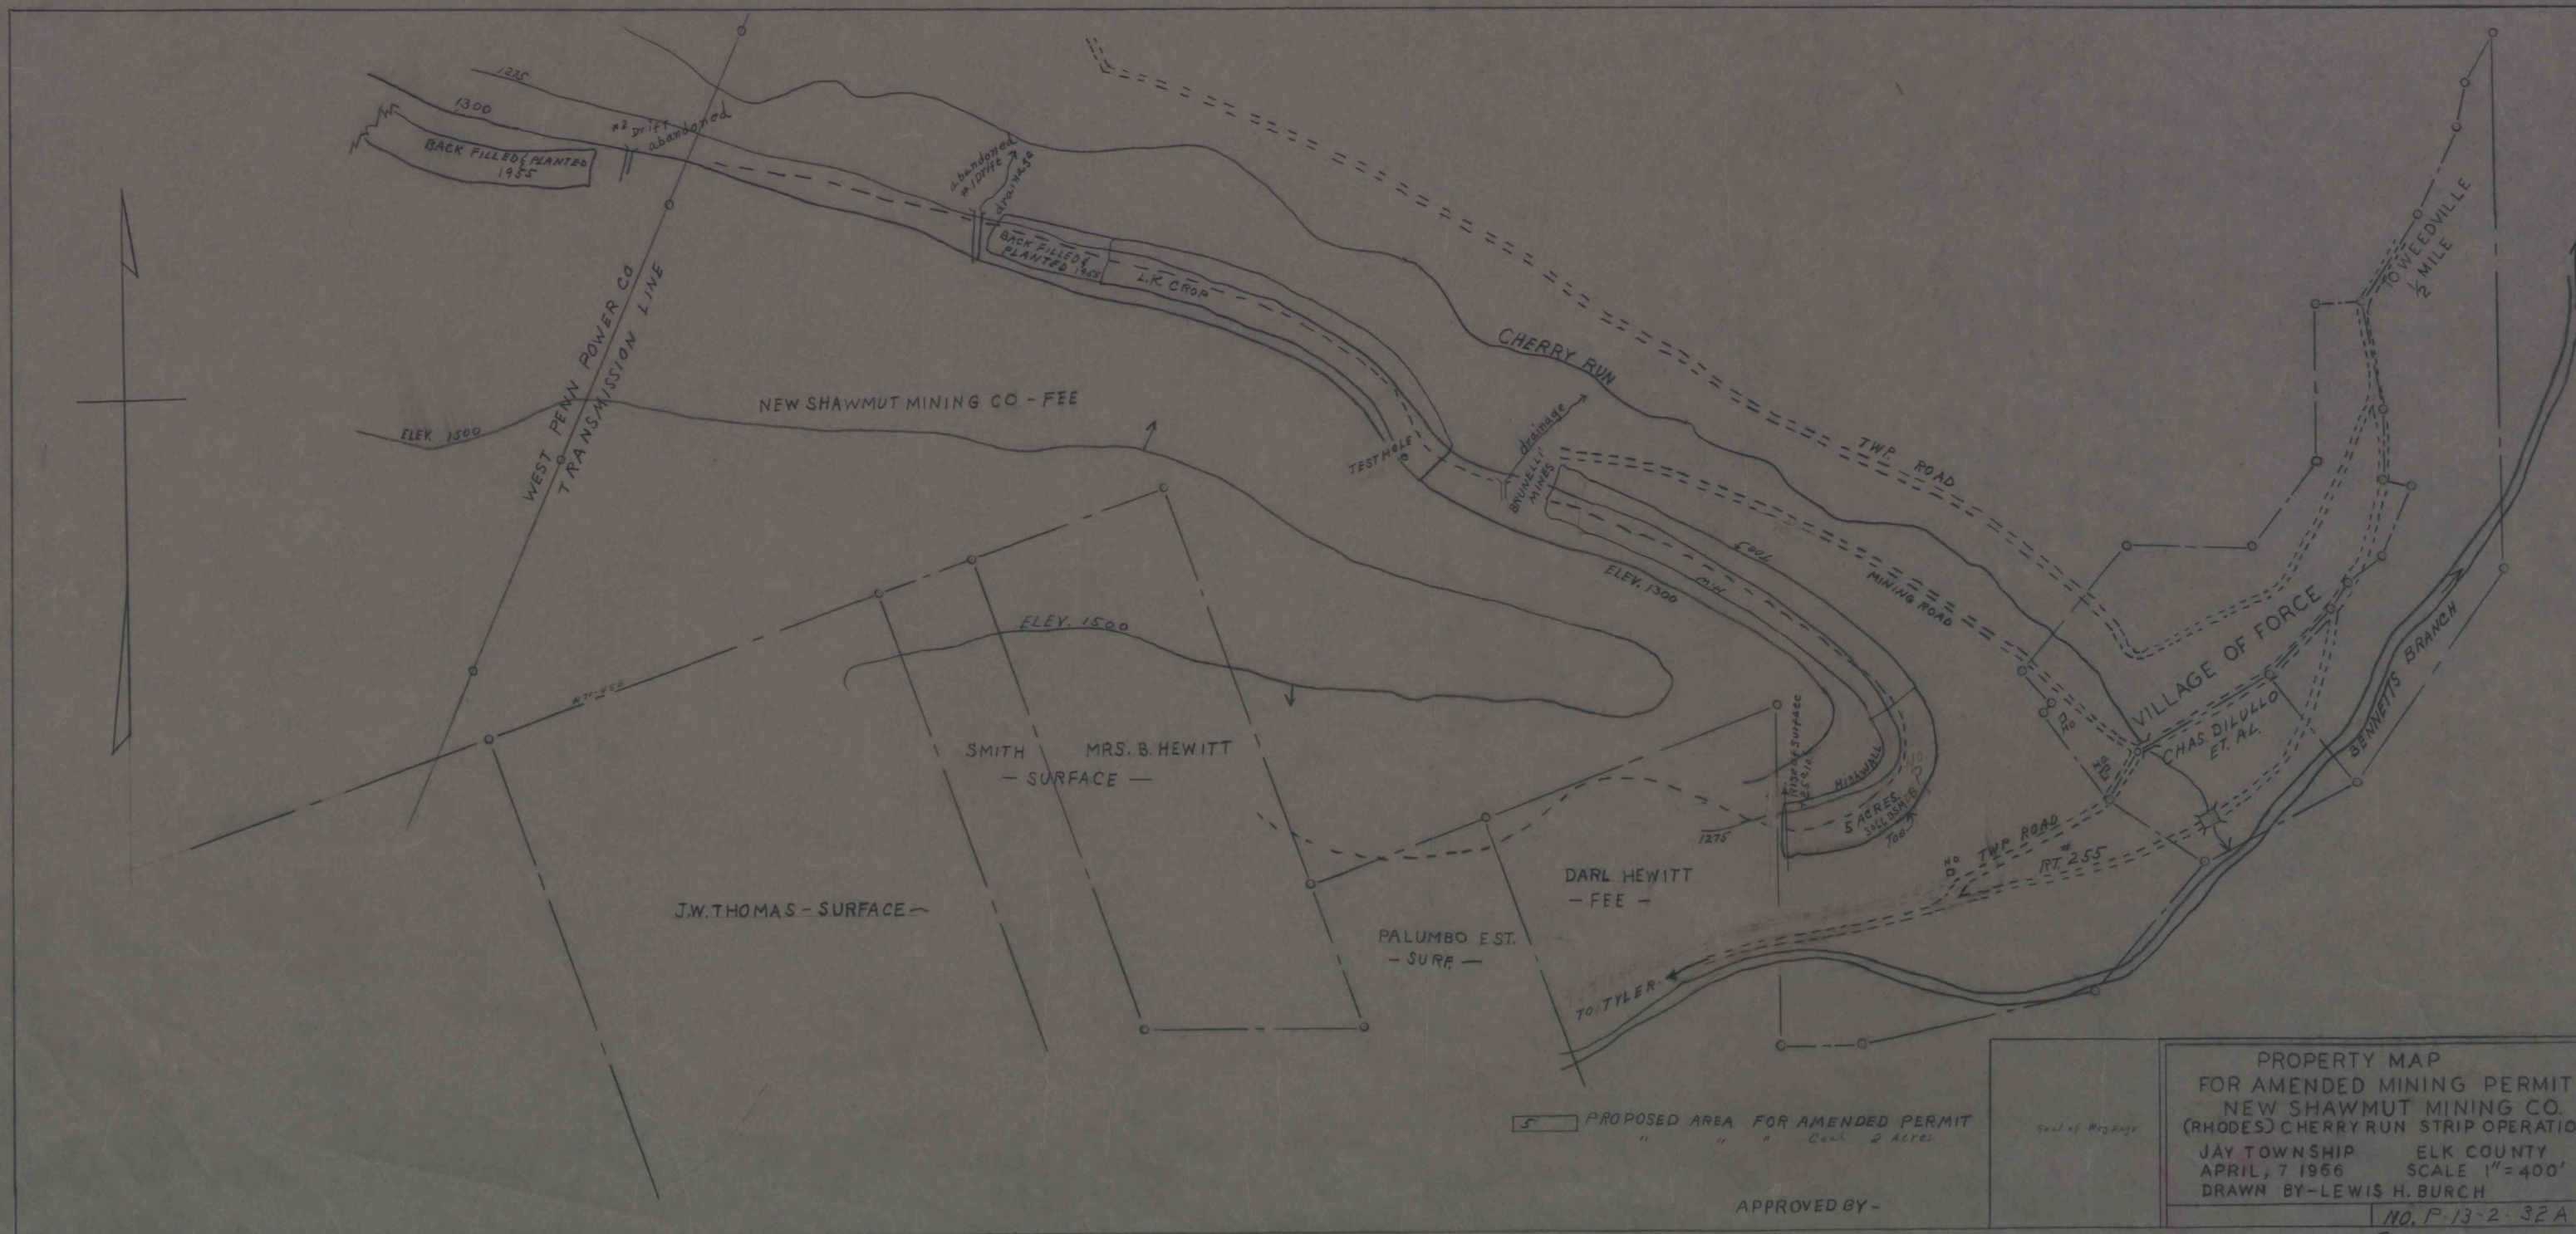

$$\begin{array}{r} \text{Crs 25'10" = 905.07} \\ 15.233 \\ \hline 76.9309 \end{array}$$

42.96
 208
 8452.08

NOTES of surface of 5 ACRE STRIP
 in Personal B. P. 6.
 (Base of surface)

Ed. Hays