


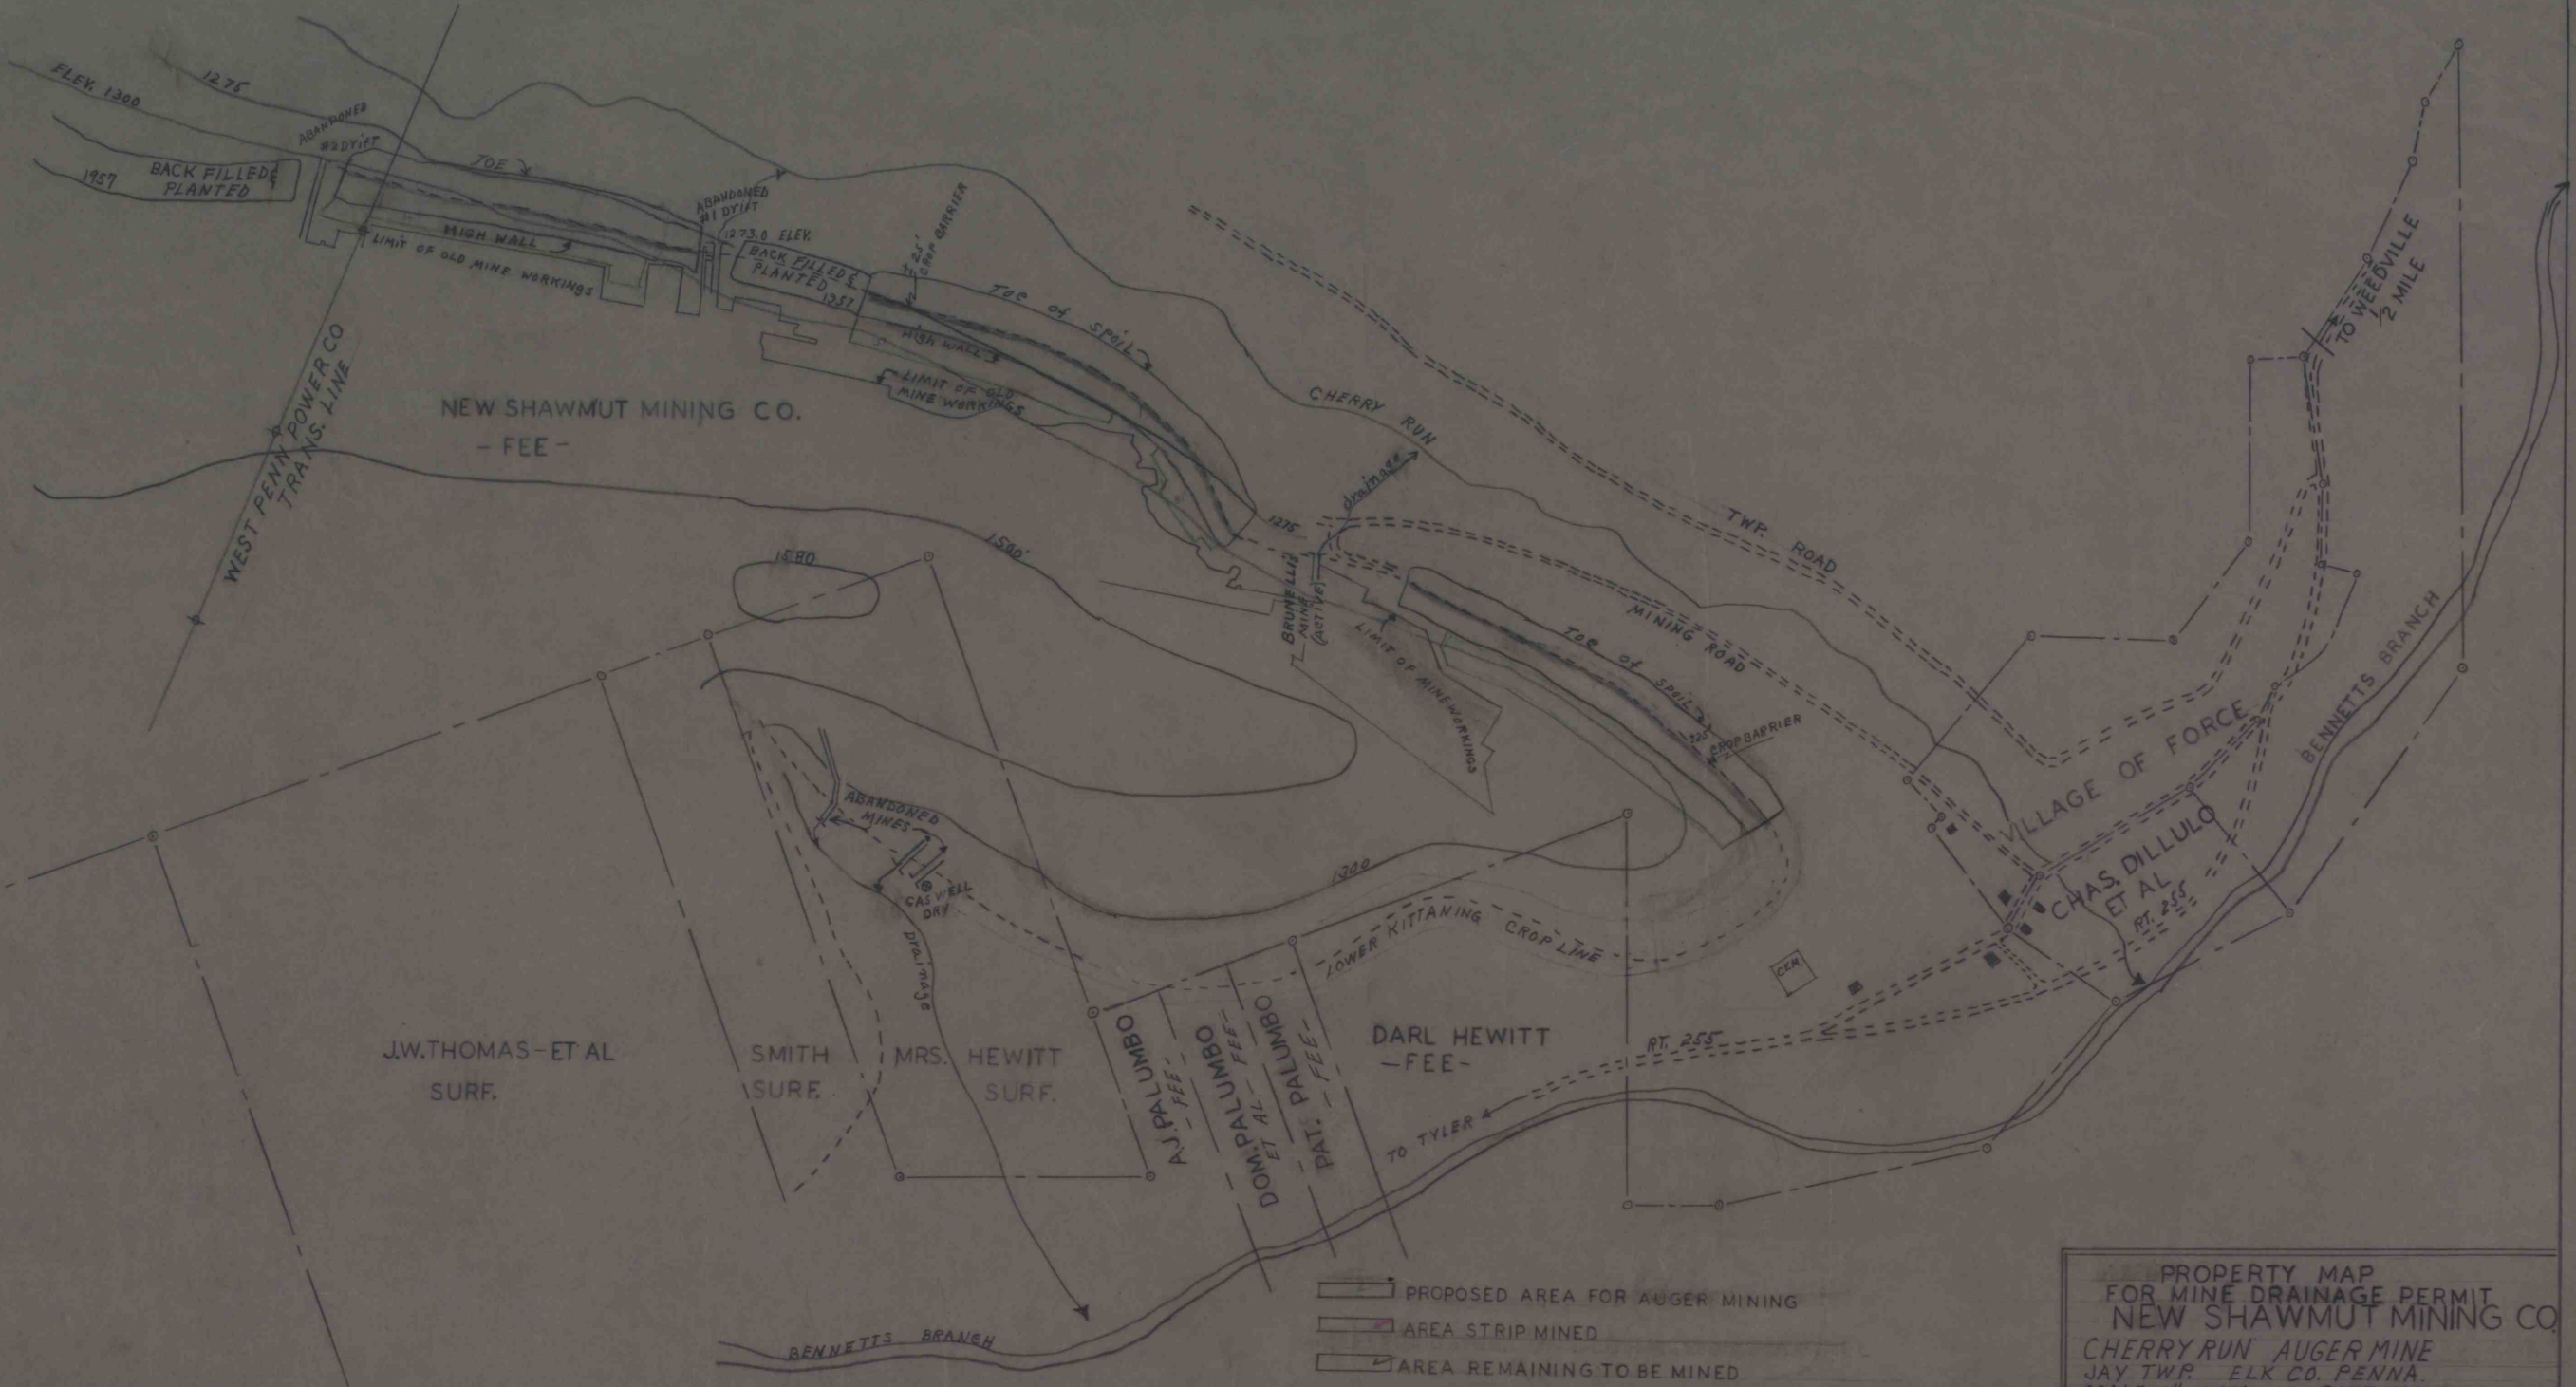

PROPERTY MAP
FOR MINE DRAINAGE PERMIT
NEW SHAWMUT MINING CO.
CHERRY RUN AUGER MINE
JAY TWP. ELK CO. PENNA.
SCALE 1" = 400' DATE MAY 27 1966
DRAWN BY J.H. BURCH No. P 13-2-33A-1
IMAPS 1645a

Location of
Hewitt, modern
Shawmut
D. Adams
G. Kunkin
B. Palumbo
Belle Hewitt

additions
1. crop domain
2. area to be mined
3. area stopped
map No. 37

stopping = 205 acres
augering = 185 acres
total = 39 acres
Coal - 7.5 acres
15.5 acres Coal
stop & auger
auger area not to
be included in area
affected