


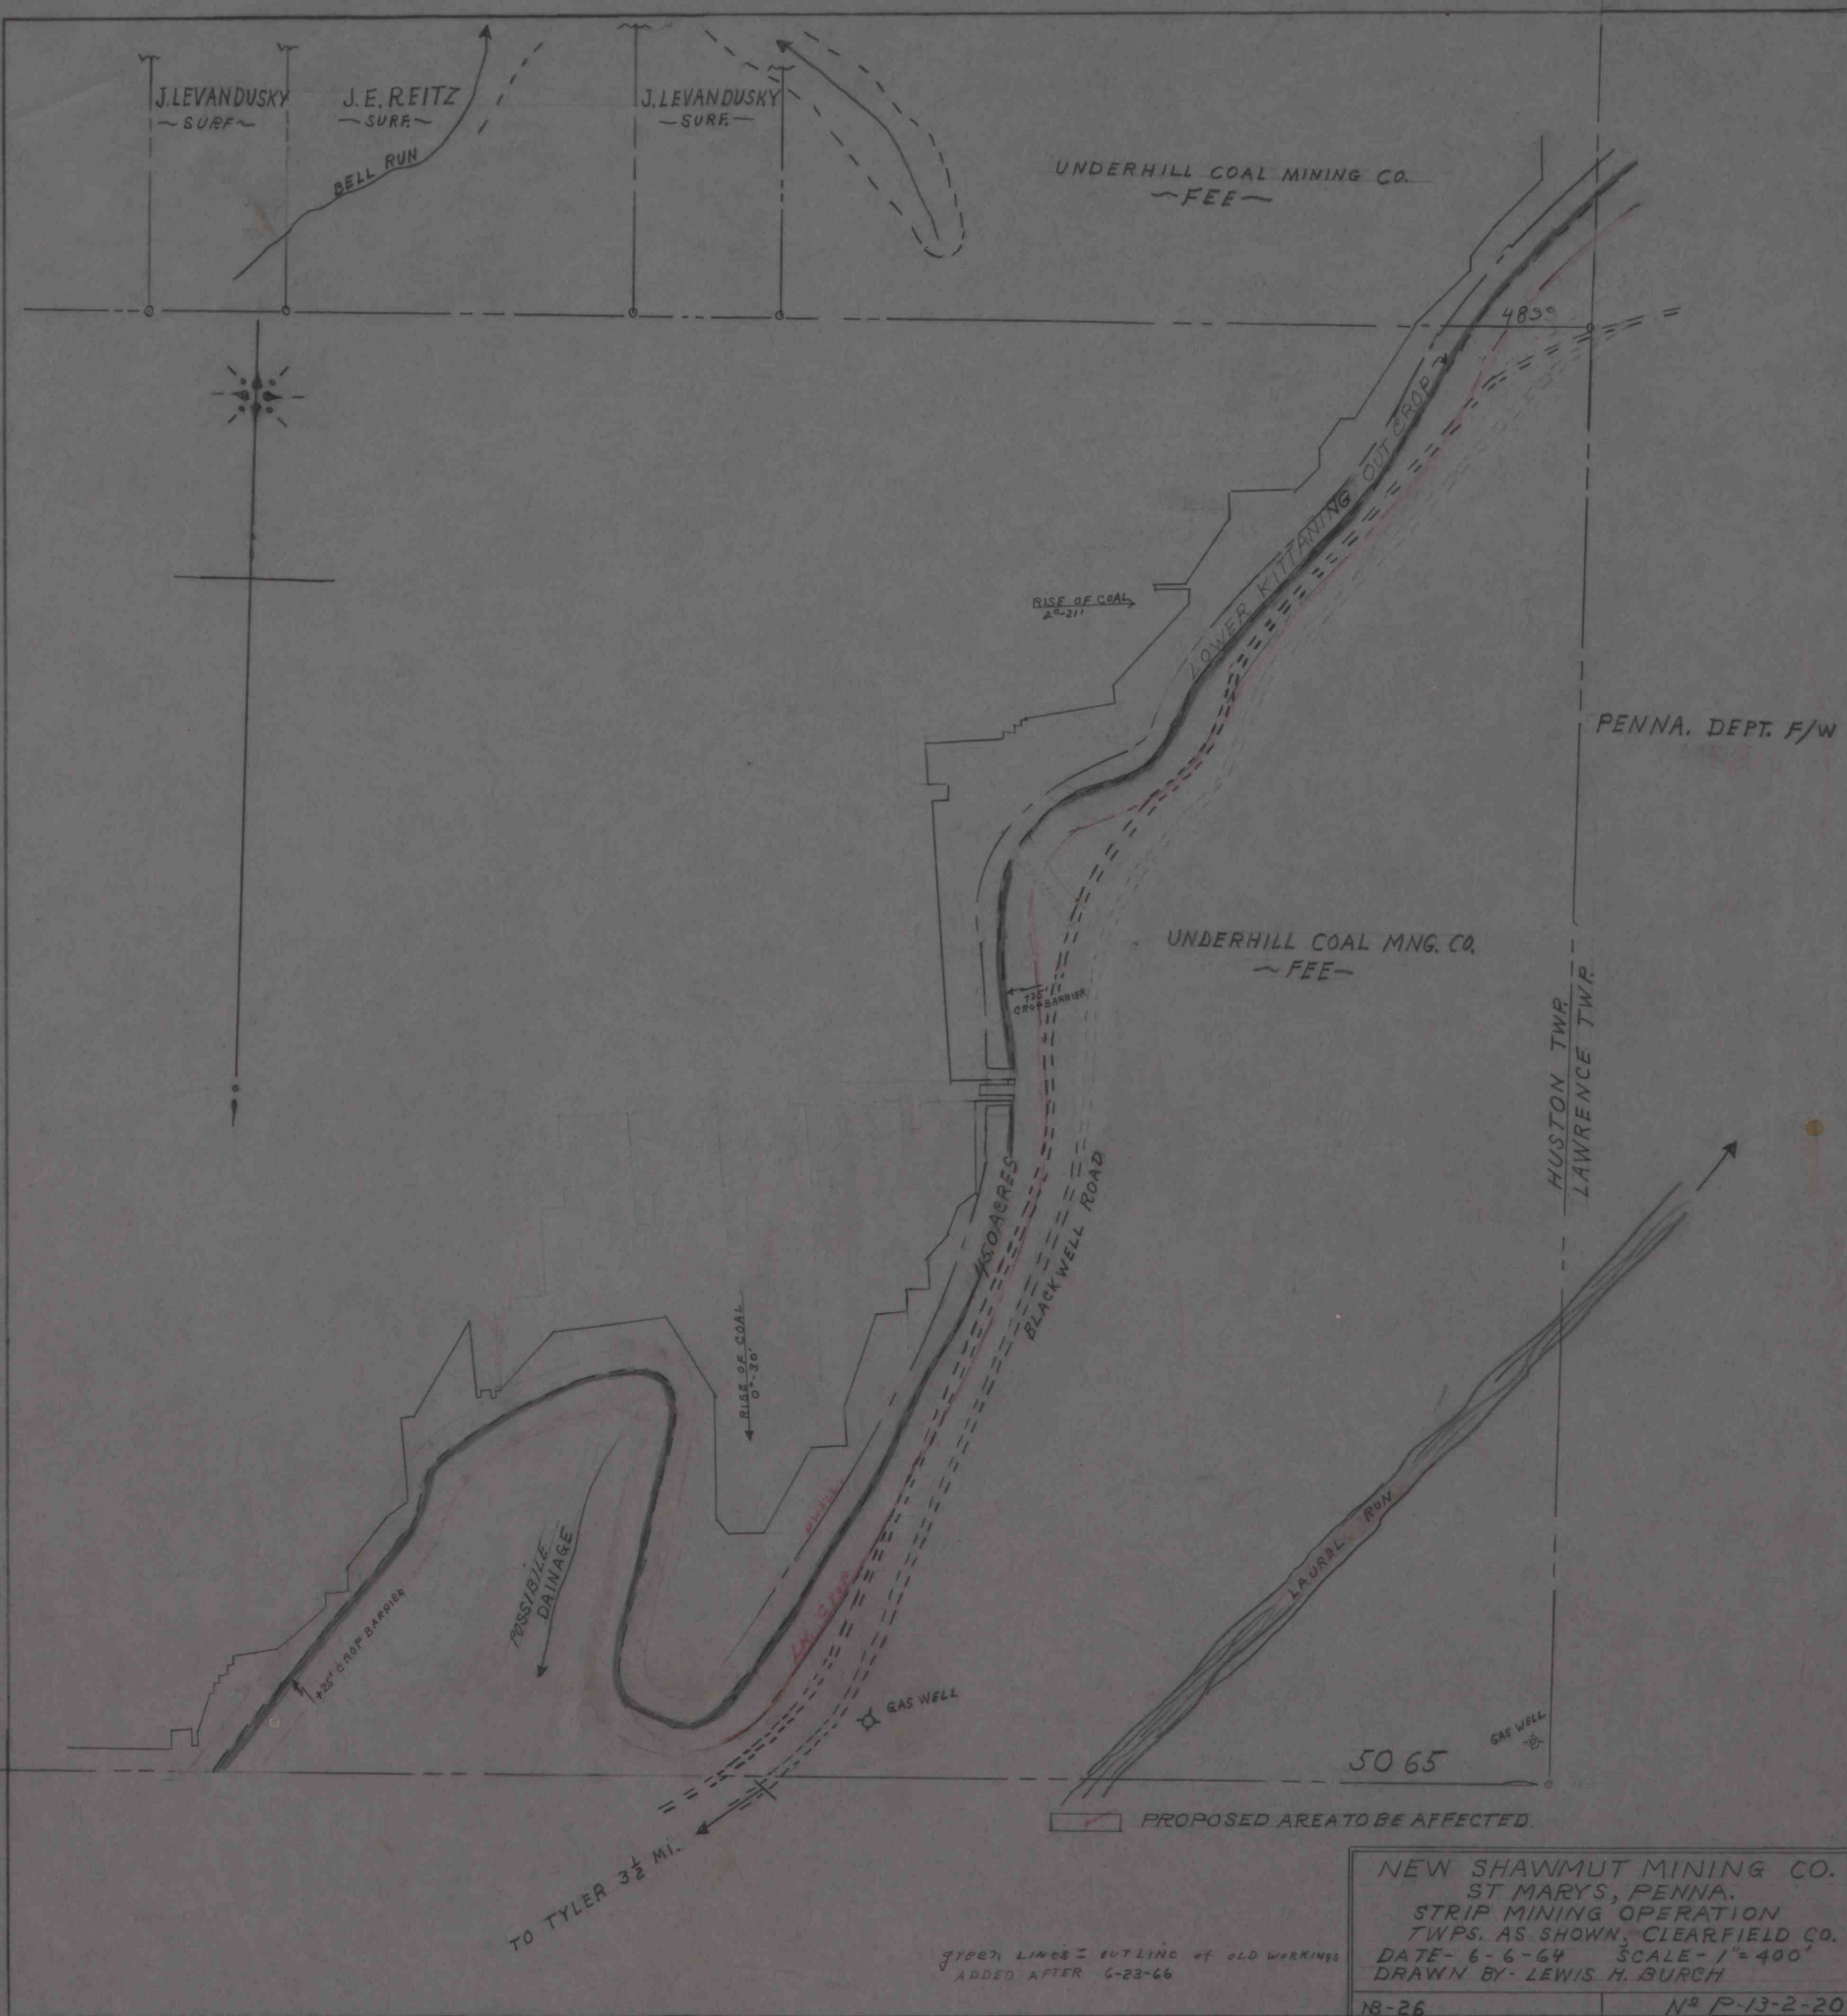

NEW SHAWMUT MINING CO.
ST. MARYS, PENNA.
STRIP MINING OPERATION
TWPS. AS SHOWN, CLEARFIELD CO.
DATE - 6-6-64 SCALE - 1"=400'
DRAWN BY - LEWIS H. BURCH

IMAPS# 16460