


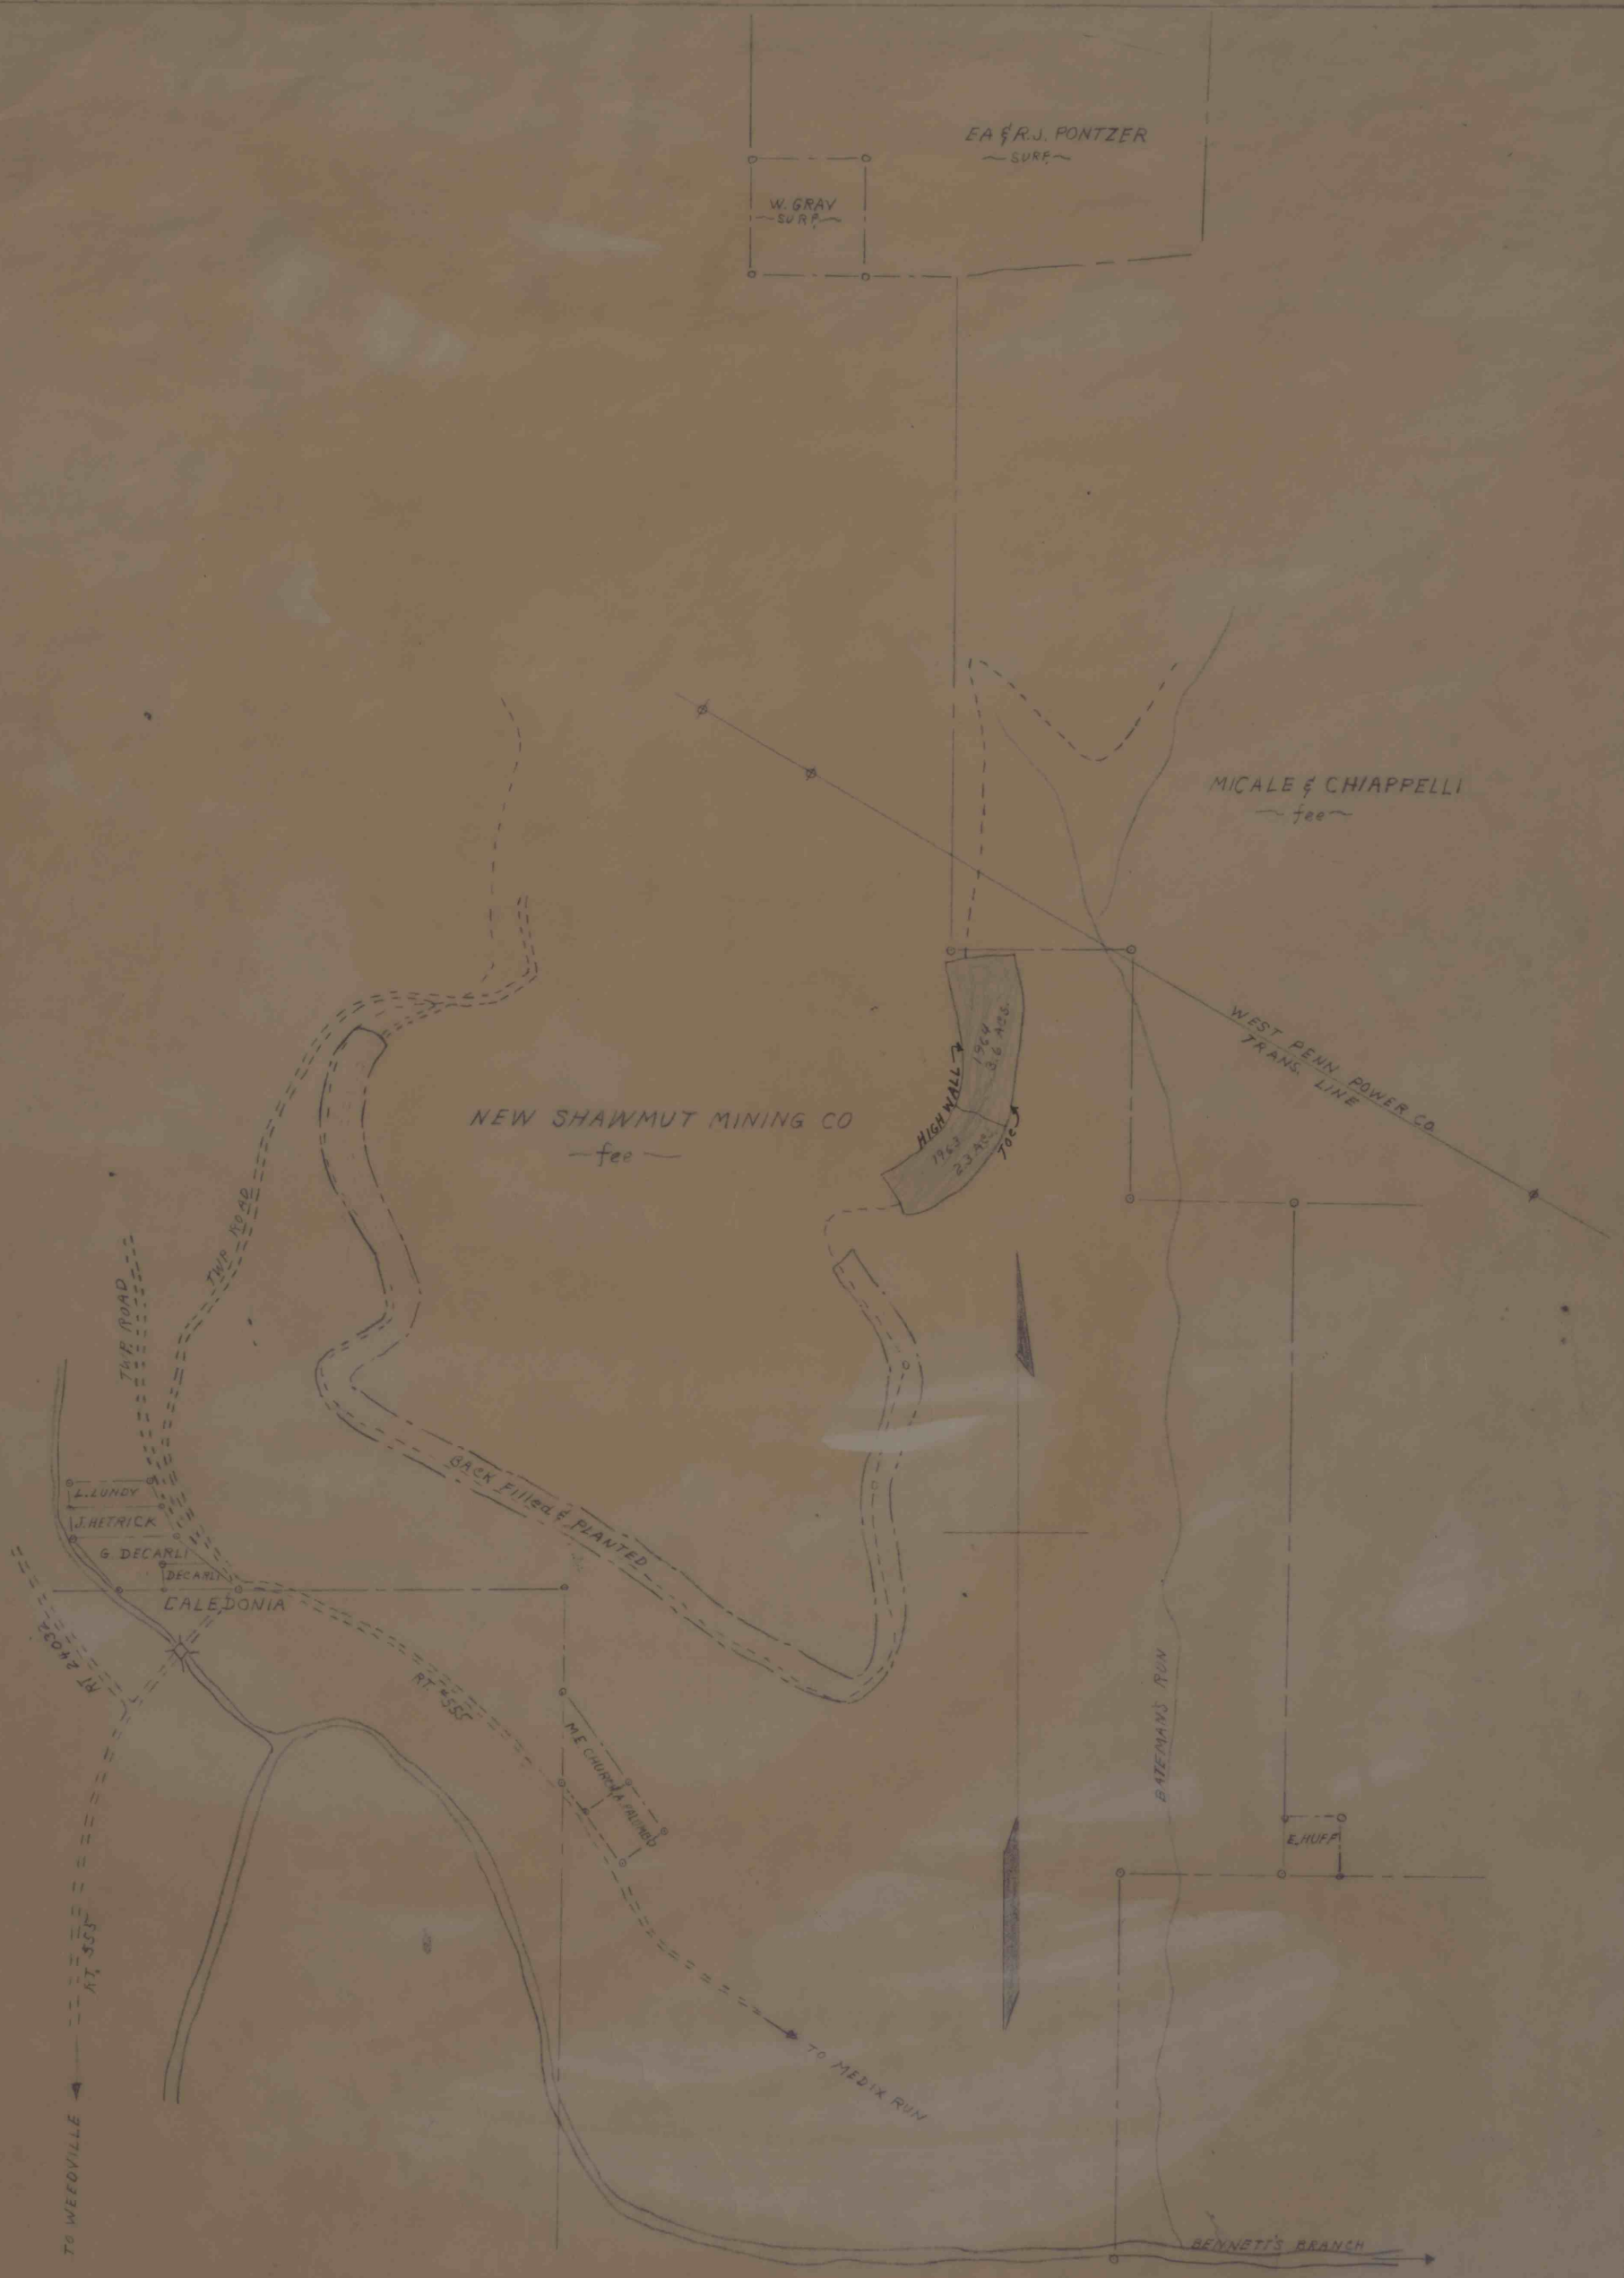

NEW SHAWMUT MINING CO.  
ST. MARYS, PENNA.  
STRIP MINING BACKFILL  
JAY TOWNSHIP ELK CO.  
DATE 12-15-64 SCALE 1" = 400'  
DRAWN BY - LEWIS H. BURCH  
NO. 10-28-PS-24 (NO. P13-2-23)

IMAPS#16461