


map made for strip planting for 1965-

8.1 ACRES disturbed by sugar mining

161
2583
25
121

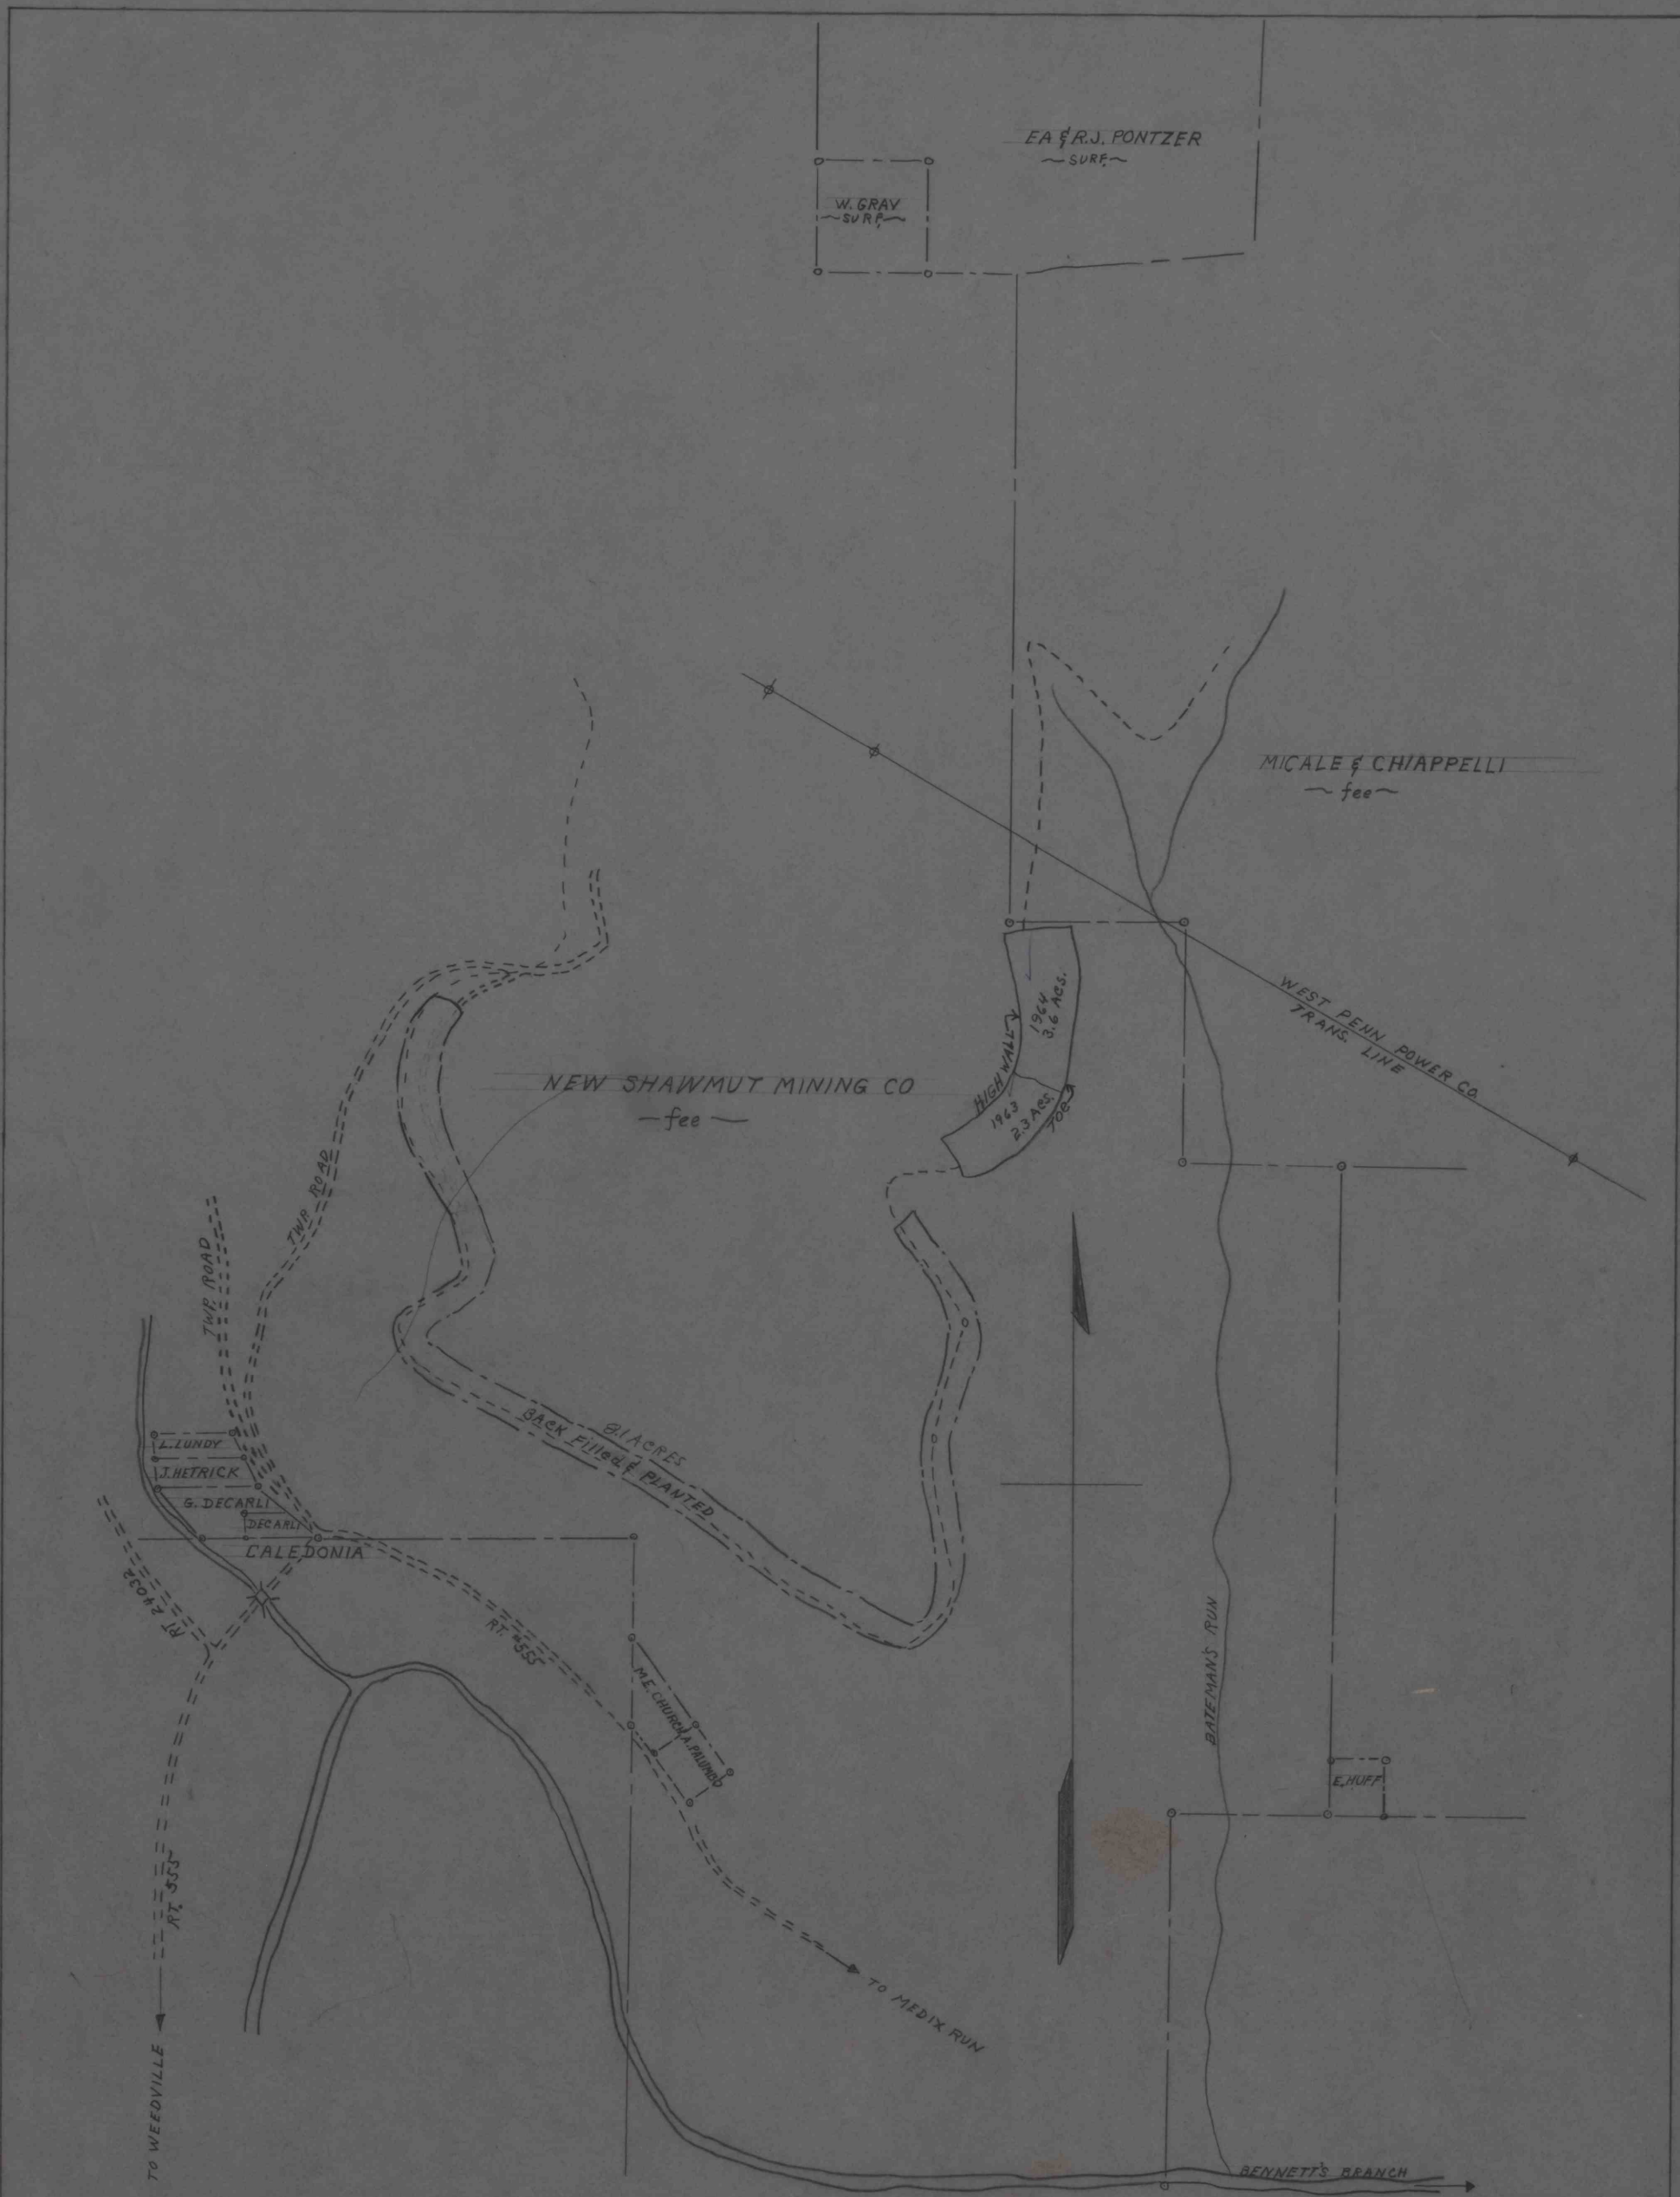

RESTORED - 9-24-64 -

NEW SHAWMUT MINING CO.
ST. MARYS, PENNA.
STRIP MINING BACKFILL
JAY TOWNSHIP ELK CO.
DATE 12-15-64 SCALE 1"=400'
DRAWN BY - LEWIS H. BURCH
NO. 26 PG. 26 NO. P13-2-23

IMAPS# 16472