


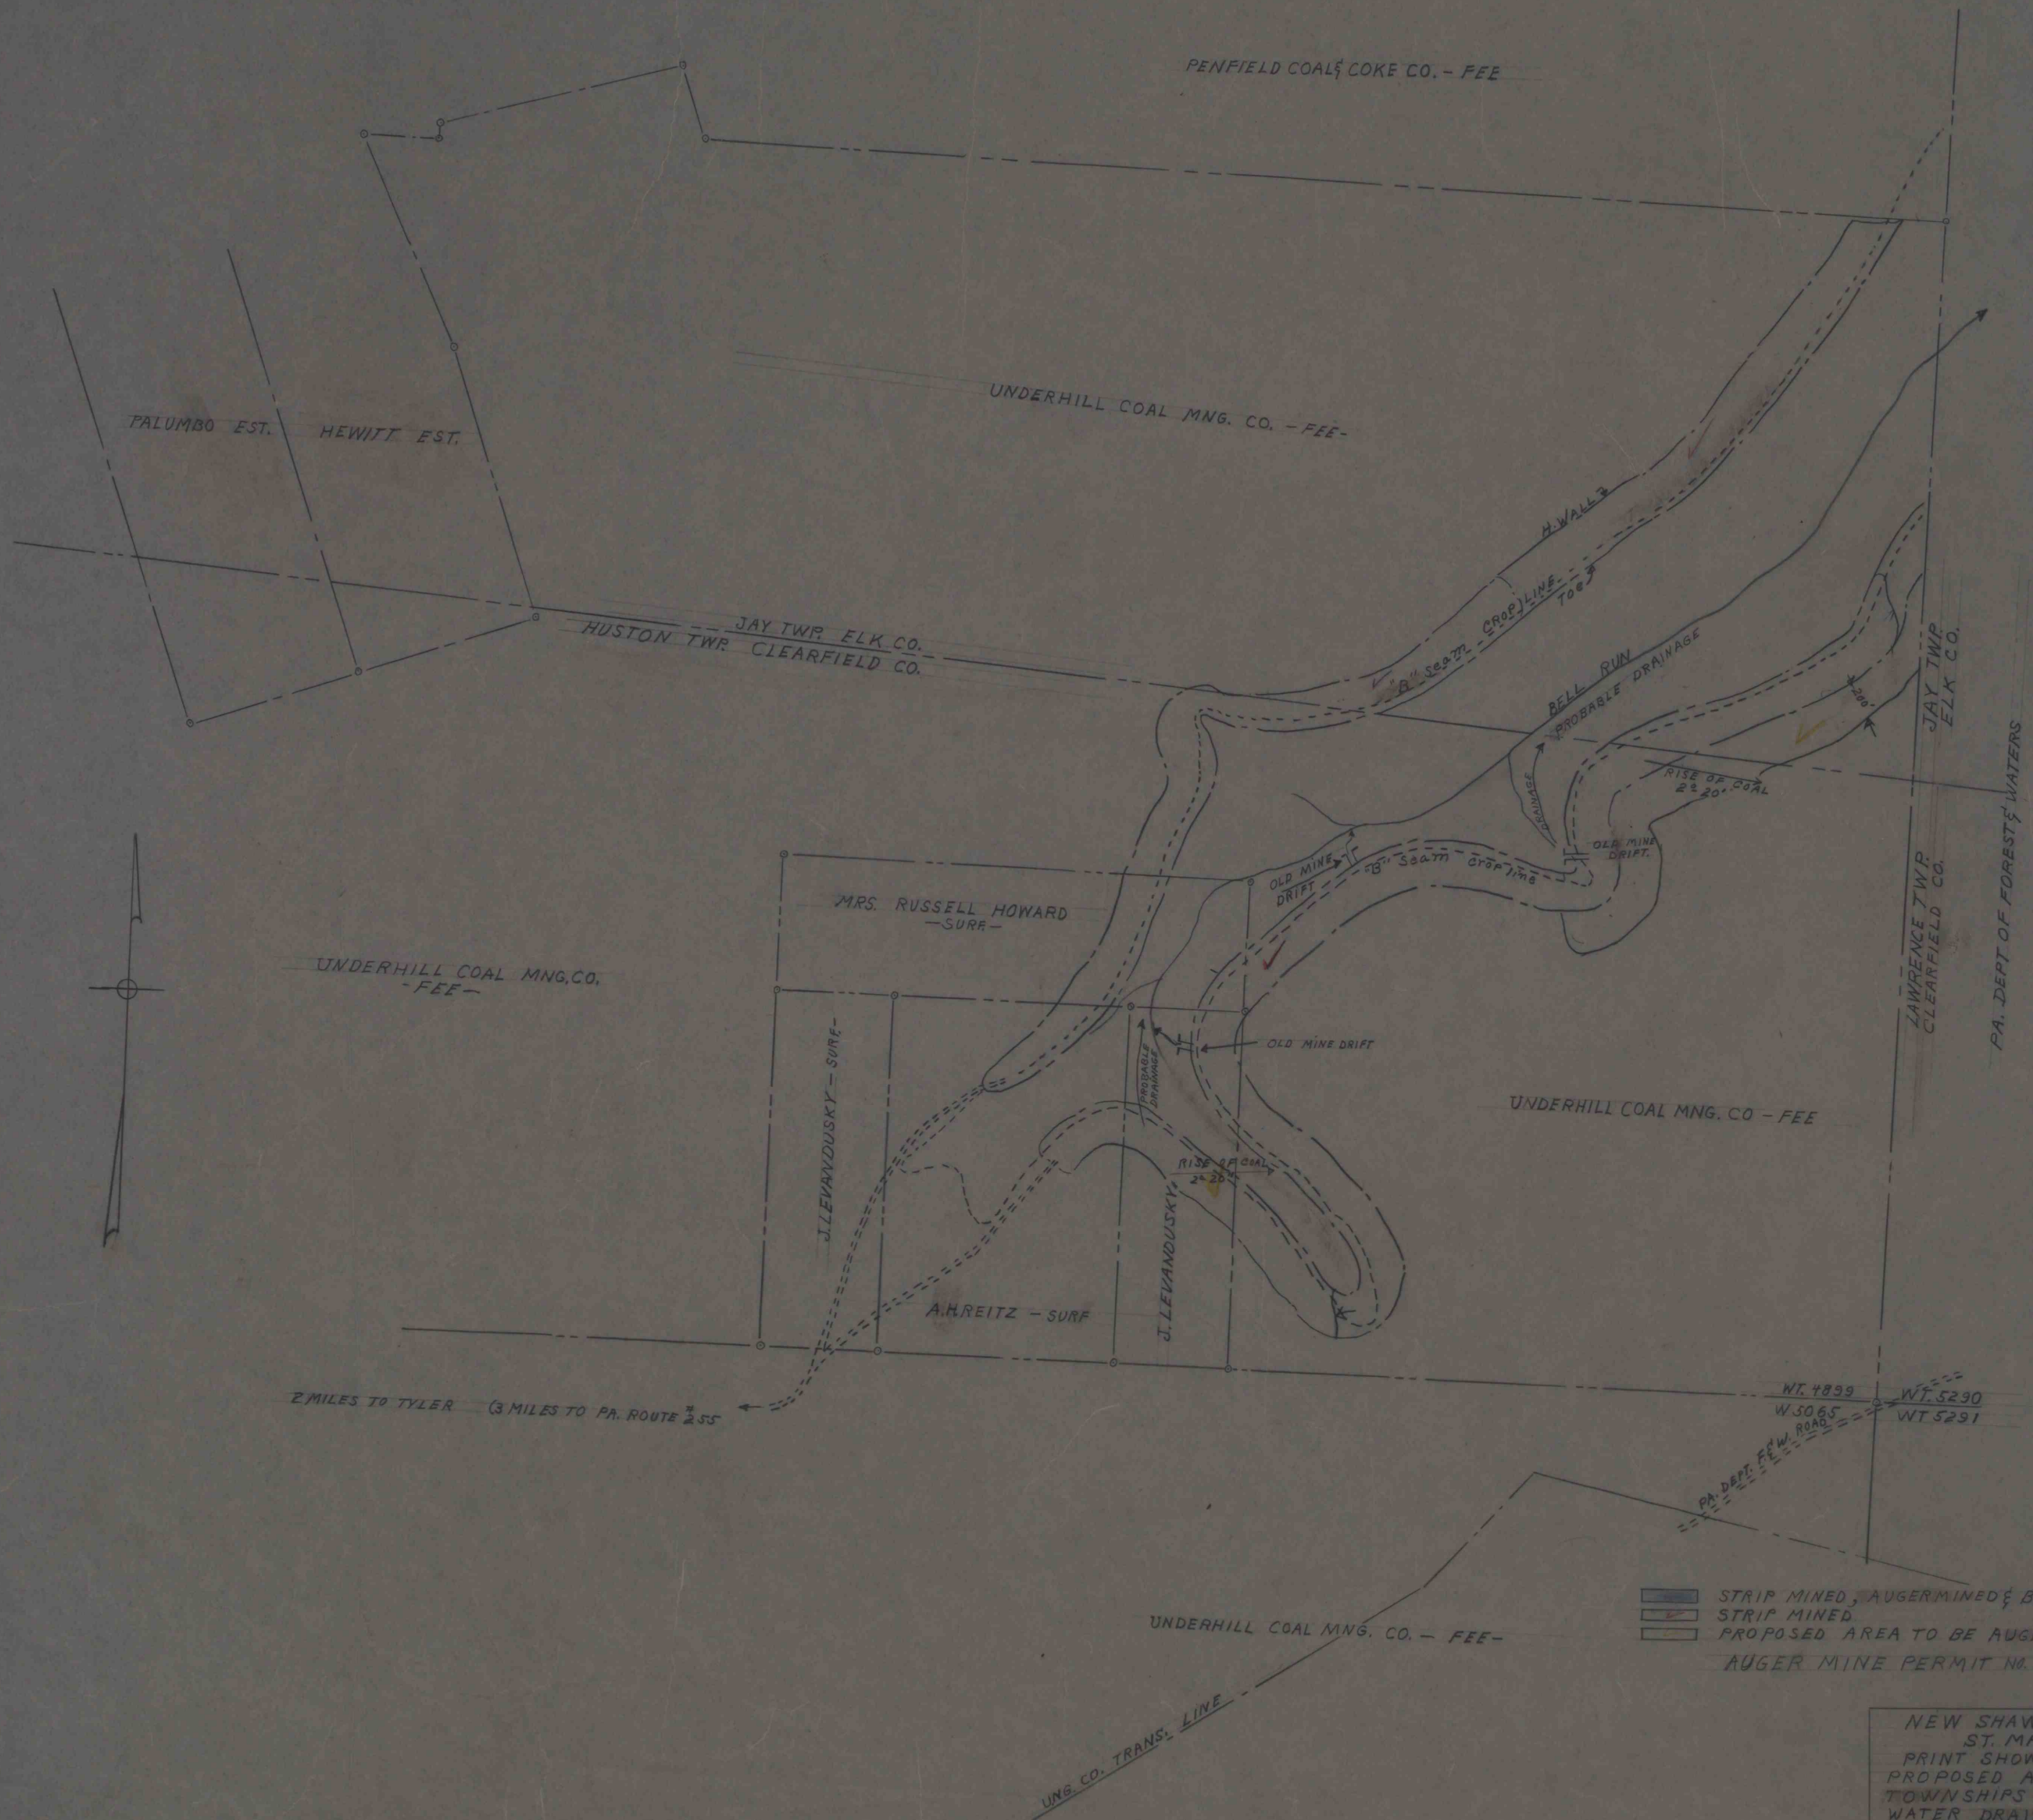

IMAPJ# 16475