


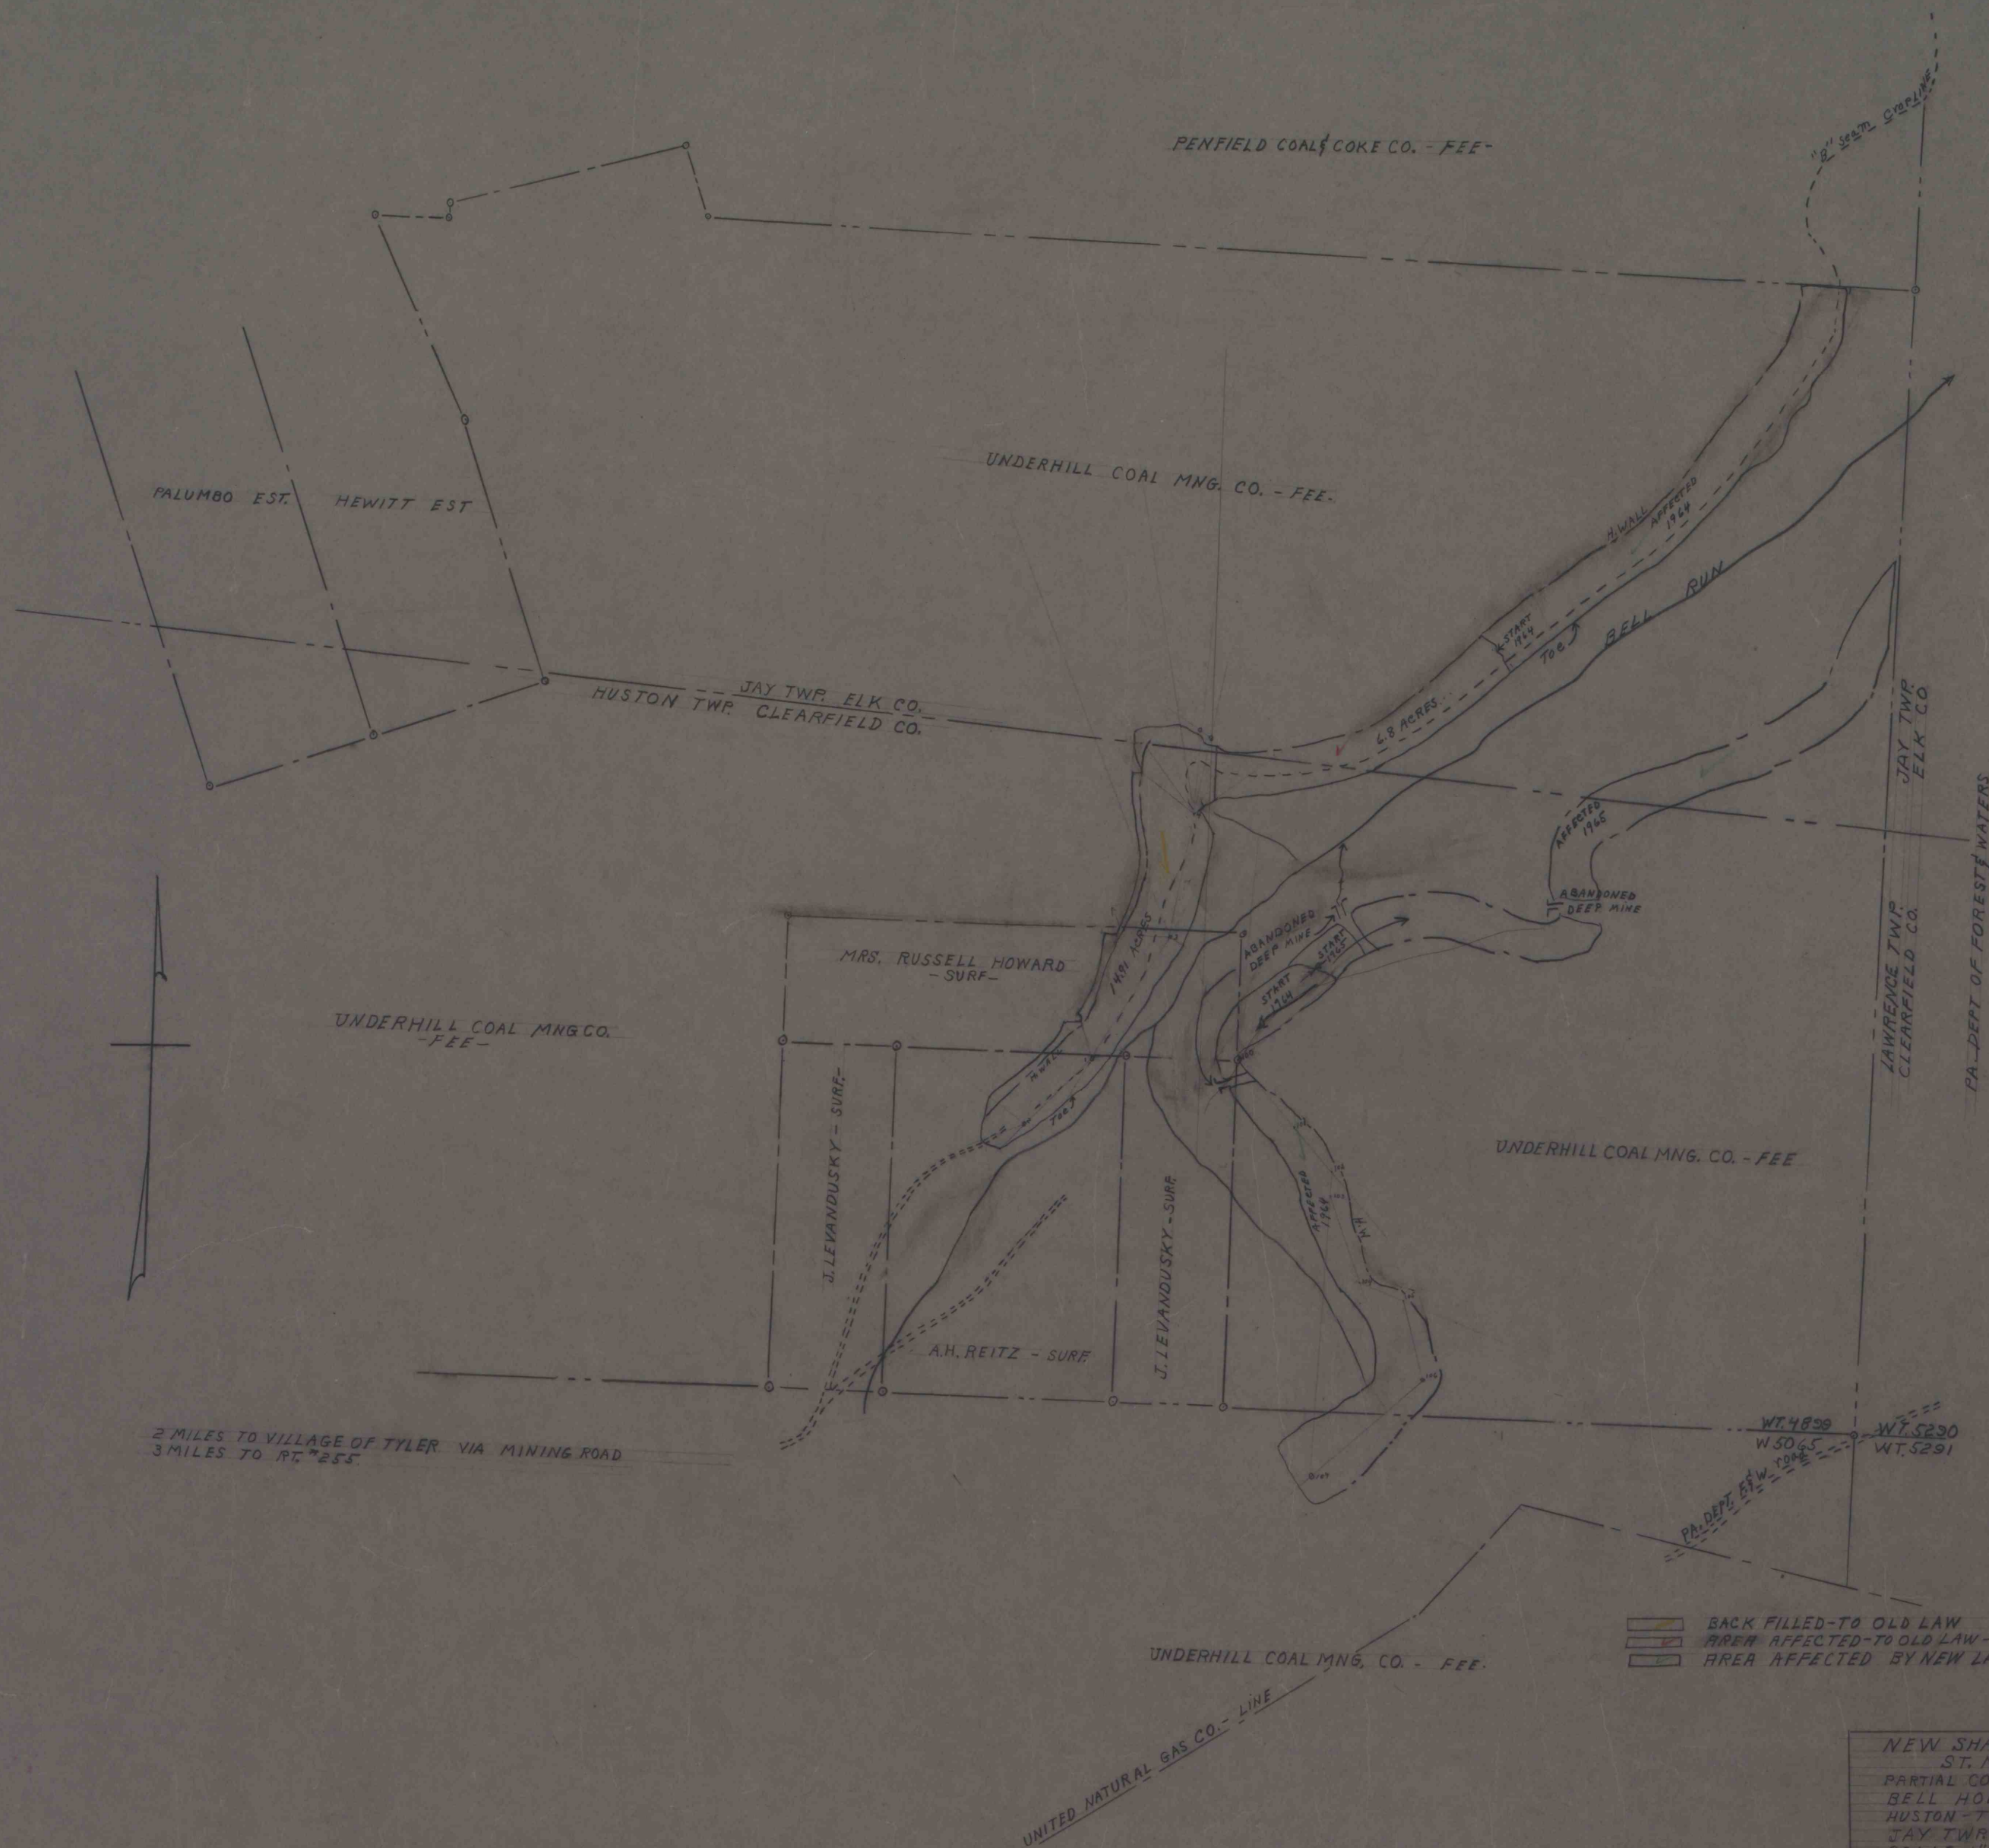

1963 - 7744 2170 m. 11/14/63
1964 " 25 " " "
1965 " 22 " " "
1966 " 21 " " "
1967 " 21 " " "

1964 APP. TUCK 25 ACRES APP.