


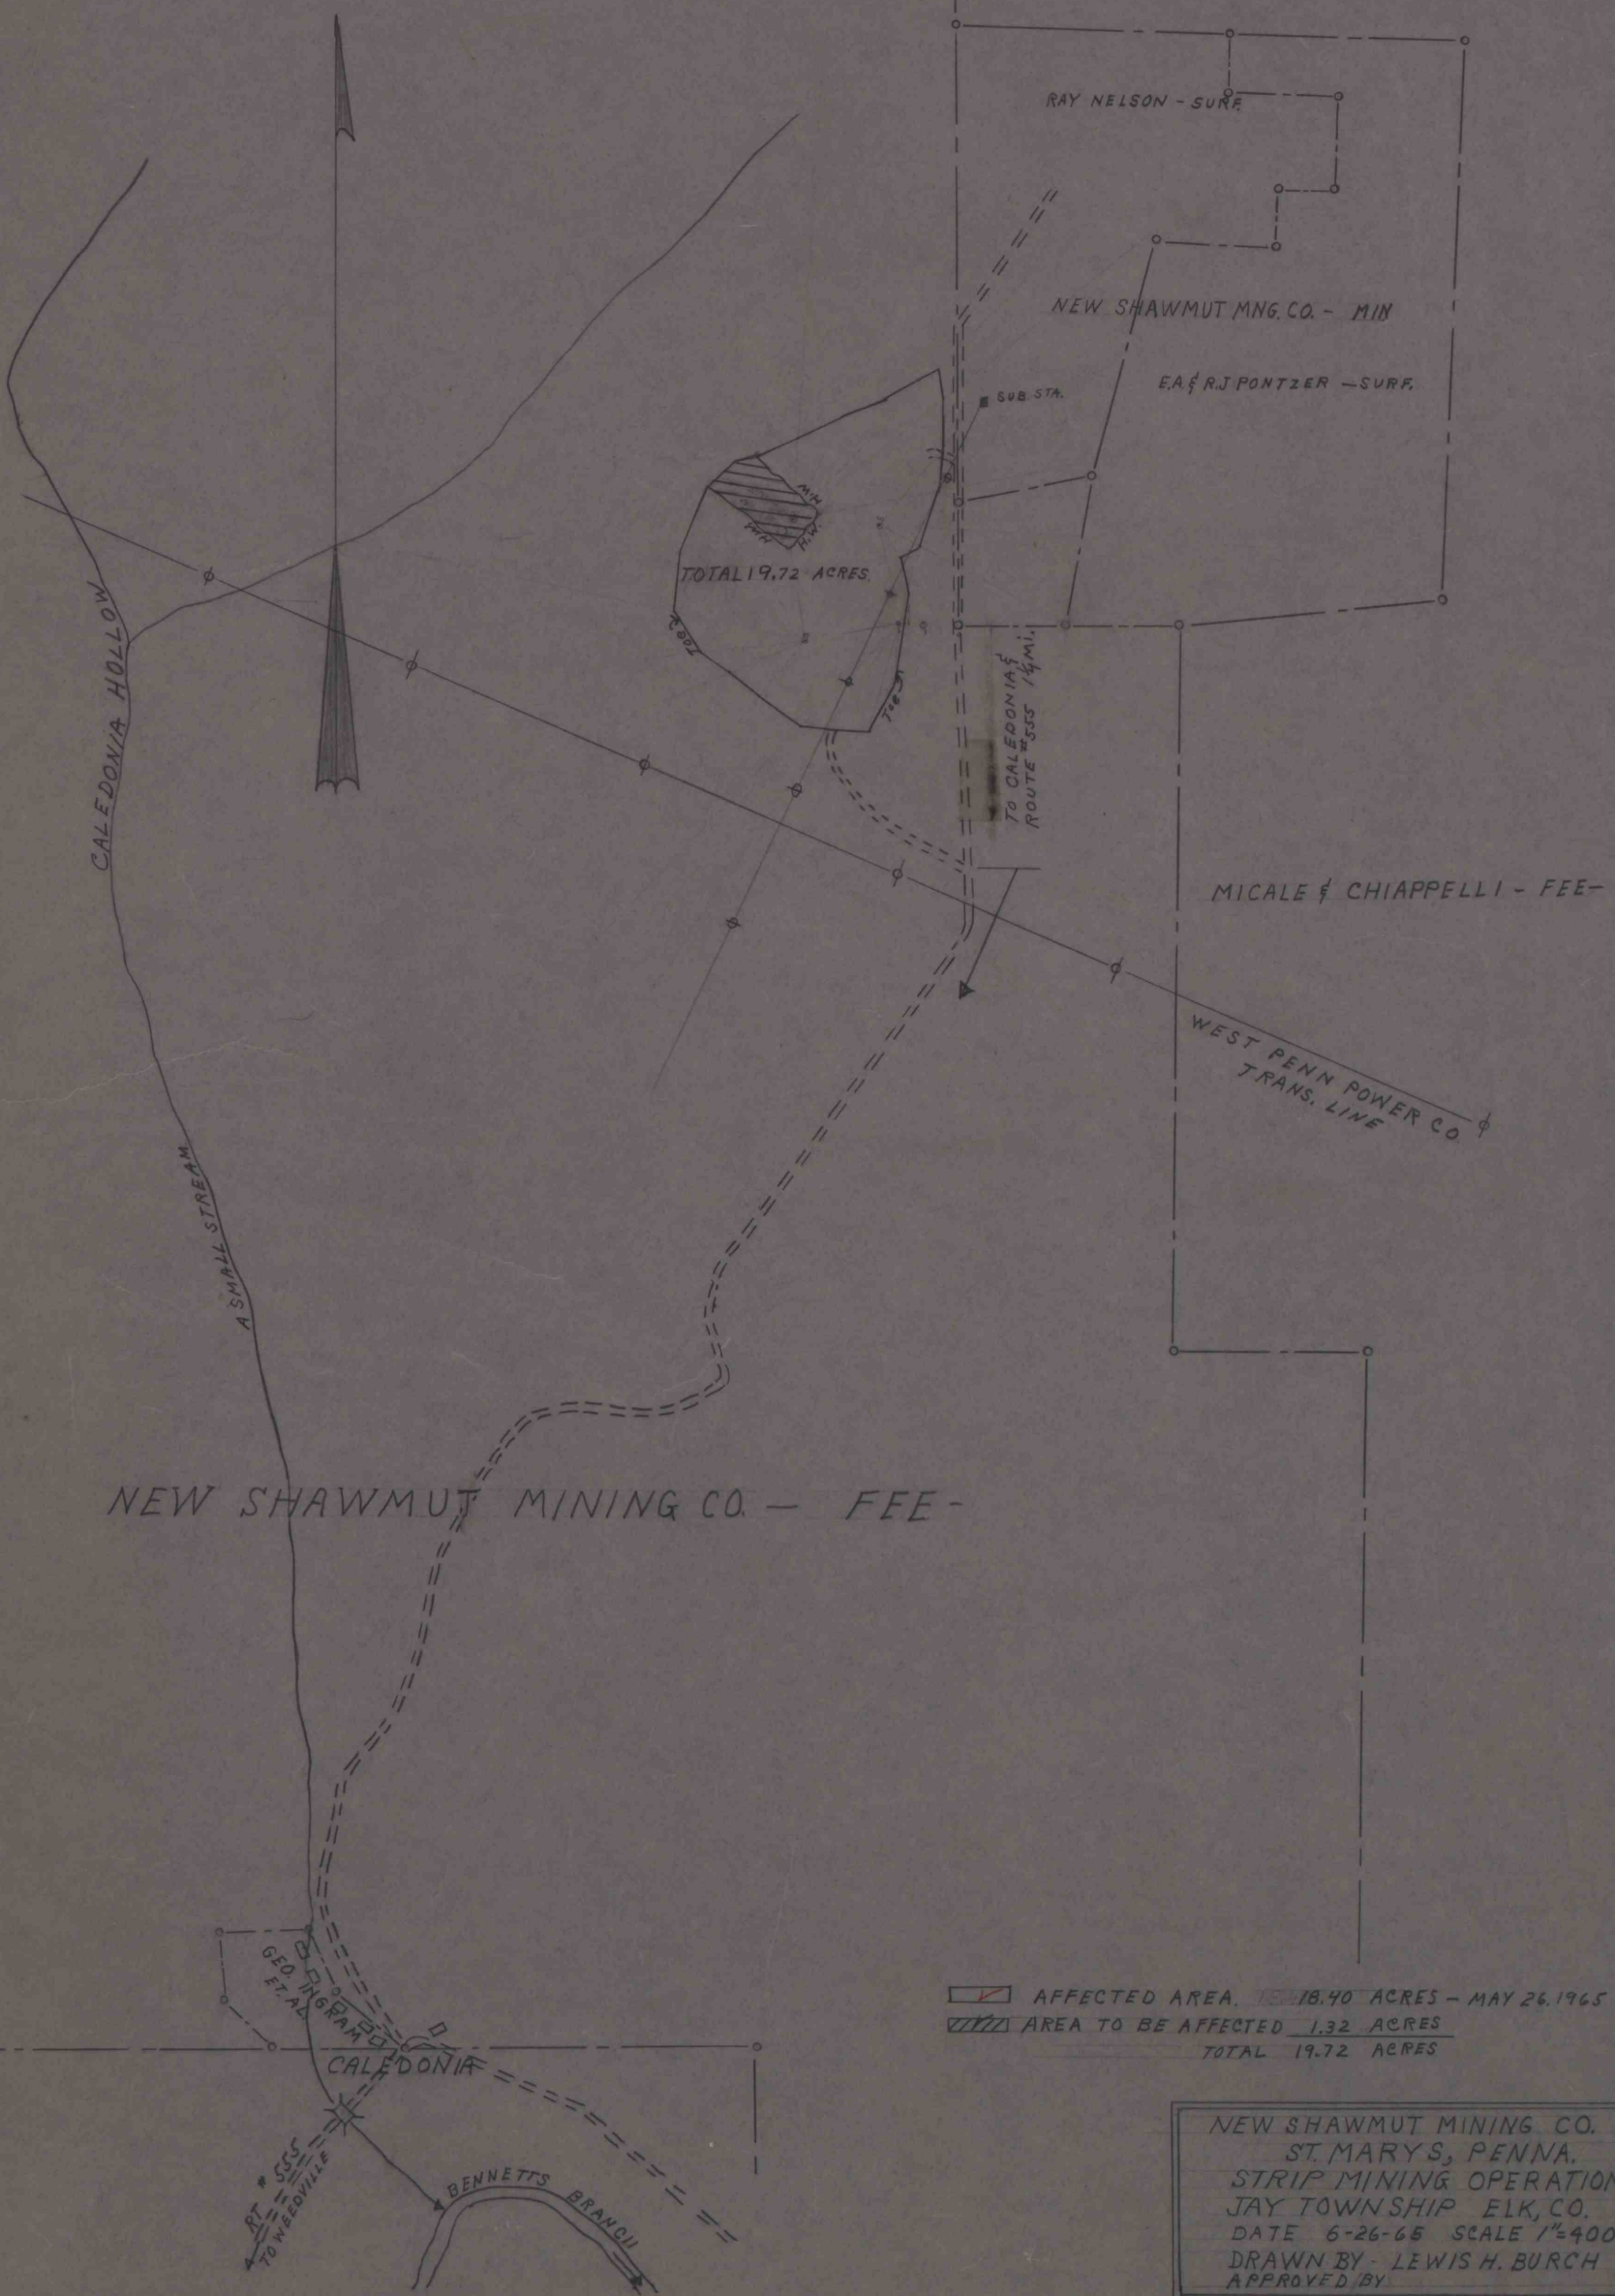

IMAPS #16482