


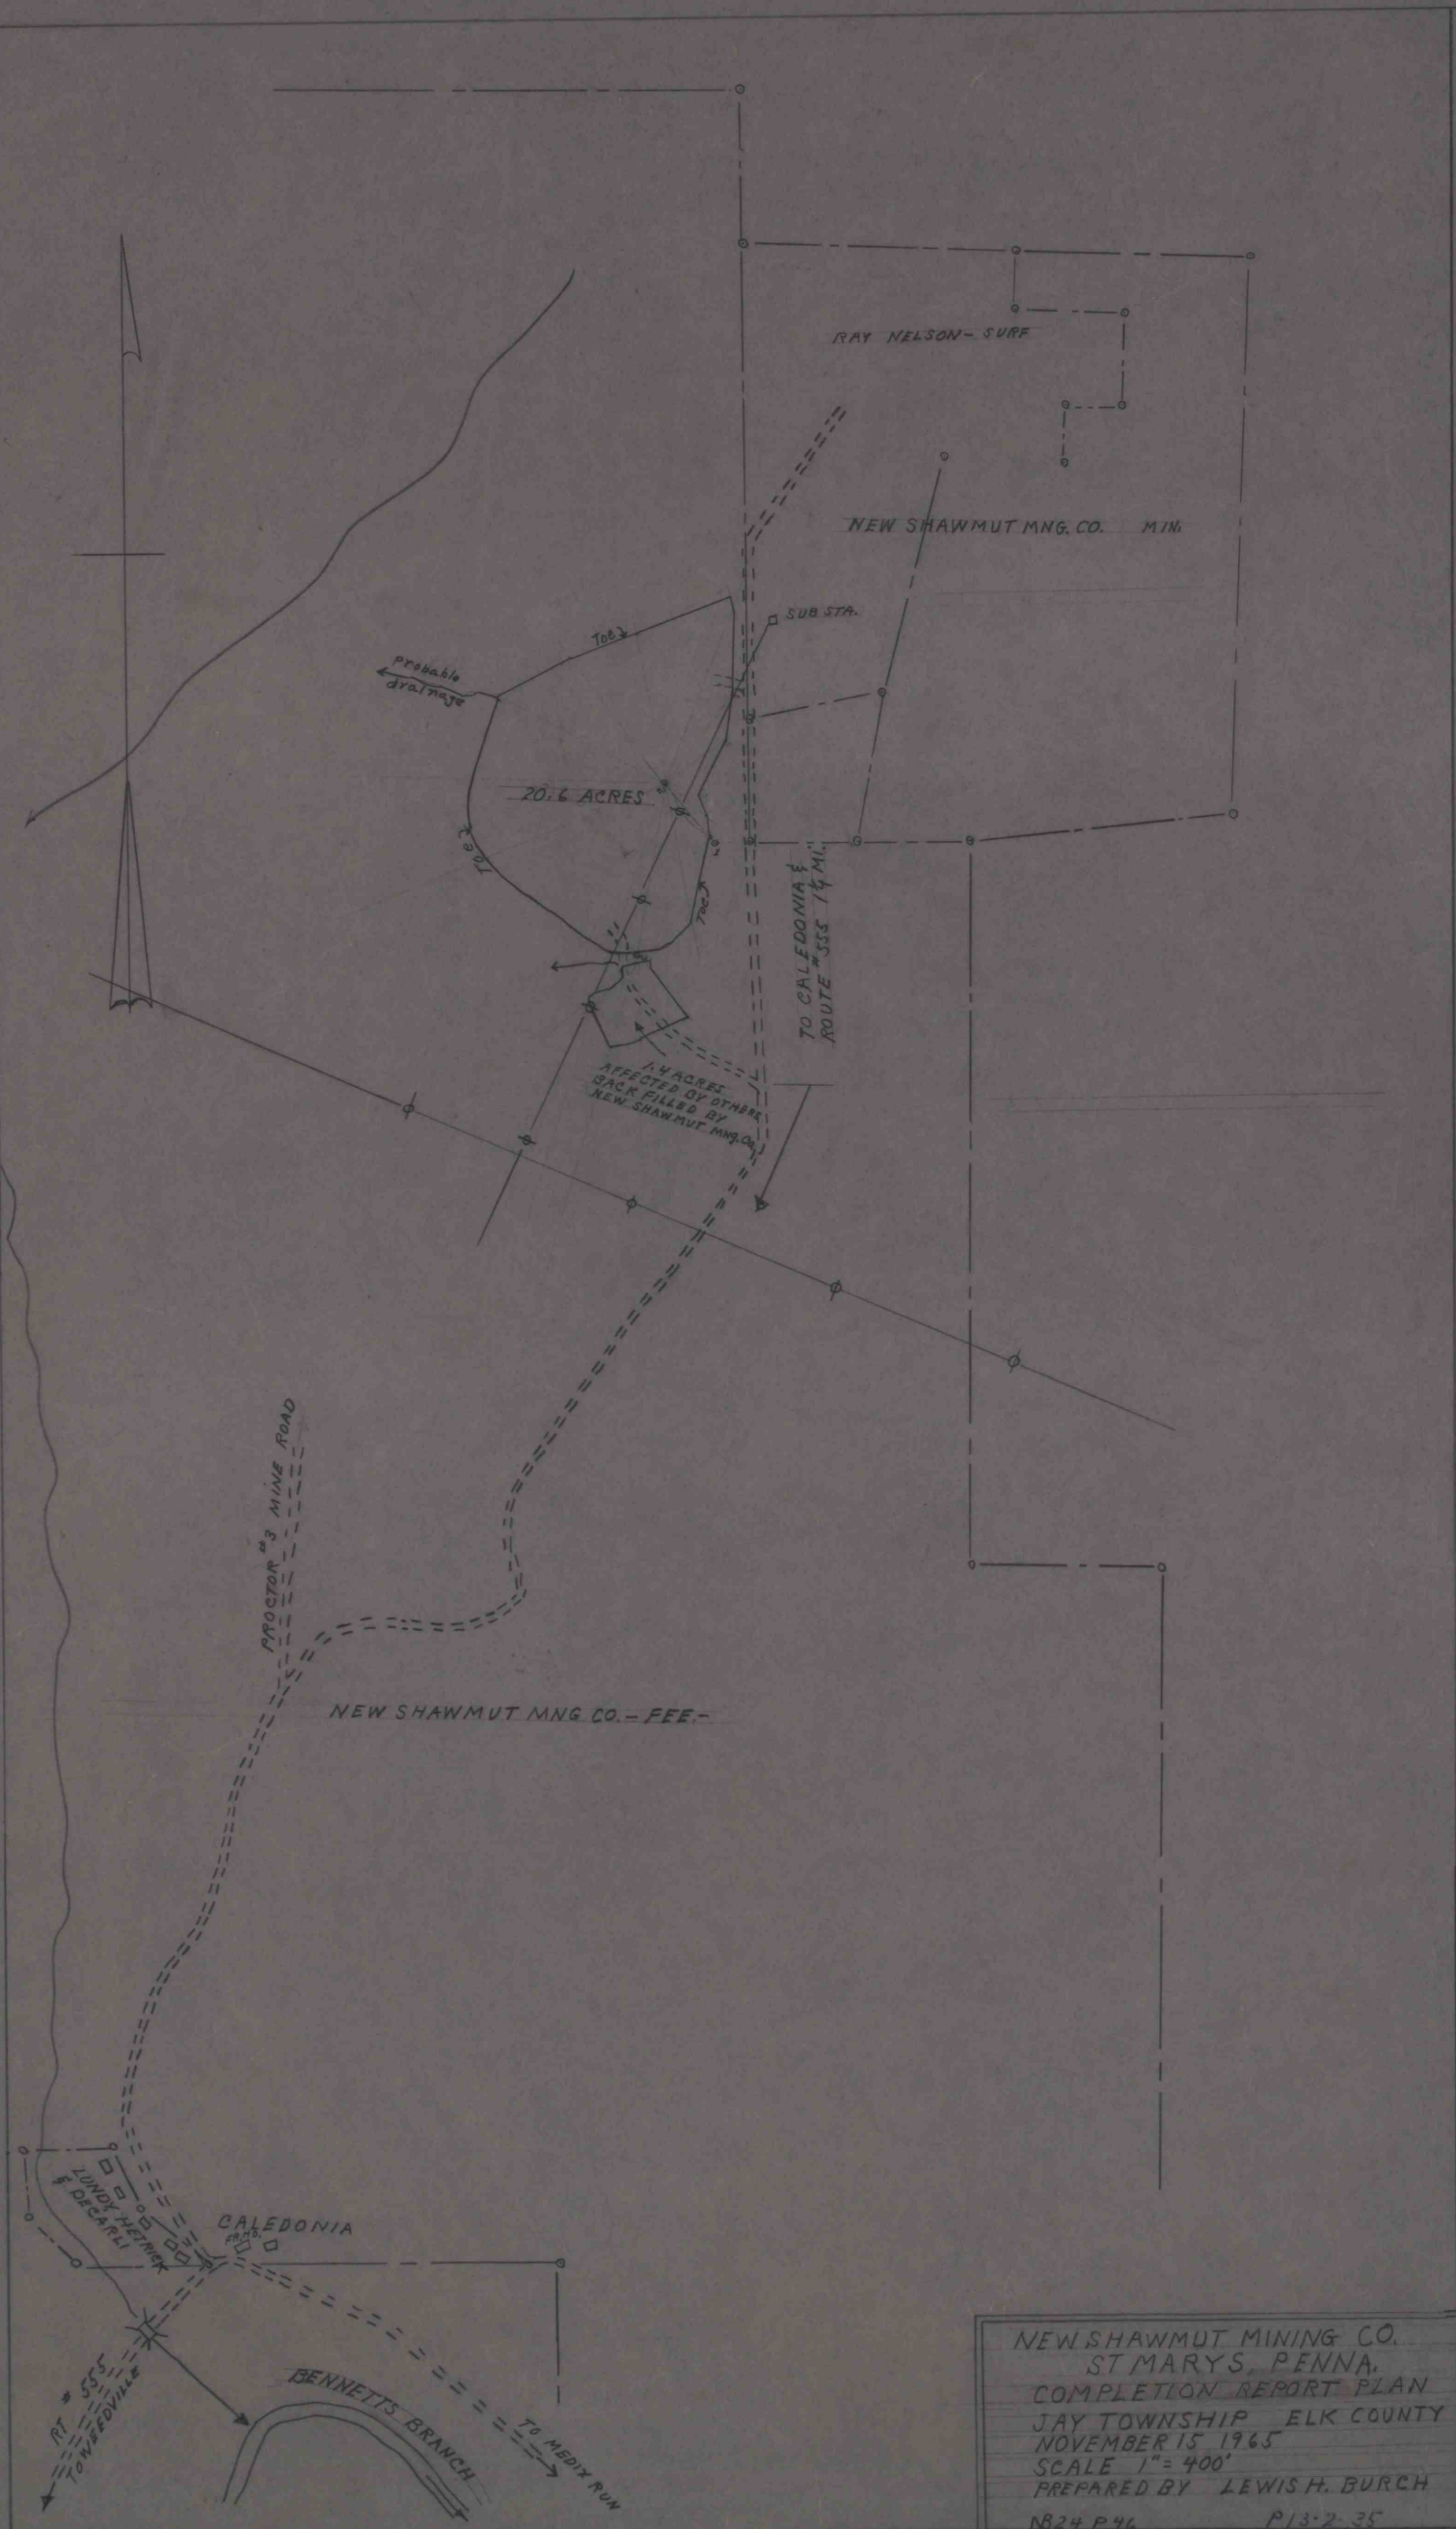

NEW SHAWMUT MINING CO.
 ST. MARYS, PENNA.
 COMPLETION REPORT PLAN
 JAY TOWNSHIP ELK COUNTY
 NOVEMBER 15, 1965
 SCALE 1" = 400'
 PREPARED BY LEWIS H. BURCH
 NB24 P46 P13-2-35

IMAPS #16483