


4.69 acre original
 changed to 6.5
 Acres as per J. URMANN
 Request.
 See other MAP PREPARED.

29.15 of Gov
 15.50 of Minerals
 4.69 acre
 36.25 acres
 17.00 acres

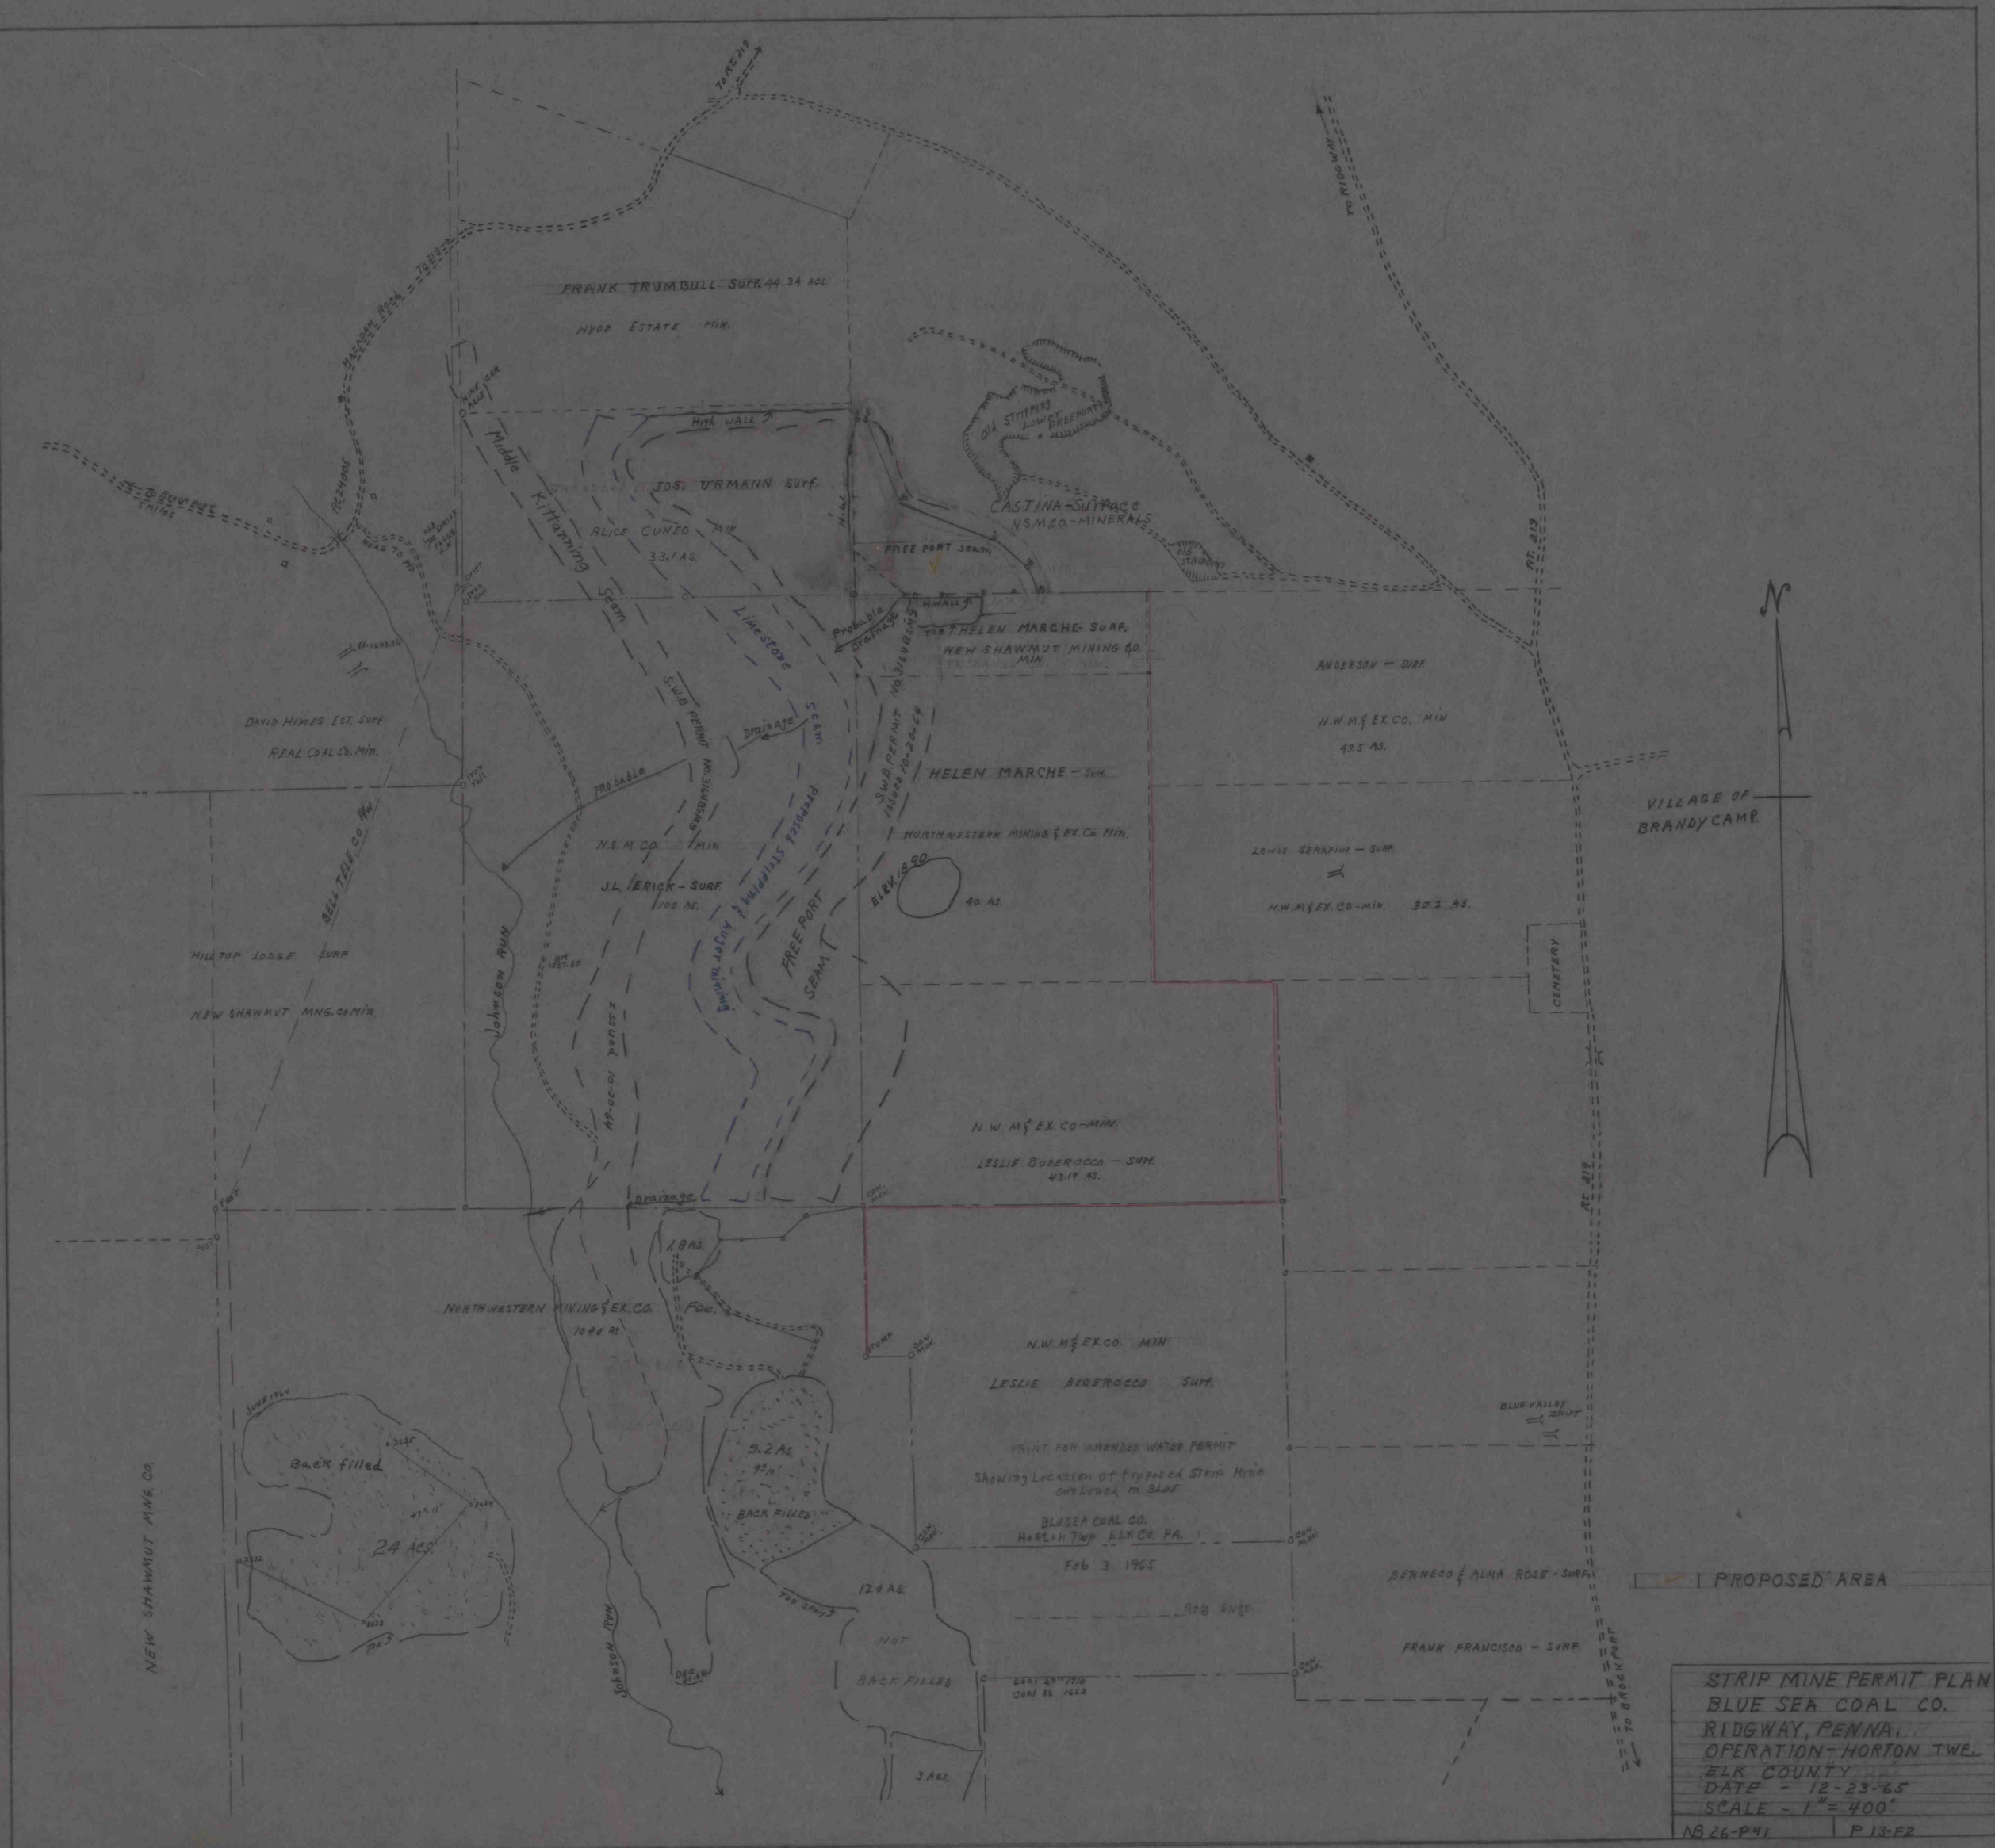

Traced from
 MAP DRAWN BY ERLE HAA9
 OF THE BLUE SEA COAL CO.
 STRIP MINES IN HORTON TWP.
 ELK CO. PA.
 6-25-65.
 P 13-2