


5.89.

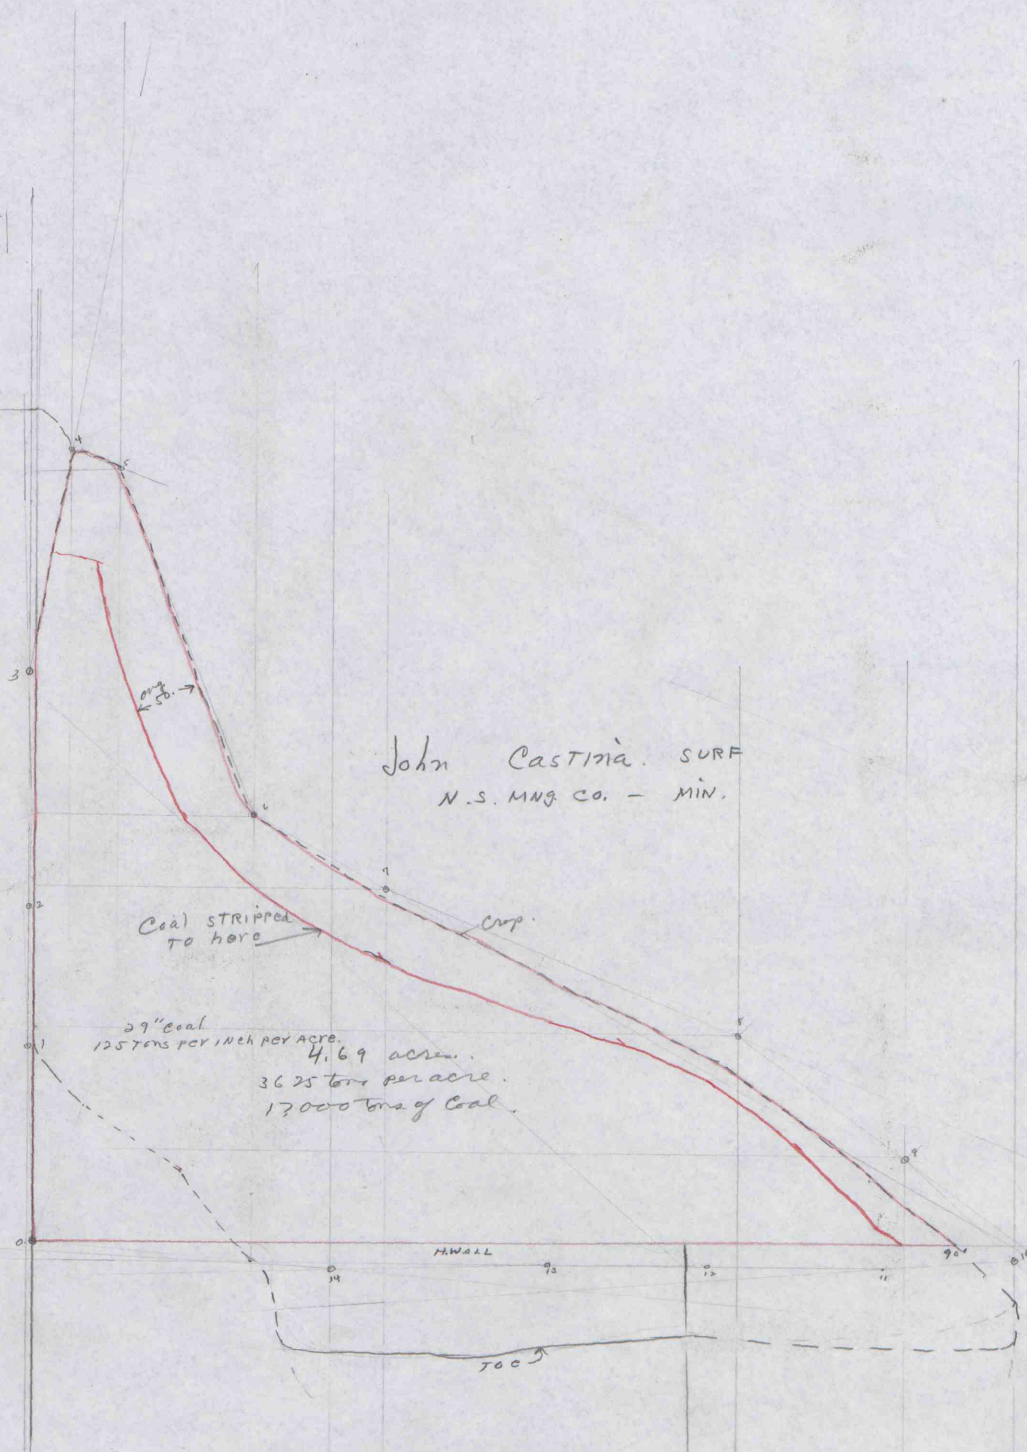

P 13-2.

Scale, 1" = 100'
Des. 23.65

IMAPS # 16487