


24
43 35
30 7 30

SAME MAP TO
SANITARY W. BOARD
+ ADDITION OF
CONTOUR LINES
CARDIFF ROAD
DATE 2 No.
NO. 2170 32
9-10-65
4-10-65

NOTE:
DATE OF
STILL PLANTING
CHANGED FROM 1957
TO 1955

NEW STRIP
MINING
4000

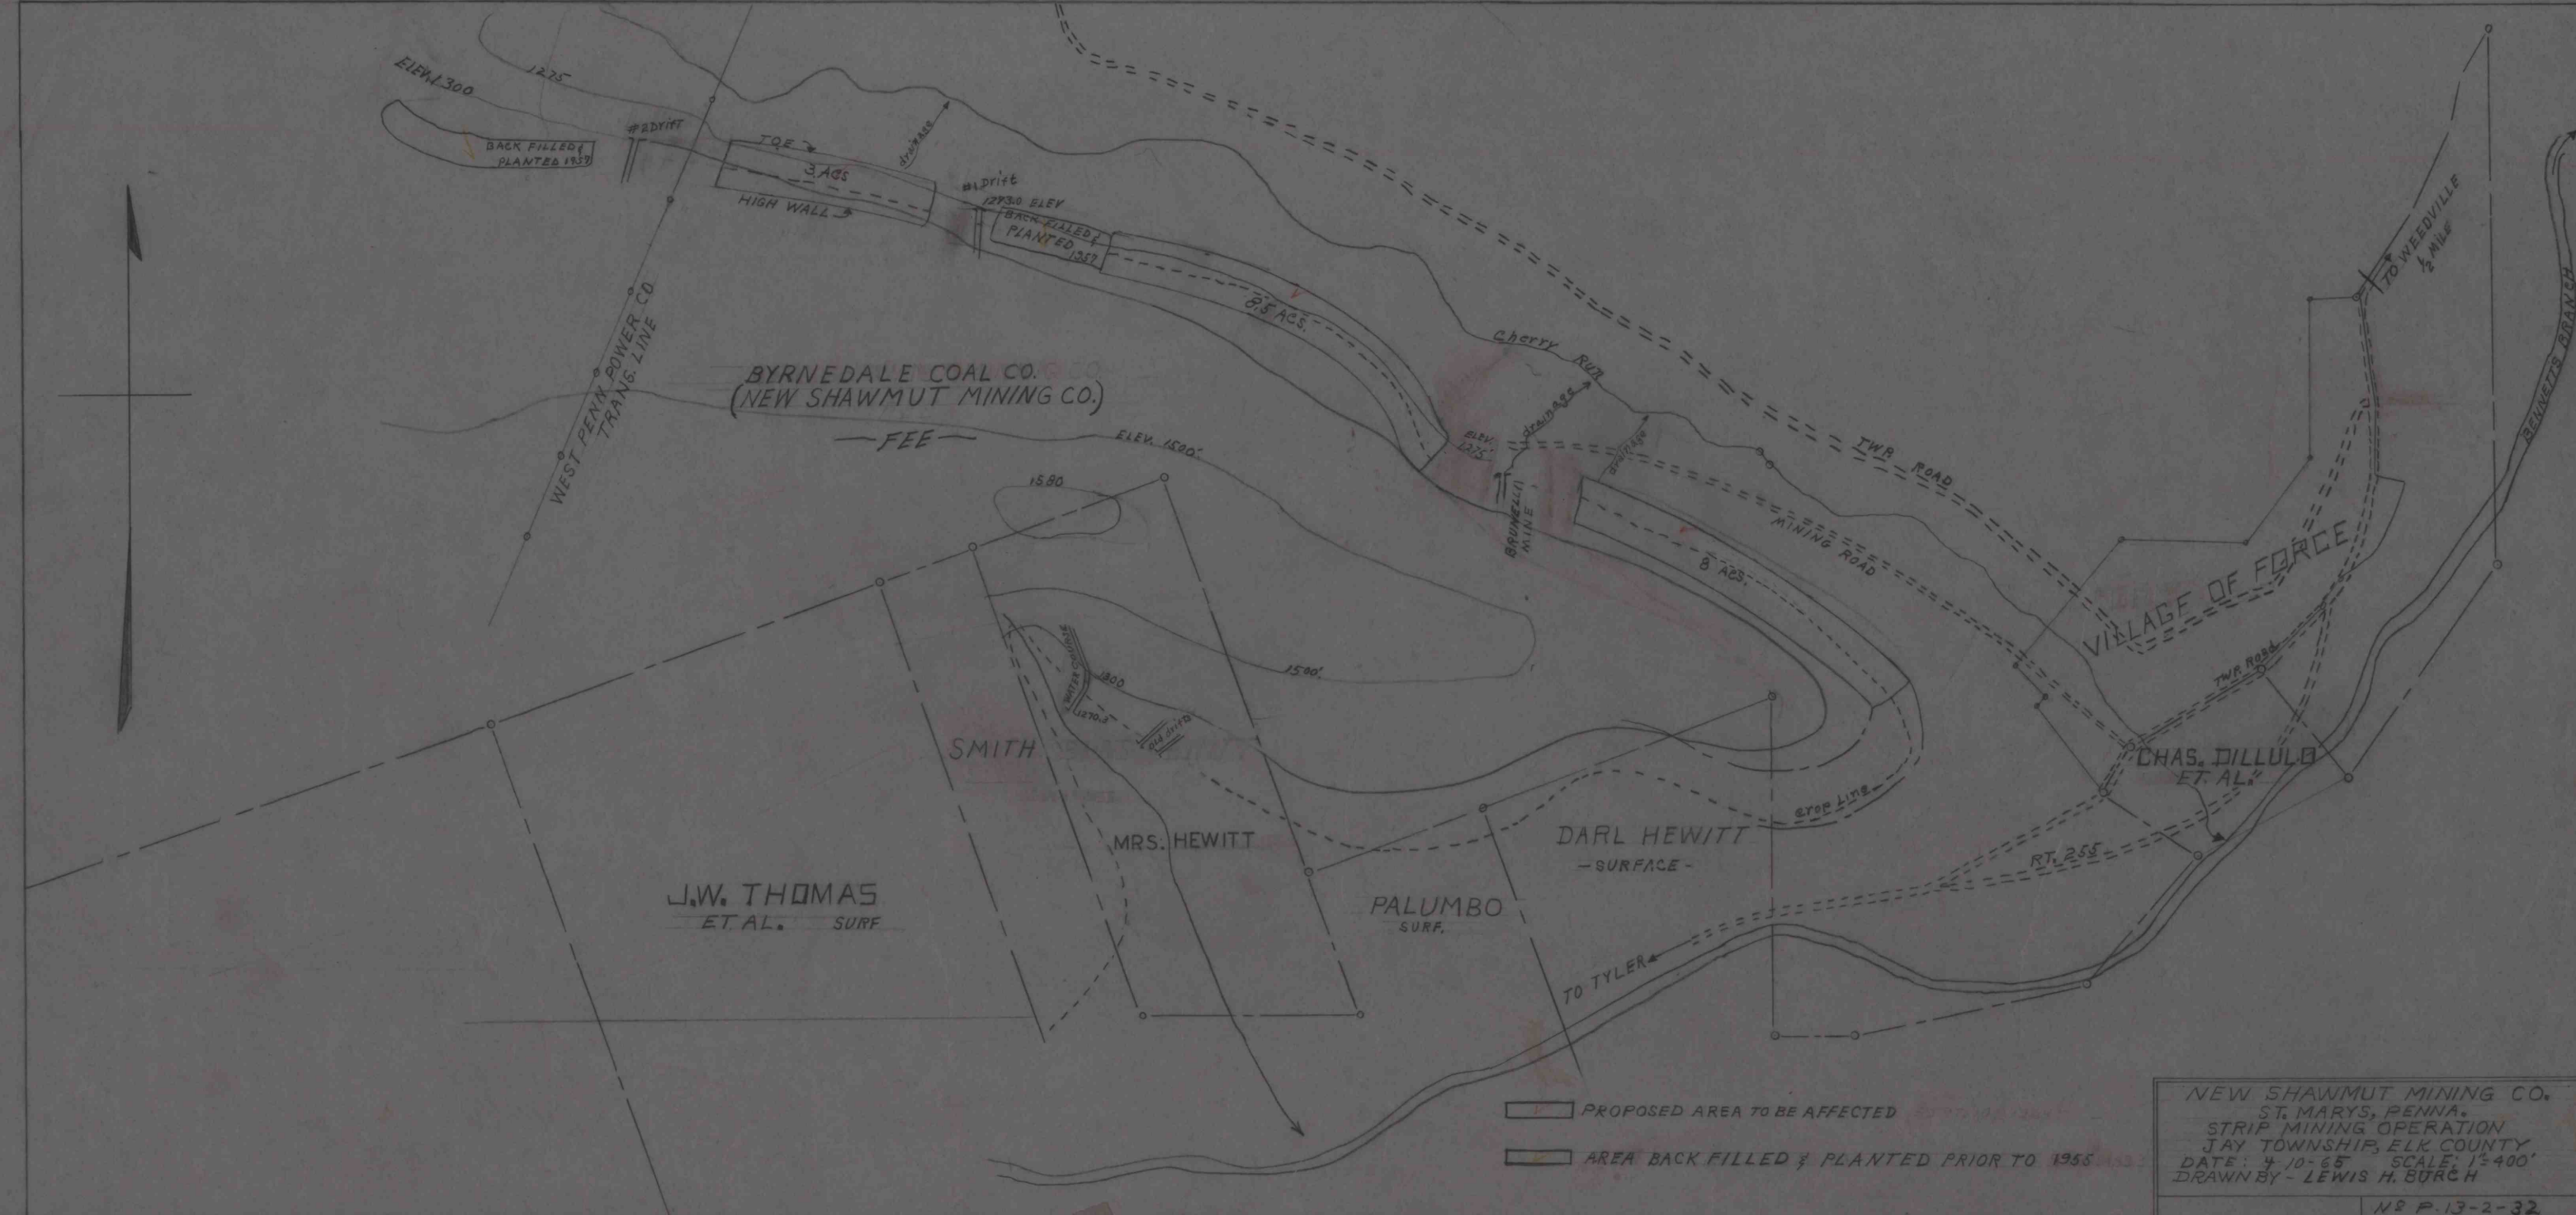

NEW SHAWMUT MINING CO.
ST. MARYS, PENNA.
STRIP MINING OPERATION
JAY TOWNSHIP, ELK COUNTY
DATE: 4-10-65 SCALE: 1"=400'
DRAWN BY - LEWIS H. BURCH

NS P. 13-2-32

IMAPS# 16496