


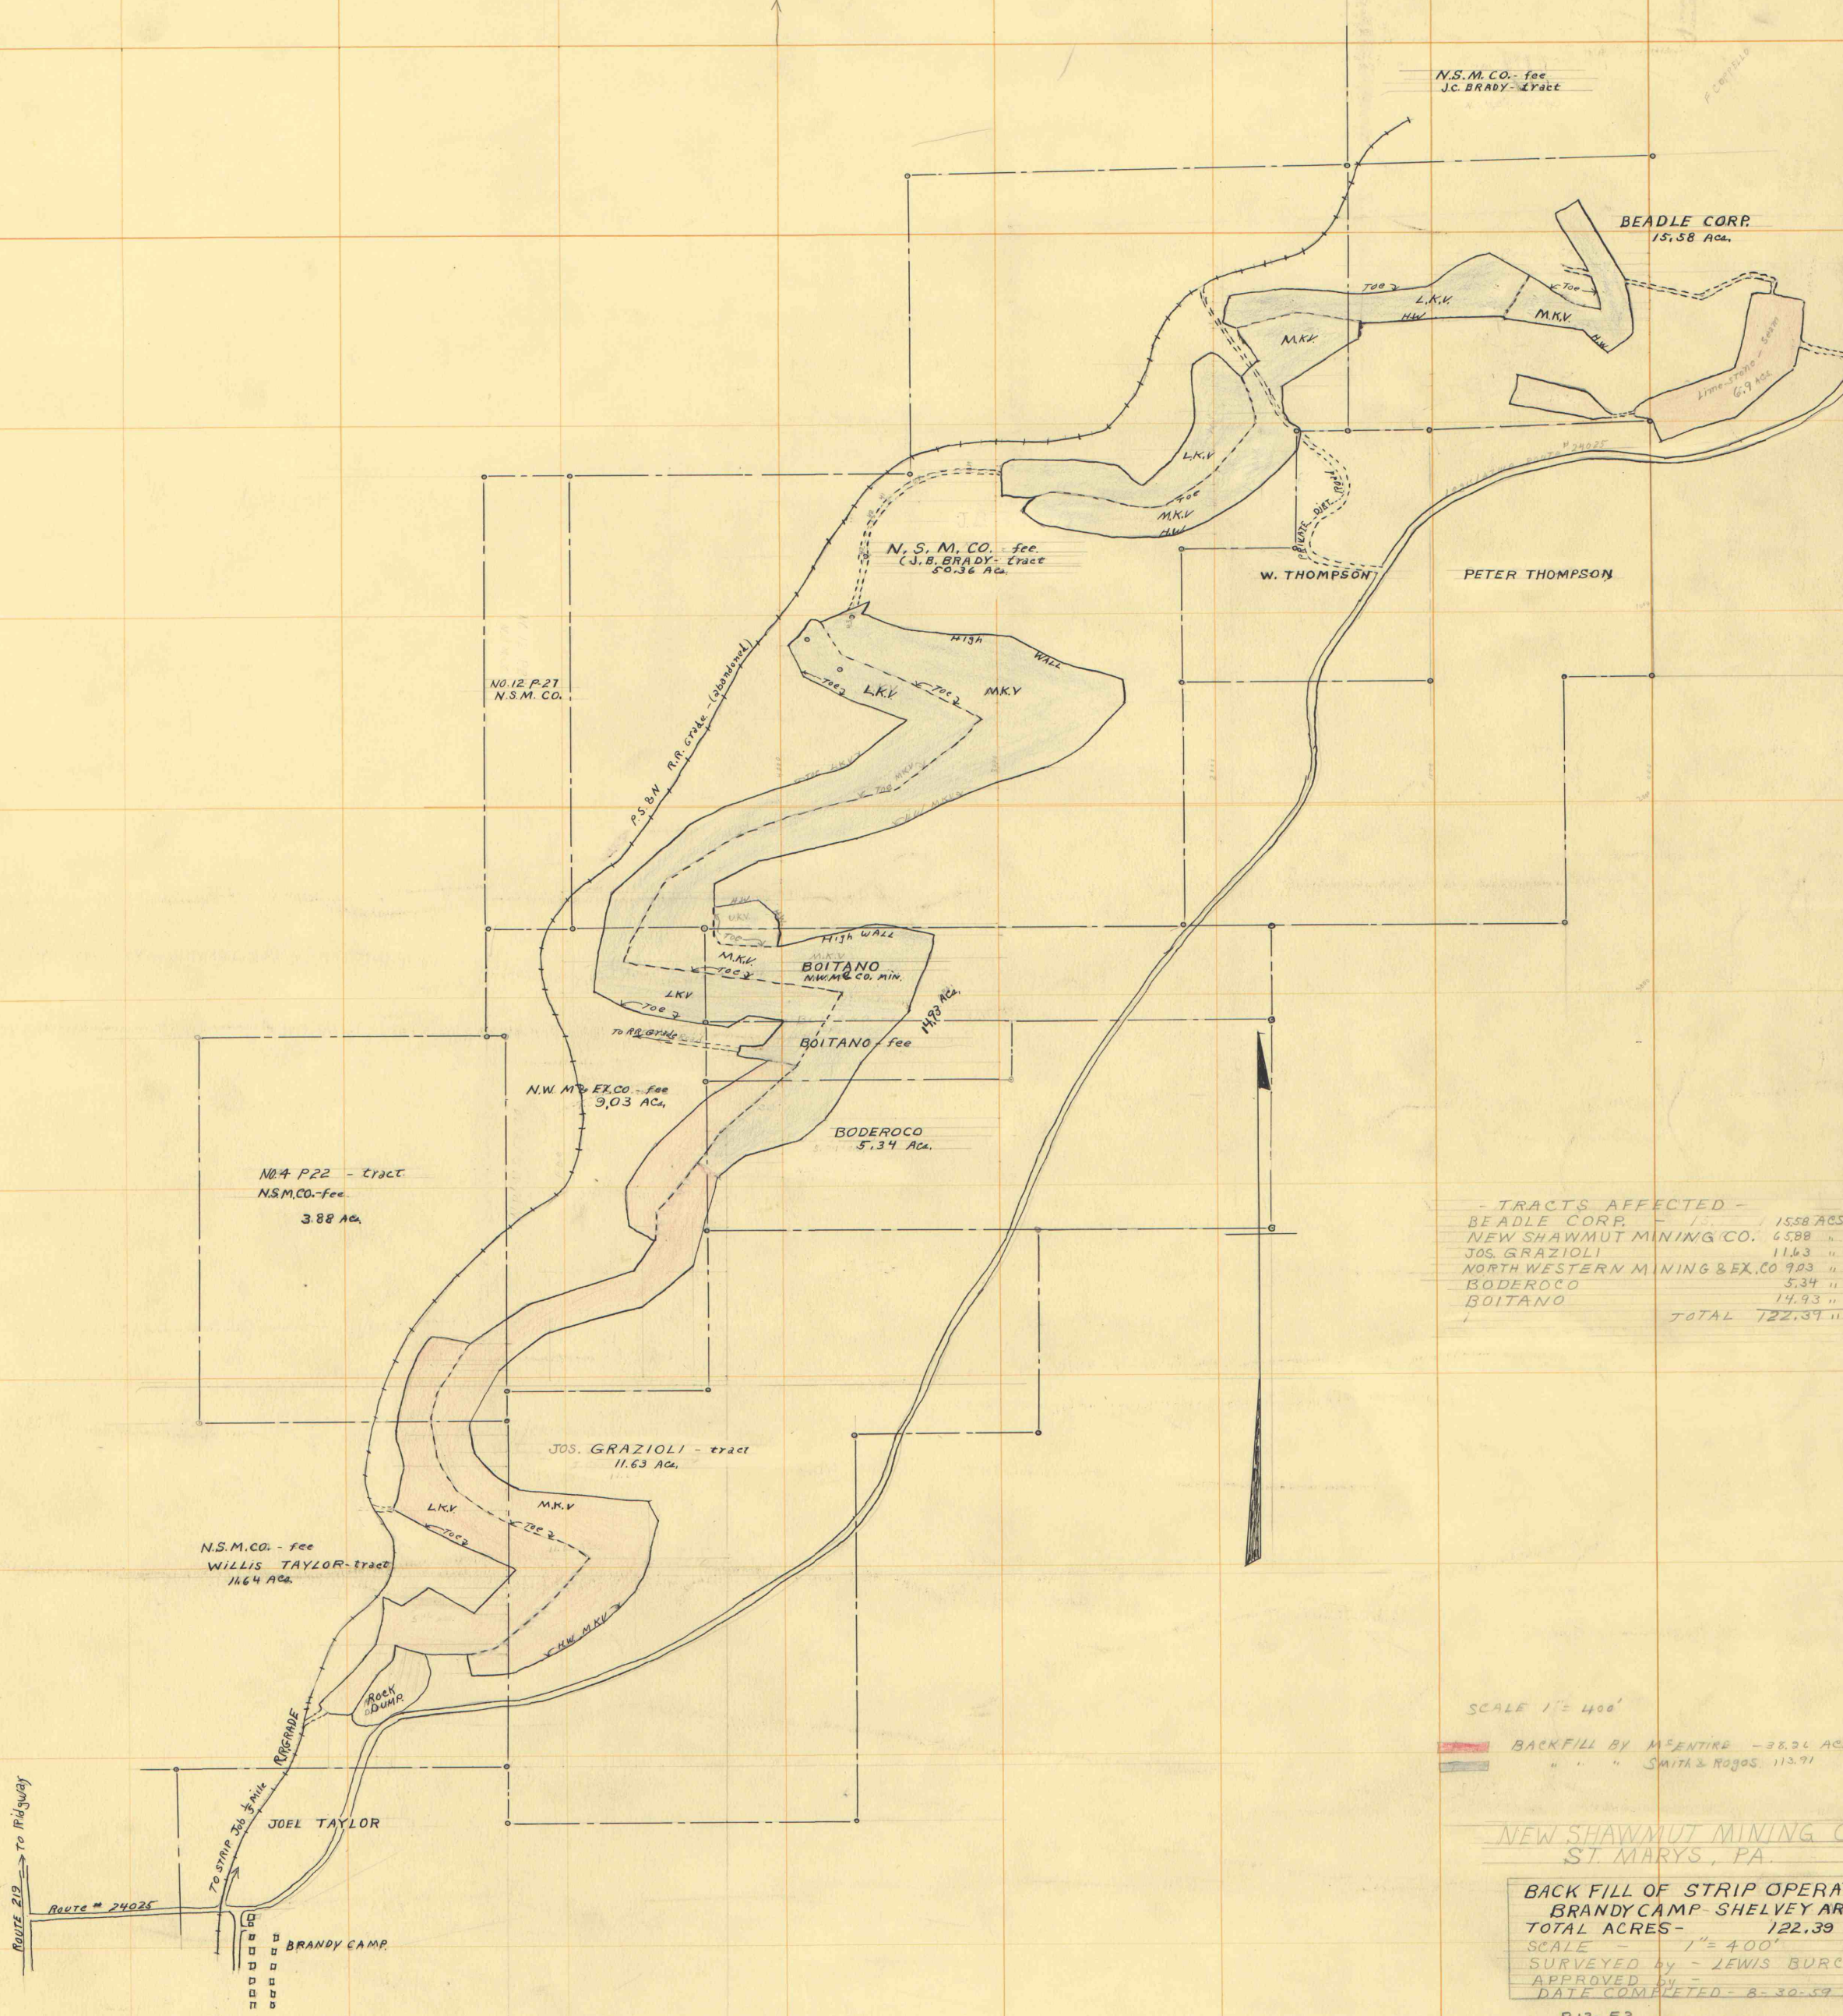

N.S.M. CO. - fee
J.C. BRADY - tract

BEADLE CORP.
15.58 Acs.

N.S.M. CO. - fee
J.C. BRADY - tract
50.36 Acs.

NO. 12 P-27
N.S.M. CO.

W. THOMPSON

PETER THOMPSON

N.W. M. & E. CO. - fee
9.03 Acs.

NO. 4 P-22 - tract
N.S.M. CO. - fee
3.88 Acs.

BODEROCO
5.34 Acs.

JOS. GRAZIOLI - tract
11.63 Acs.

N.S.M. CO. - fee
WILLIS TAYLOR - tract

JOEL TAYLOR

BRANDY CAMP

TRACTS AFFECTED -		
BEADLE CORP.	15.58	ACS.
JOS. GRAZIOLI	11.63	"
NORTH WESTERN MINING & EX. CO.	9.03	"
BODEROCO	5.34	"
BOITANO	14.93	"

SCALE 1" = 400'

BACKFILL BY M'ENTIRE - 38.24 AC.
" " SMITH & ROGOS 113.71

NEW SHAWMUT MINING CO.
ST. MARYS, PA.

BACK FILL OF STRIP OPERATING
BRANDY CAMP - SHELVEY AREA
TOTAL ACRES - 122.39
SCALE - 1" = 400'
SURVEYED BY - LEWIS BURCH
APPROVED BY -
DATE COMPLETED - 8-30-59
R13-F2