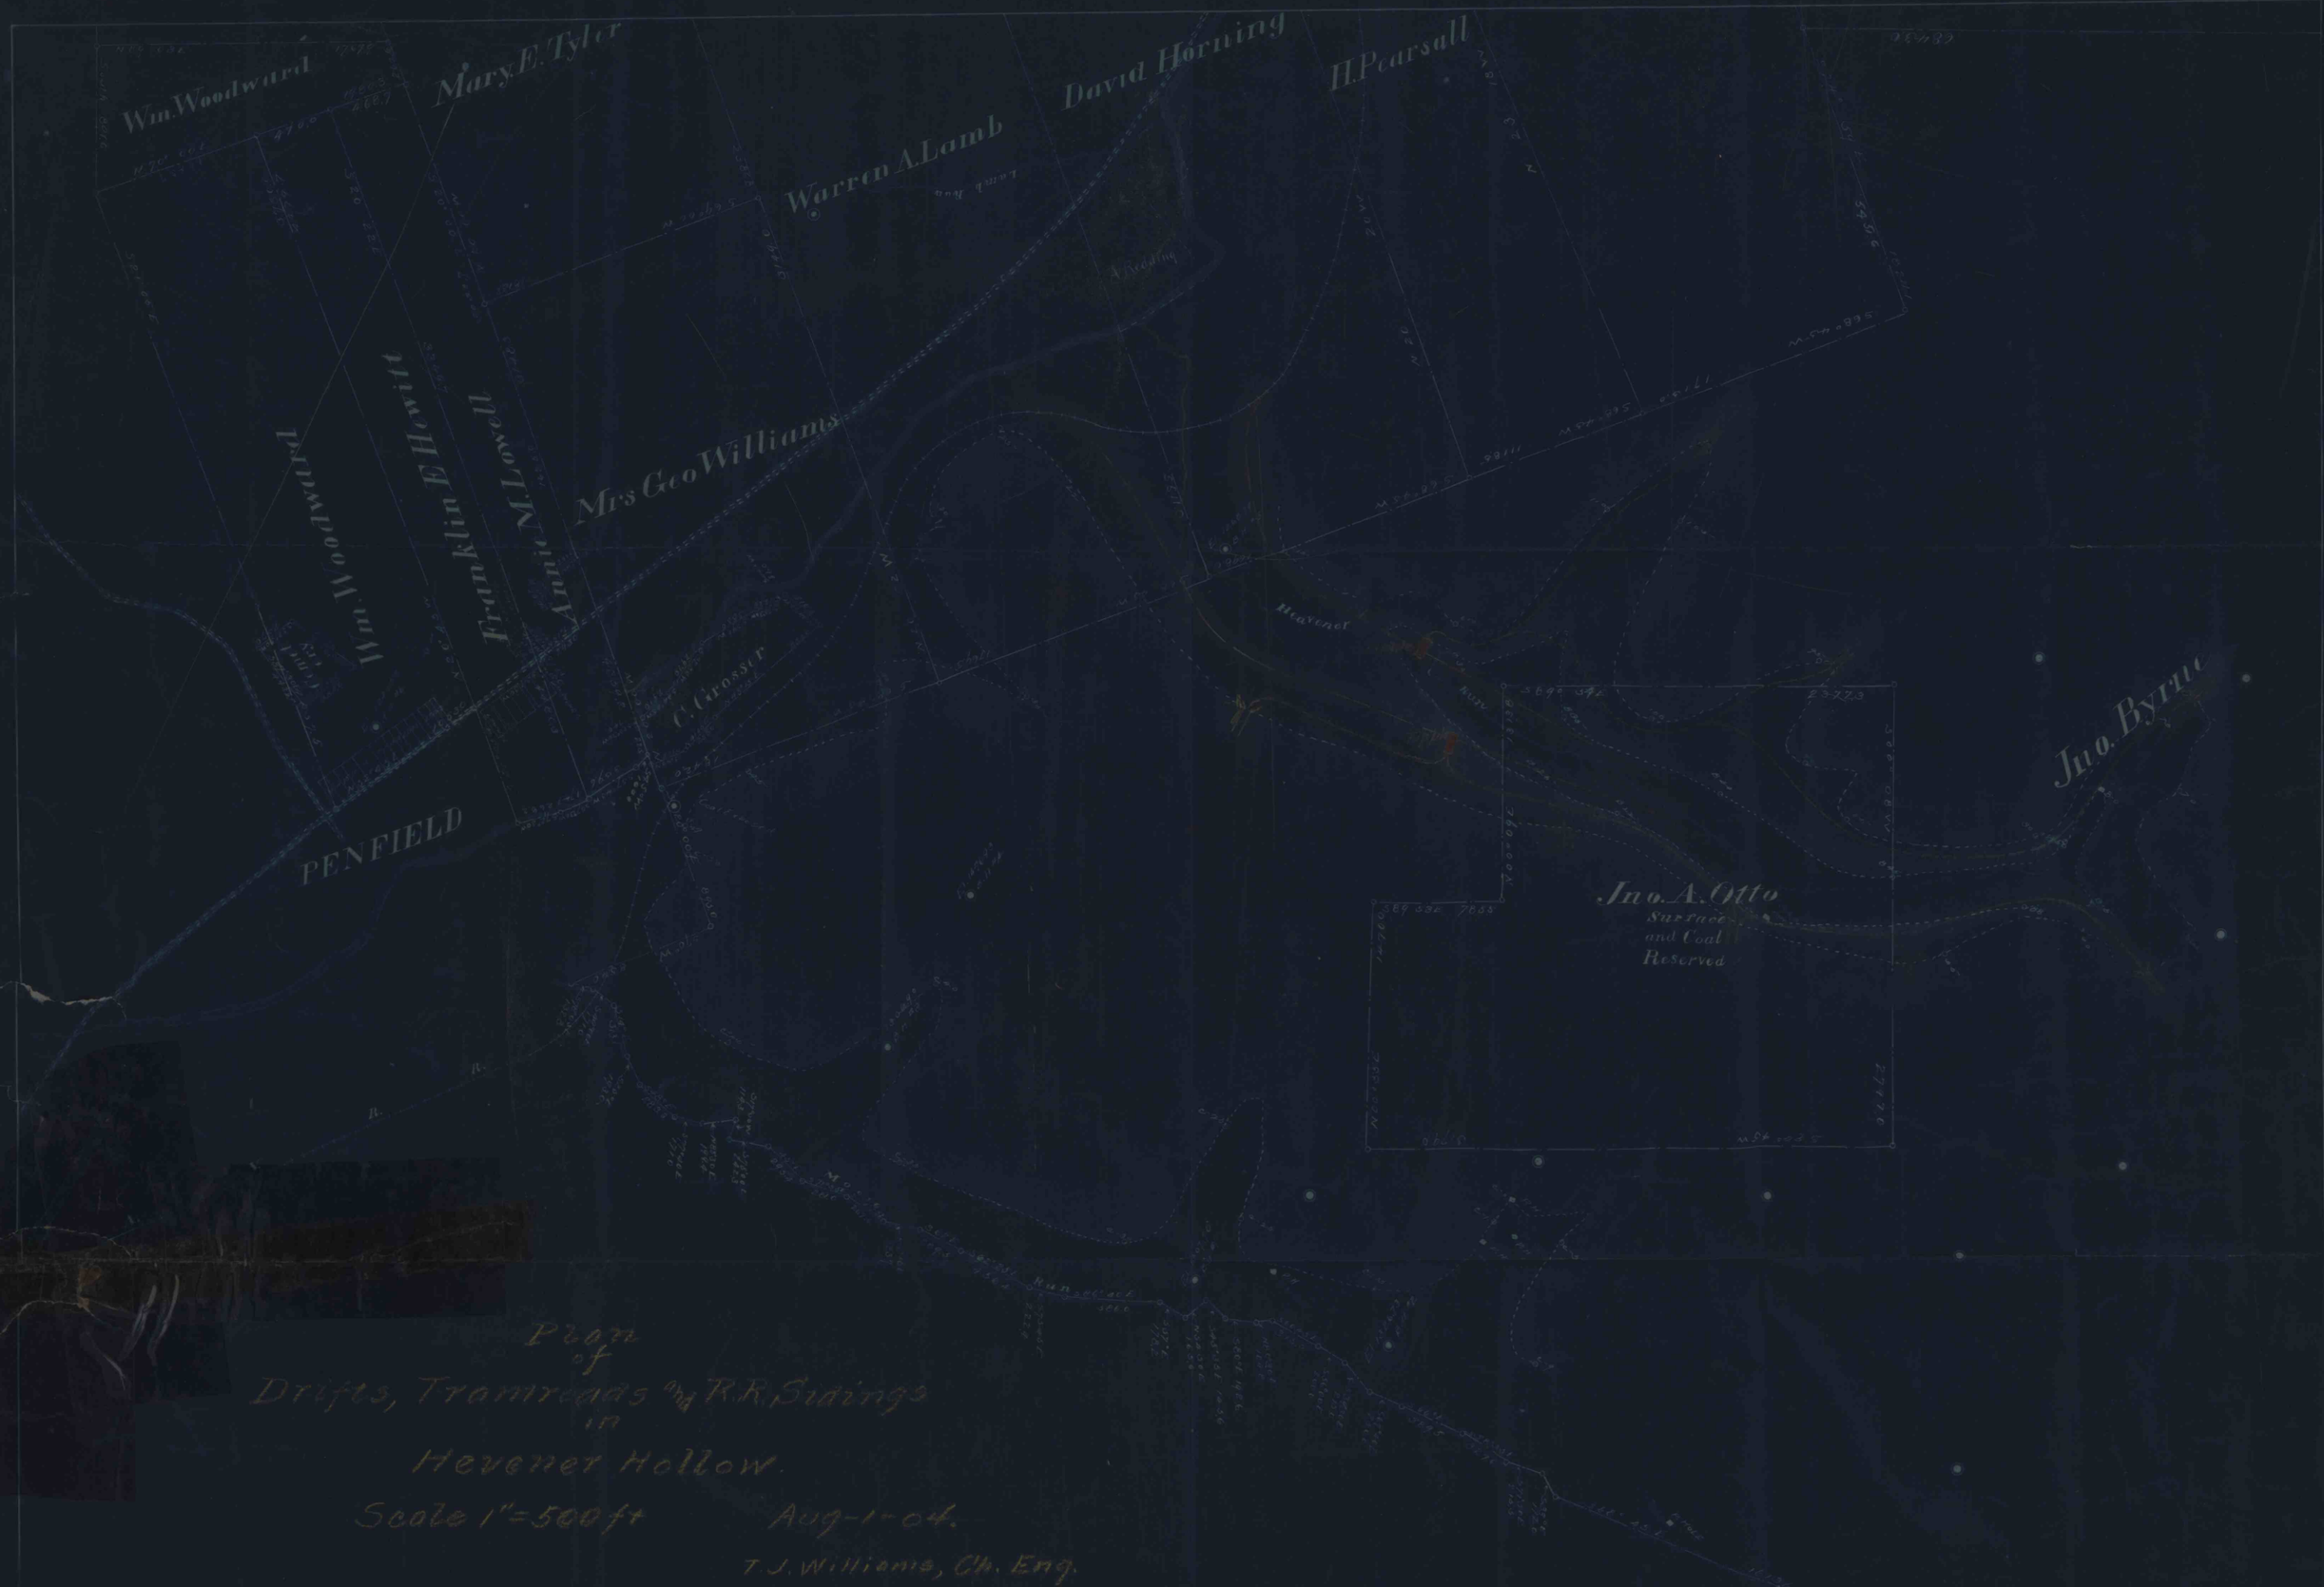
Wm. Woodward
Mary E. Tyler
Warren A. Lamb
David Horning
H. Pearsall
Mrs Geo Williams
Franklin Elliott
Annie M. Lowell
Wm Woodward
C. Crosser
PENFIELD
Heavener
Jno. Byrne
Jno. A. Otto
Surface
and Coal
Reserved
Plan
of
Drifts, Tramroads & R.R. Sidings
in
Hevener Hollow.
Scale 1" = 500 ft
Aug-1-04.
T. J. Williams, Ch. Eng.