


O of Geo Summit to K M Co 5-5-27
 O of H & K to K M Co 5-5-70
 17-11-11

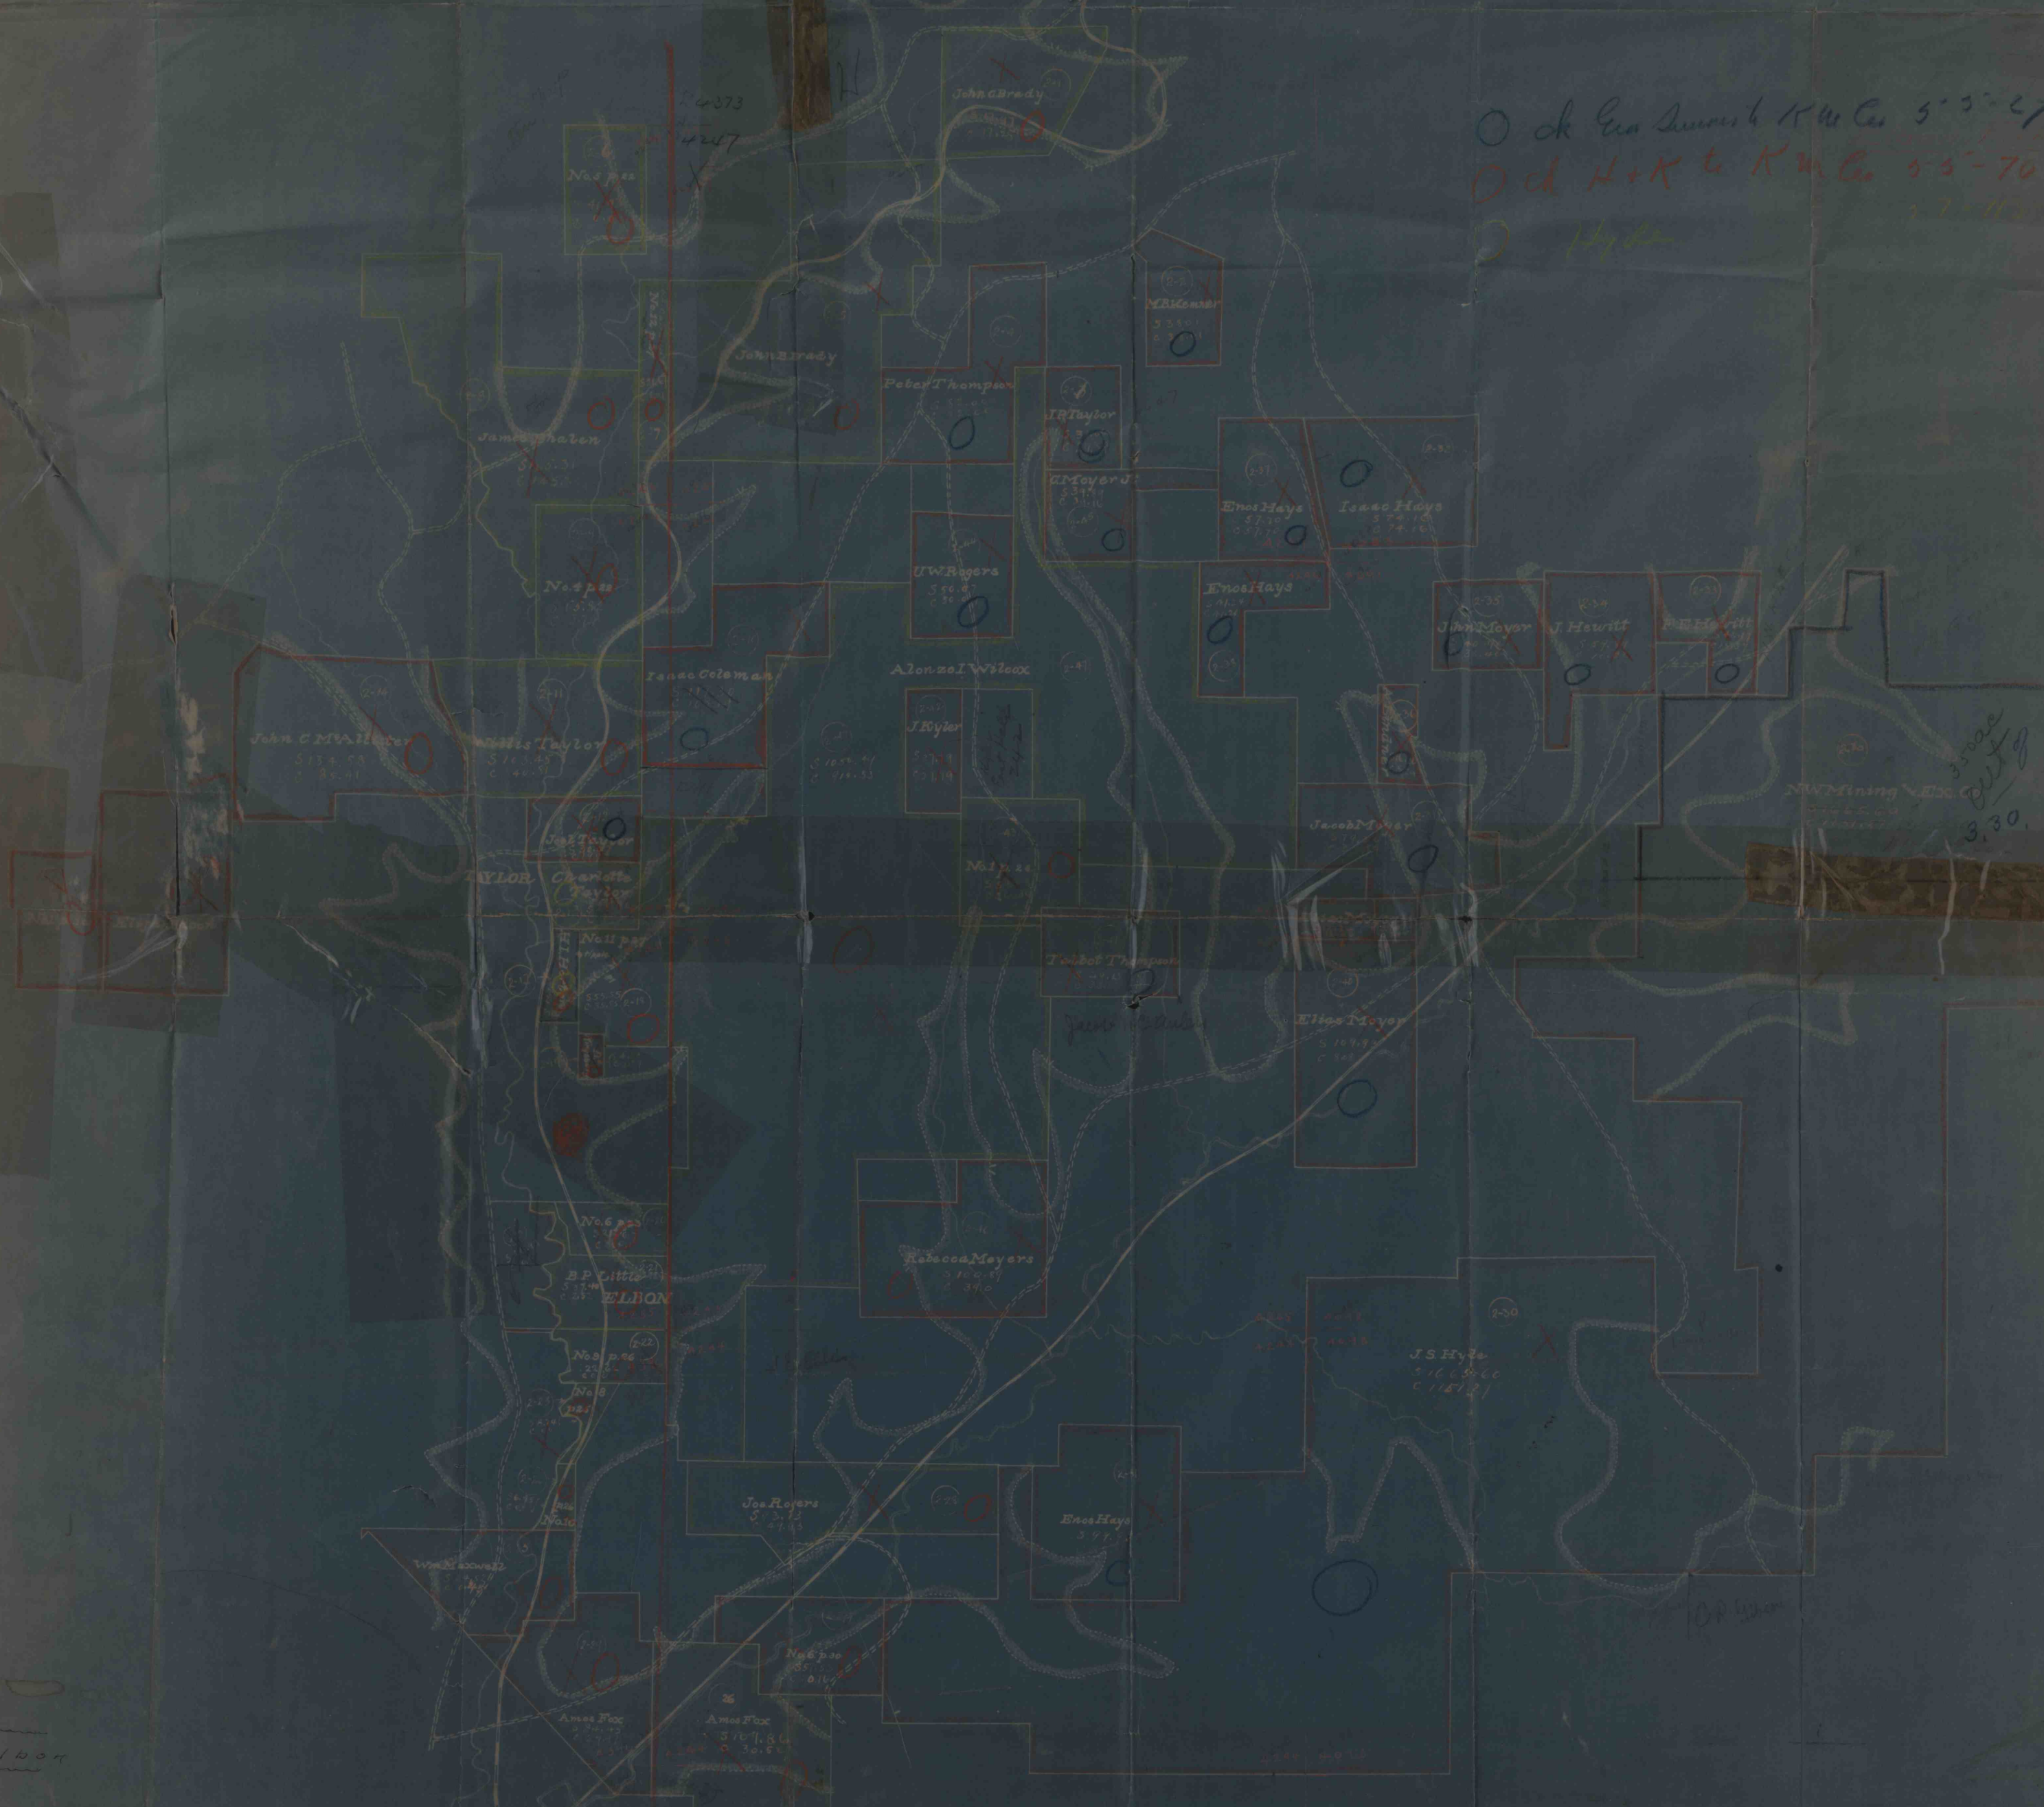

MAP OF
 ELBON FIELD
 SHAWMUT MIN CO.

Scale 1 in = 2000 ft.
 1905.
 Drawn by Shawmut Mining Co.
 Brown - Surface

I MAPS # 16518