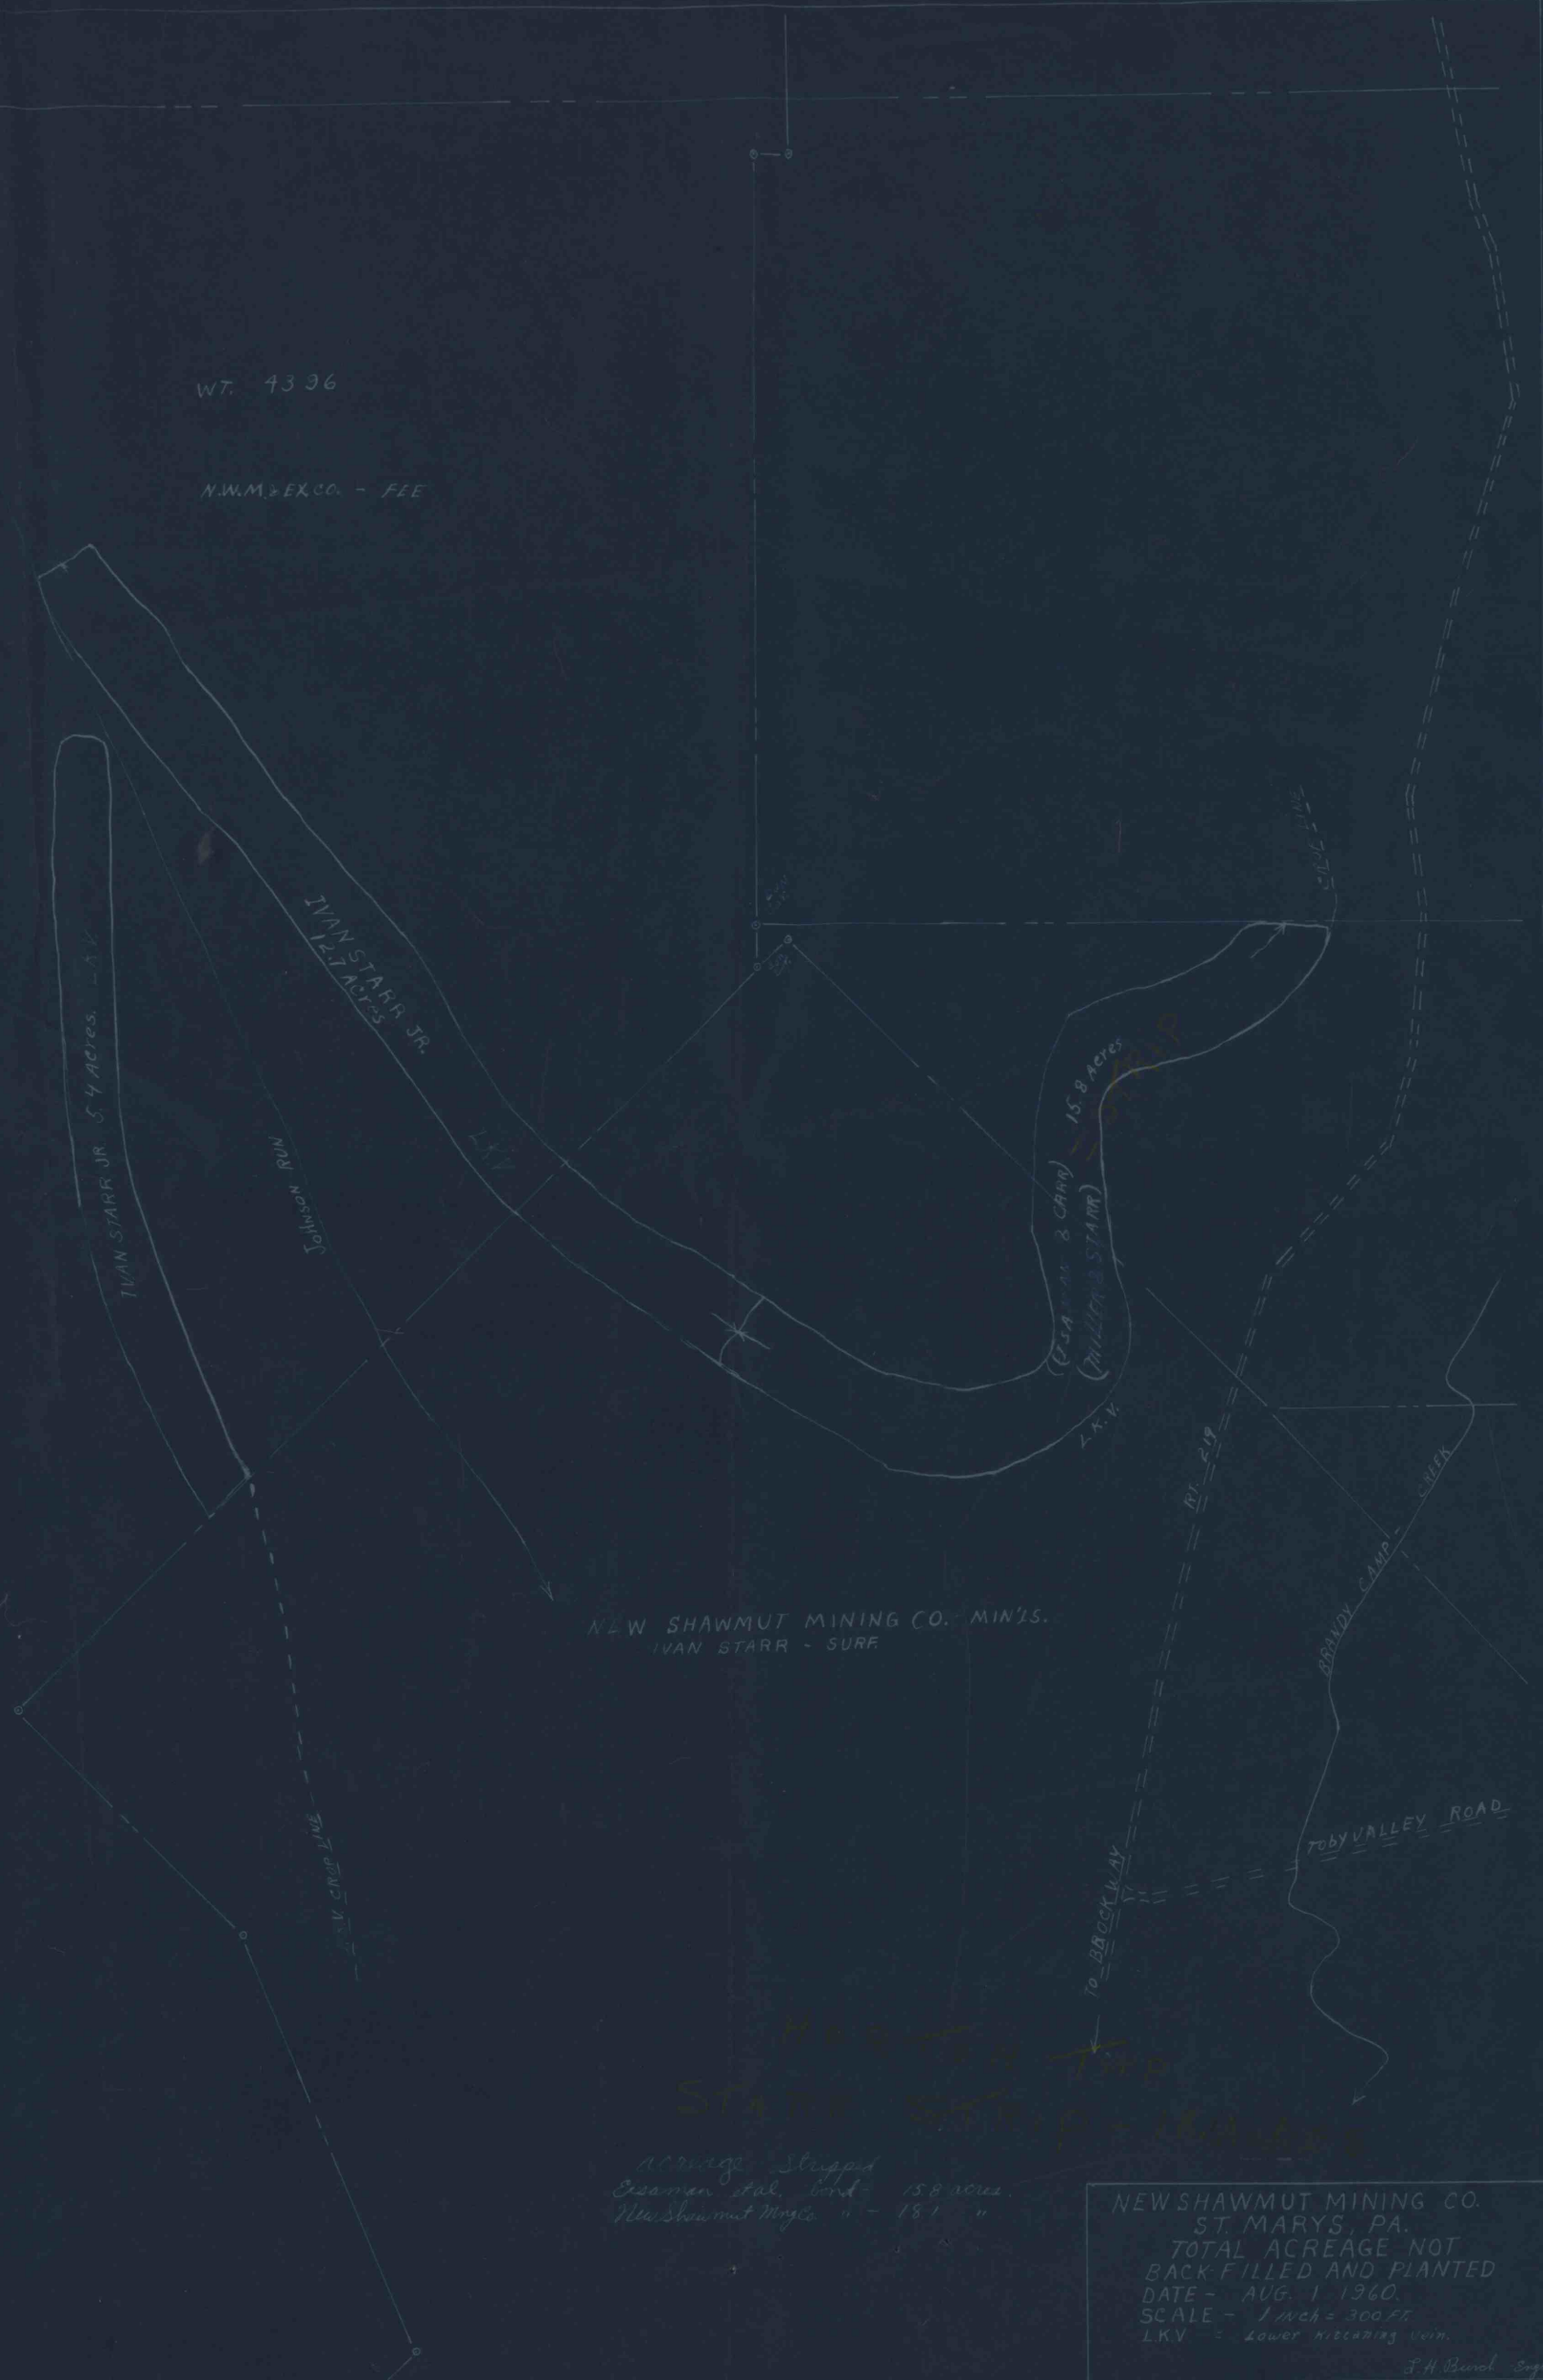
WT. 4396
N.W.M. & EX. CO. - FEE
IVAN STARR JR.
12.7 Acres
IVAN STARR JR. 5.4 Acres
Johnson Run
L.K.V.
15.8 Acres
L.K.V.
BRANDY CAMP CREEK
NEW SHAWMUT MINING CO. MIN'LS.
IVAN STARR - SURF
L.K.V. CROP LINE
TO BACKWAY
TOBY VALLEY ROAD
Acreage Stripped
Essaman et al. bond = 15.8 acres
New Shawmut Mng Co. " - 18.1 "
NEW SHAWMUT MINING CO.
ST. MARYS, PA.
TOTAL ACREAGE NOT
BACK FILLED AND PLANTED
DATE - AUG. 1 1960.
SCALE - 1 inch = 300 FT.
L.K.V. = Lower Kittanning Vein.
J. H. Burd Engr.

MAPS 16533