


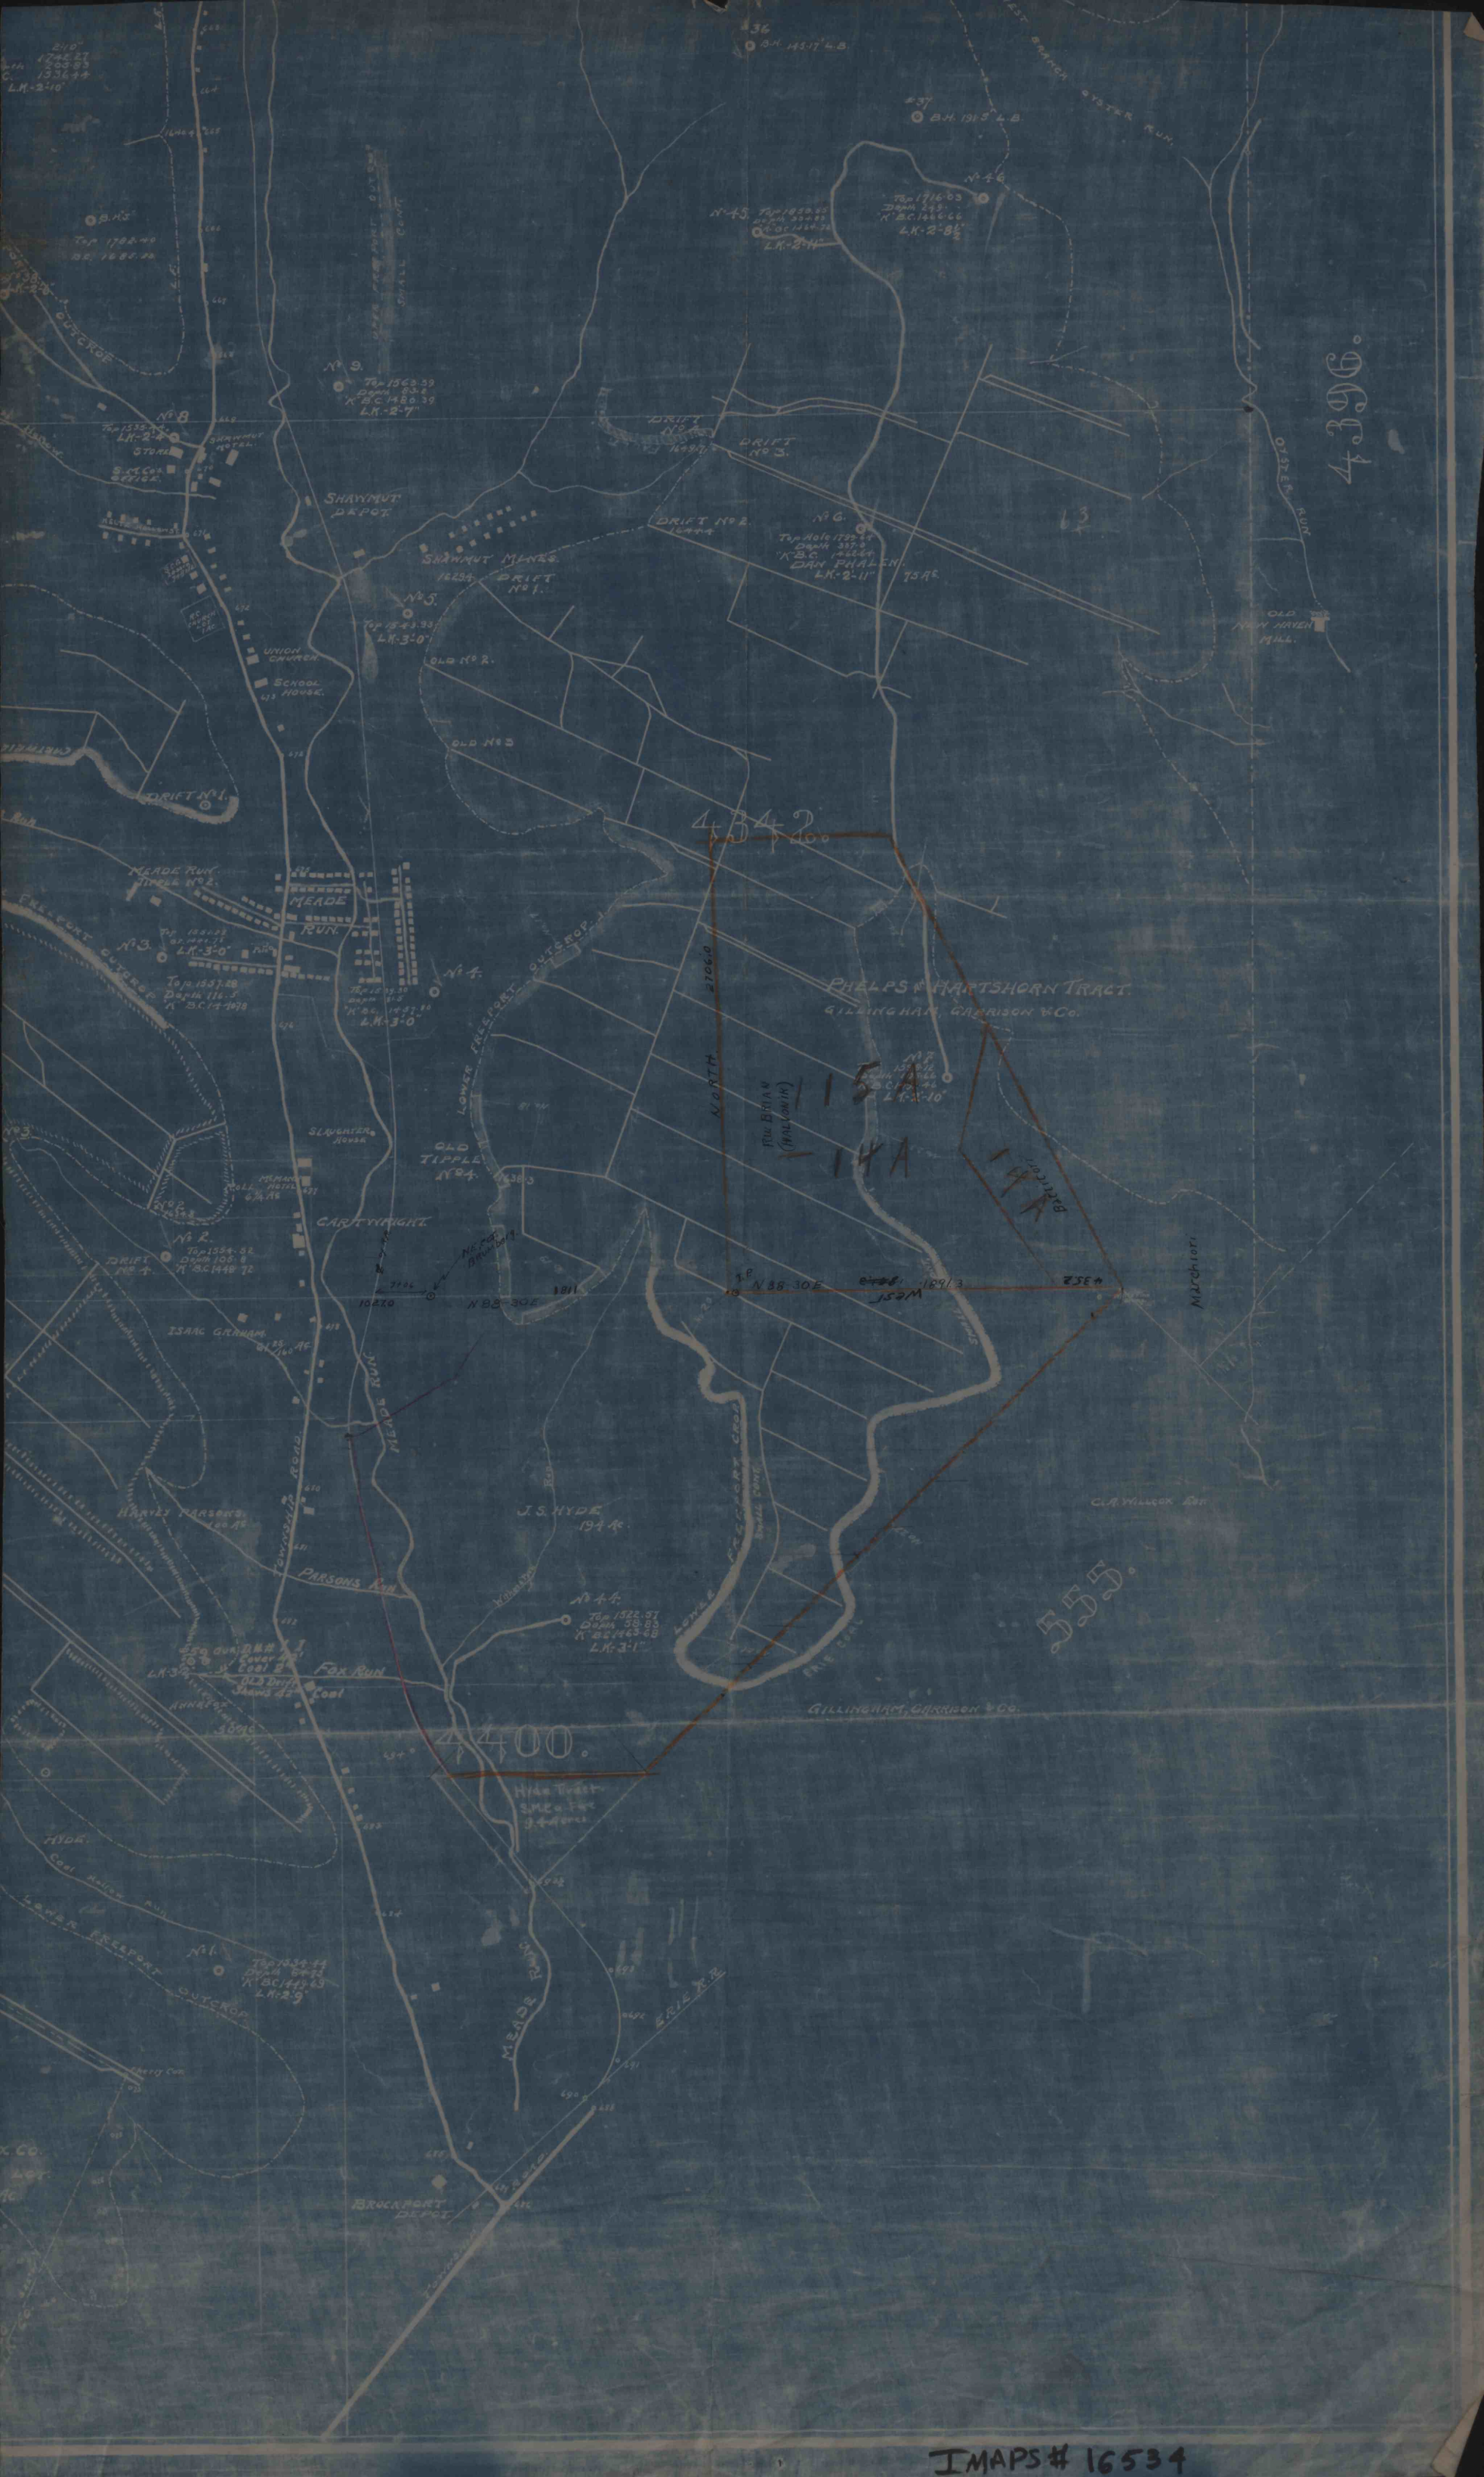

4396.

4342.

555.

4400.