


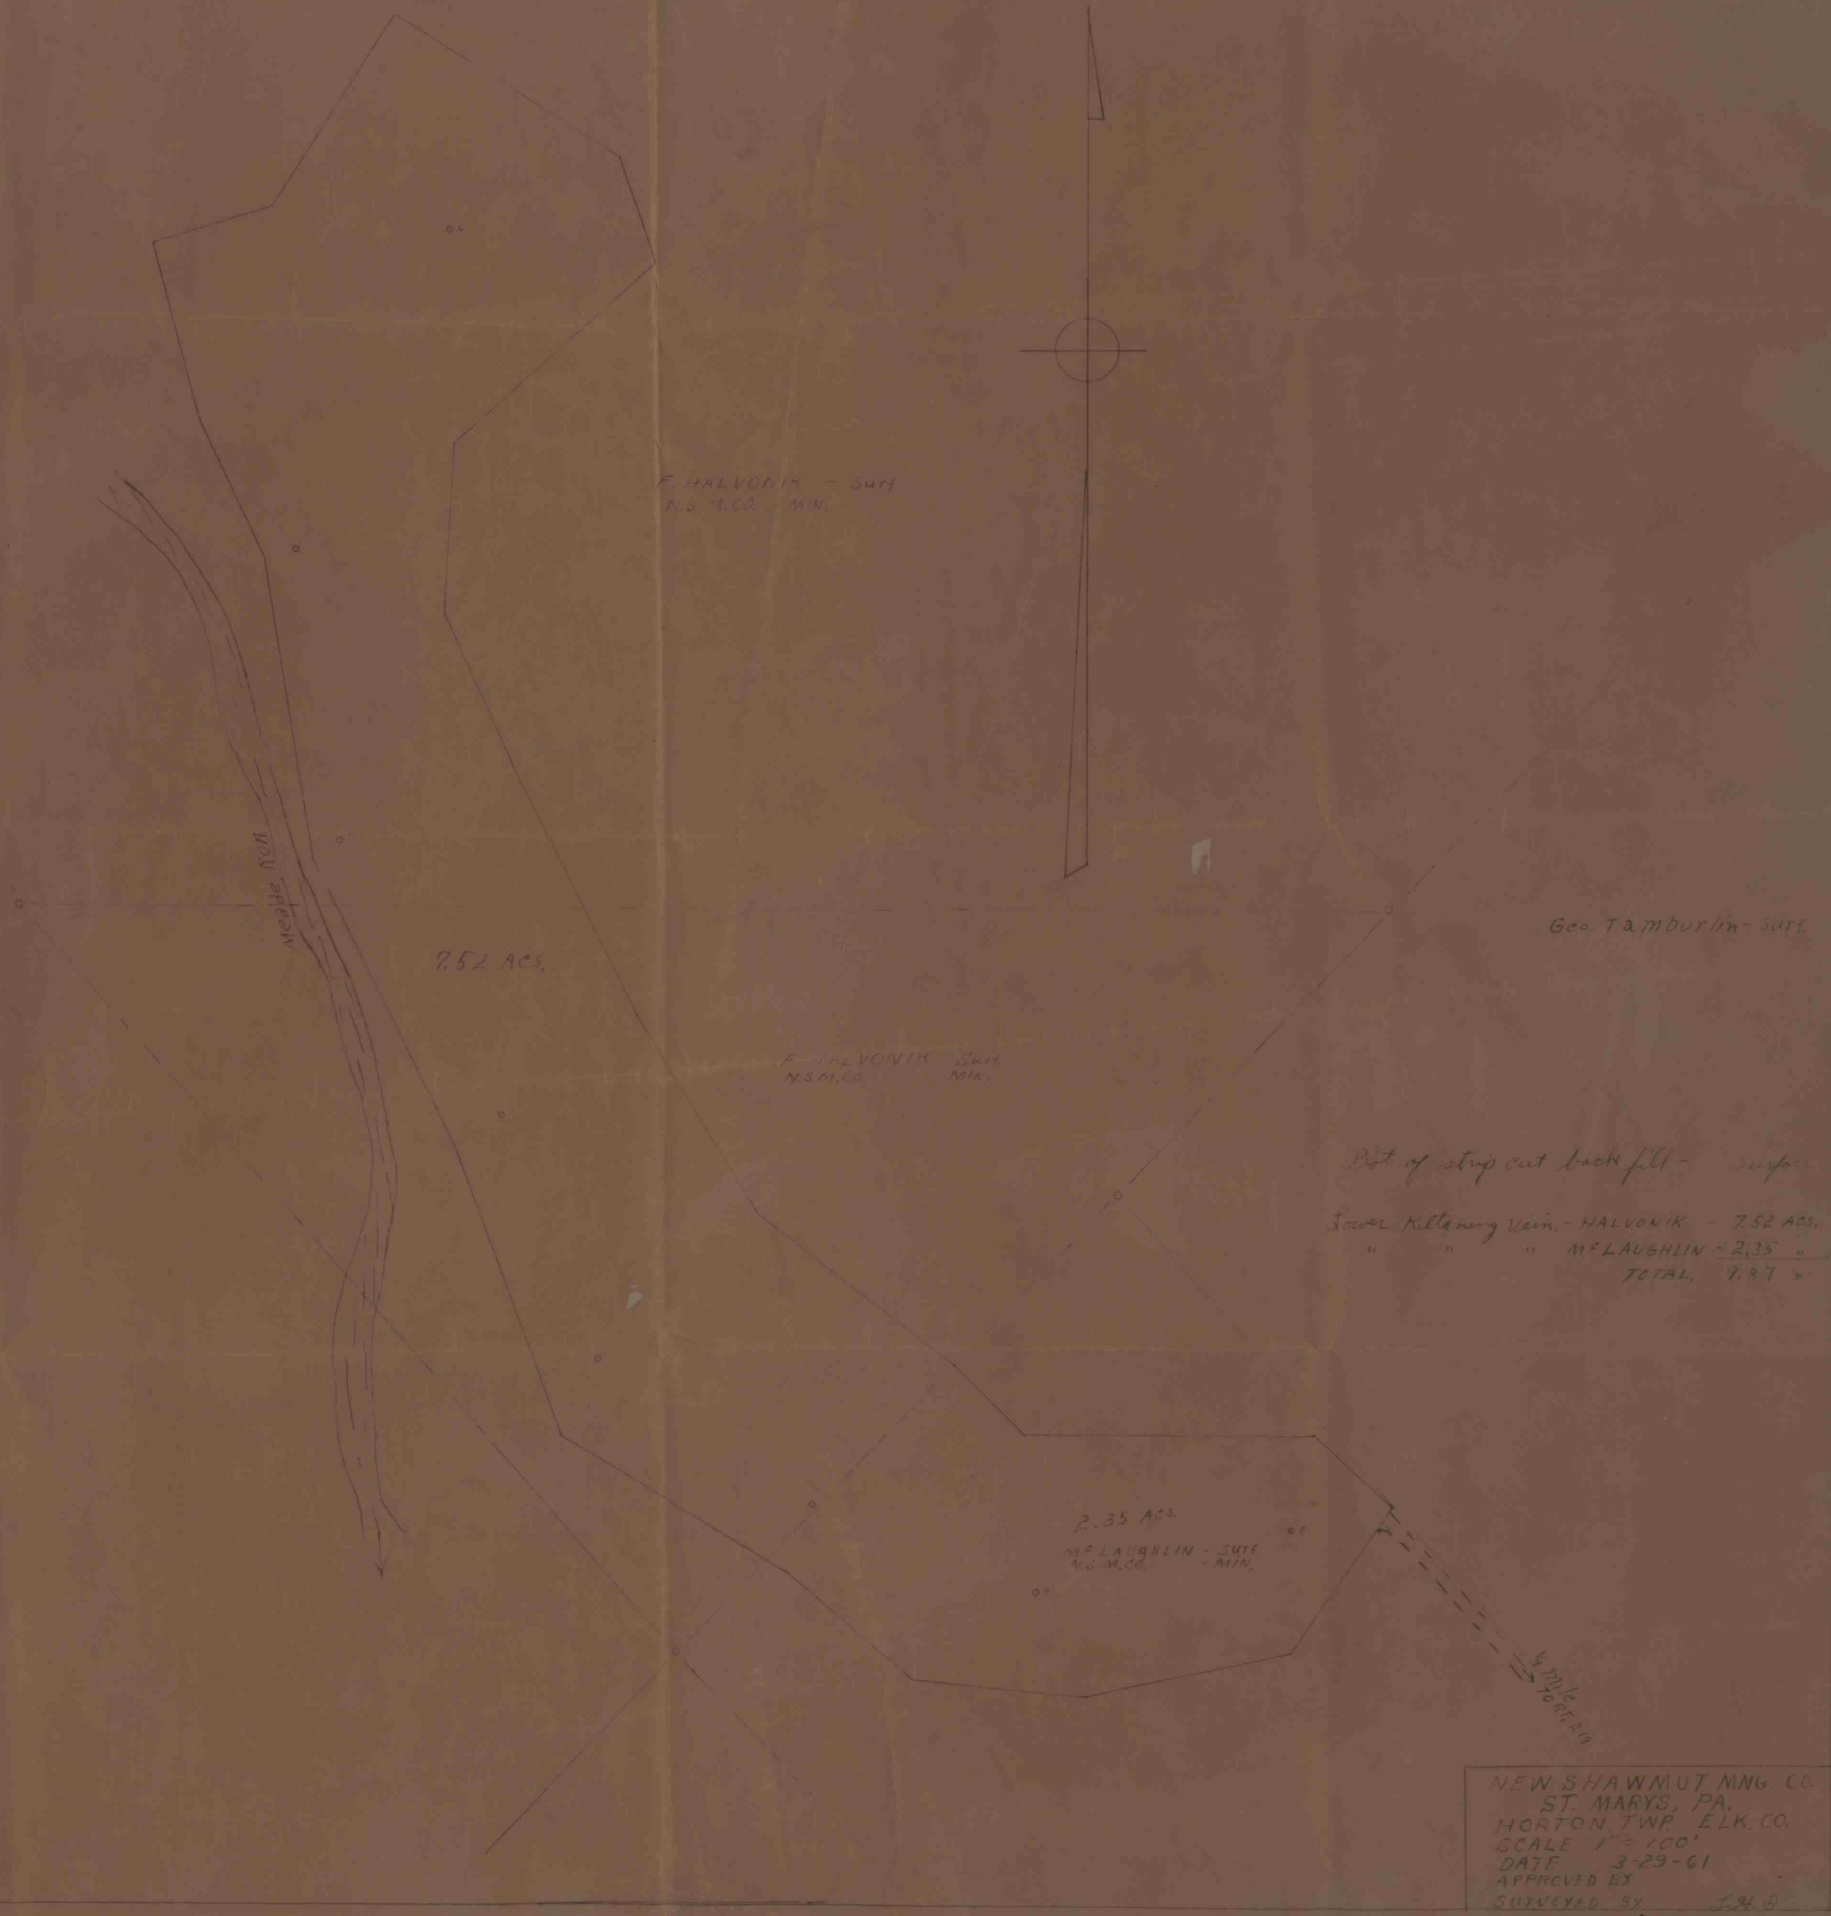

IMAPS #16535