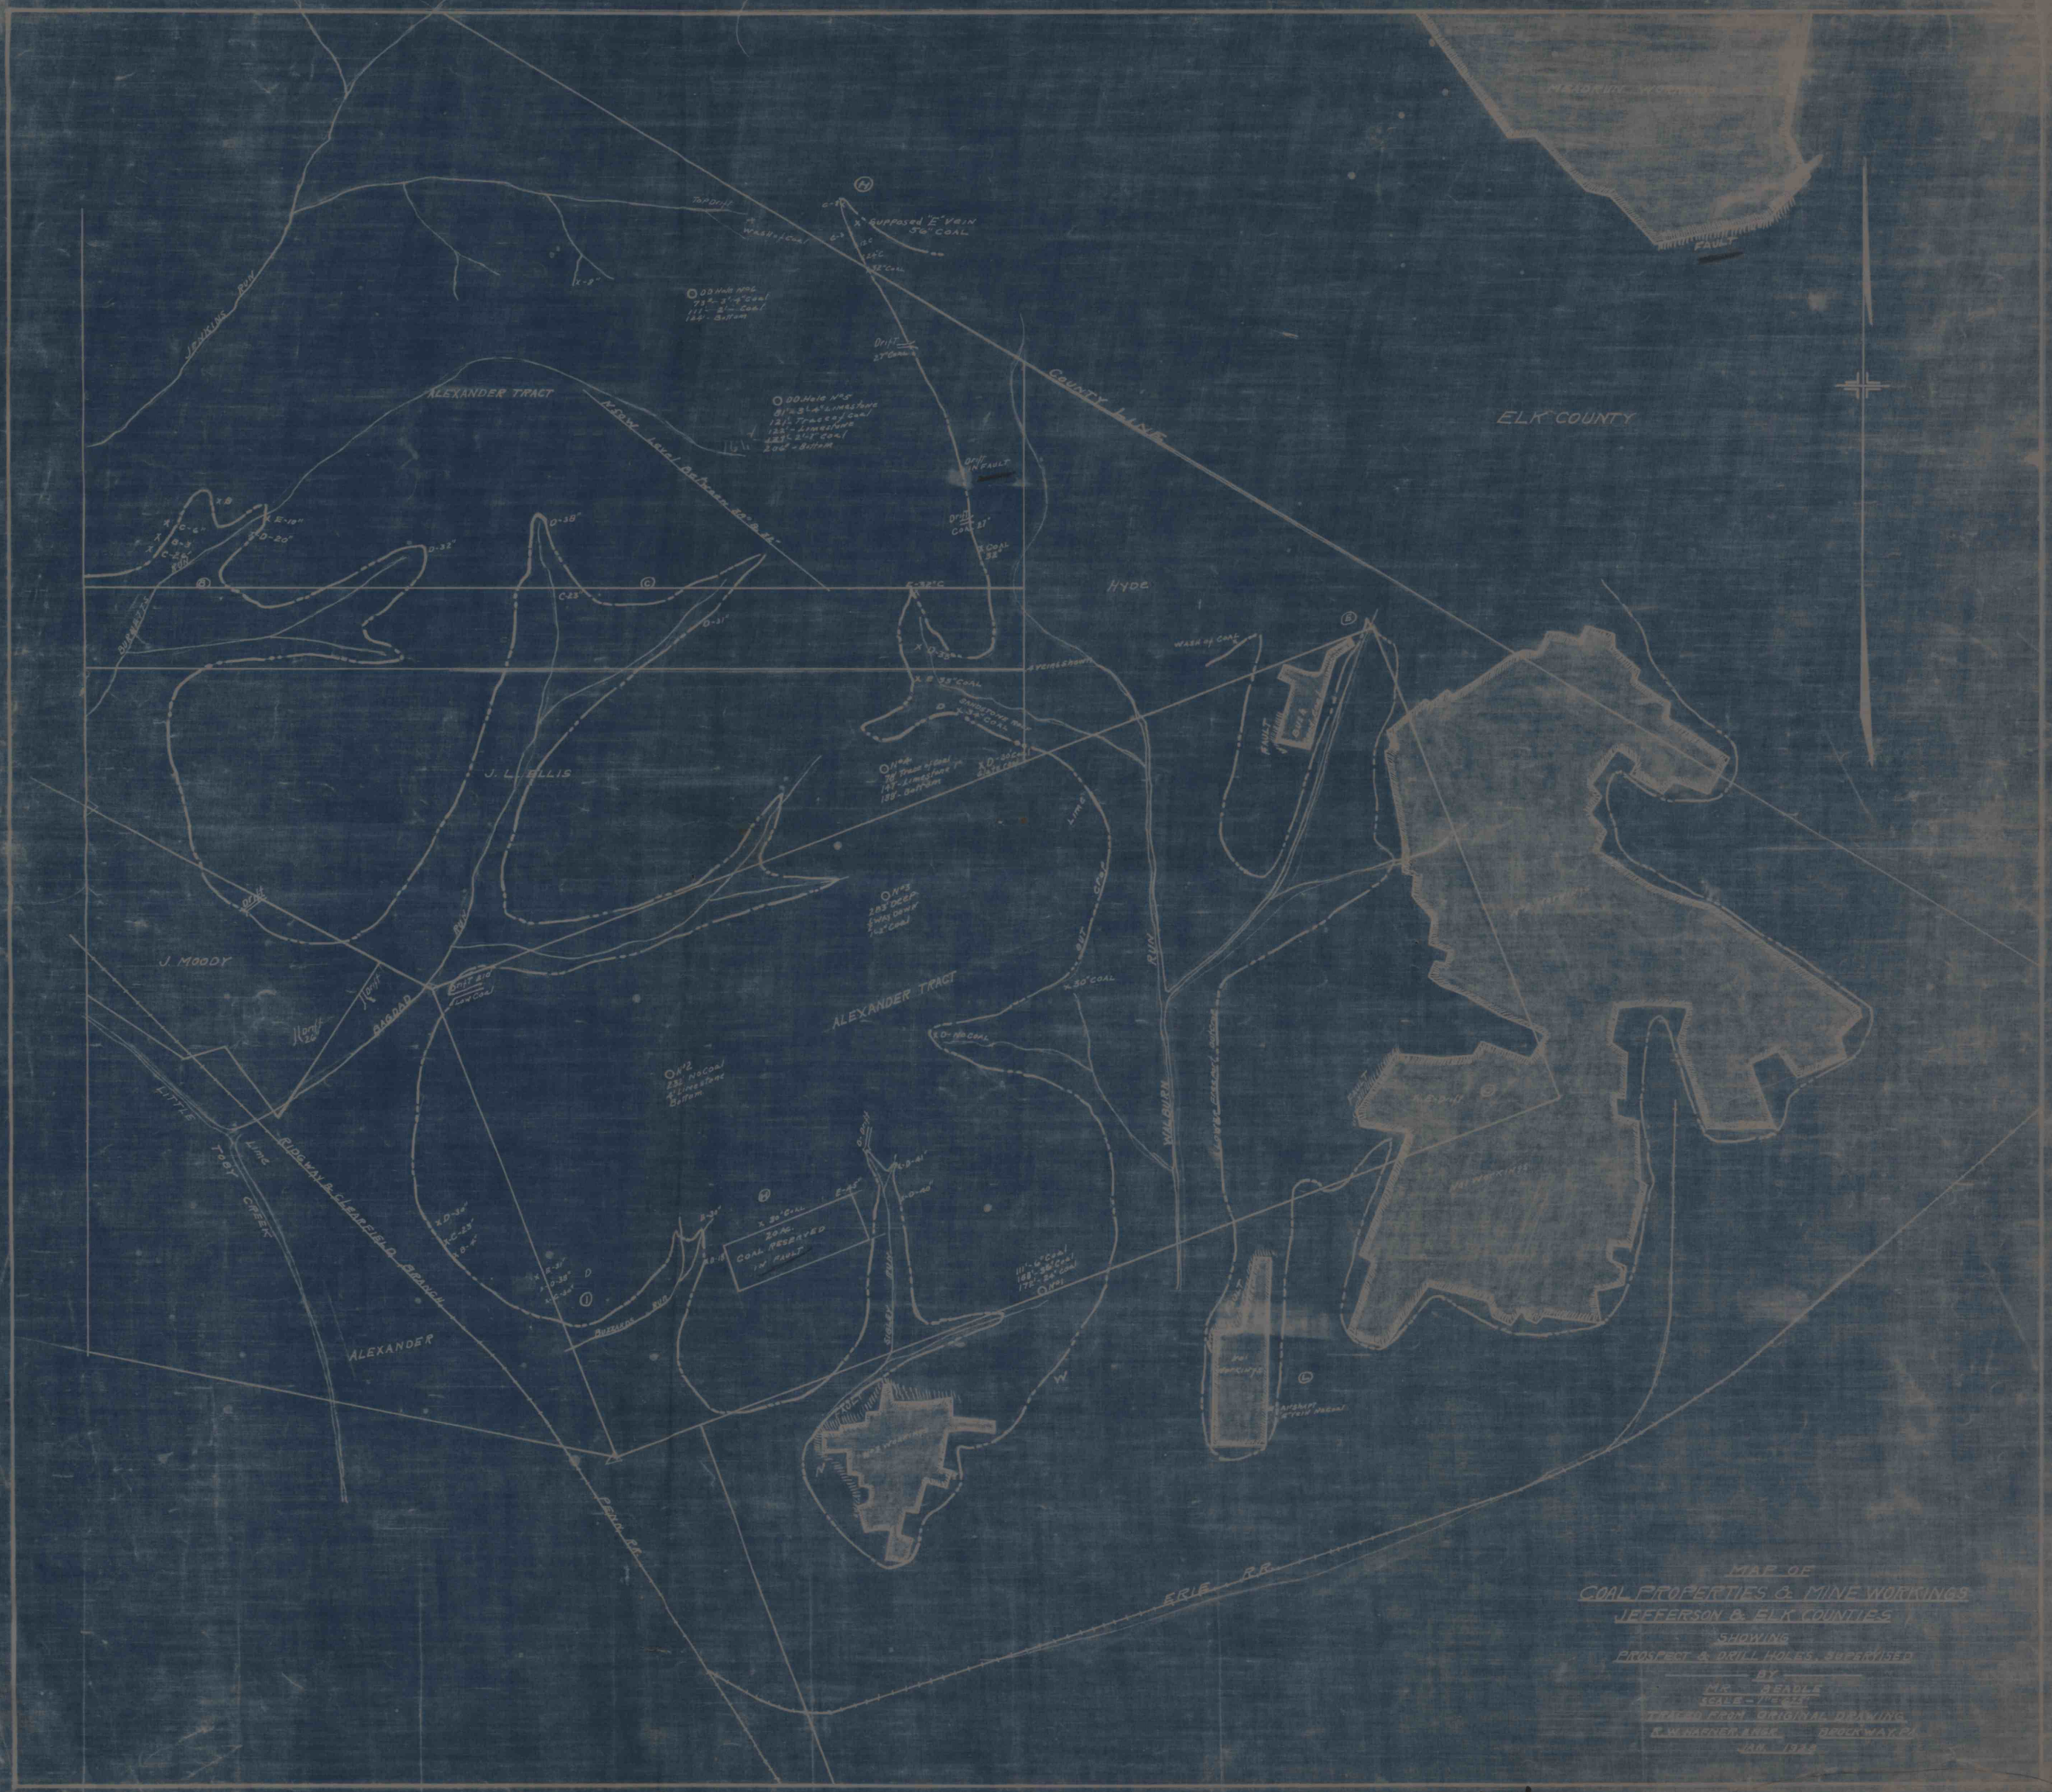
ELK COUNTY
COUNTY LINE
ALEXANDER TRACT
J. L. ELLIS
J. MOODY
HYDE
ALEXANDER
LITTLE TOBY CREEK
RIDGWAY & CLEARFIELD BRANCH
ERIE R.R.
FAULT
COAL RESERVED IN FAULT
MAP OF
COAL PROPERTIES & MINE WORKINGS
JEFFERSON & ELK COUNTIES
SHOWING
PROSPECT & DRILL HOLES, SUPERIMPOSED
BY
MR. R. EARLE
SCALE: 1" = 32'
TRACED FROM ORIGINAL DRAWING
E. W. HAGNER & SON, BROOKWAY, PA.
JAN. 1924

IMAPS # 16537