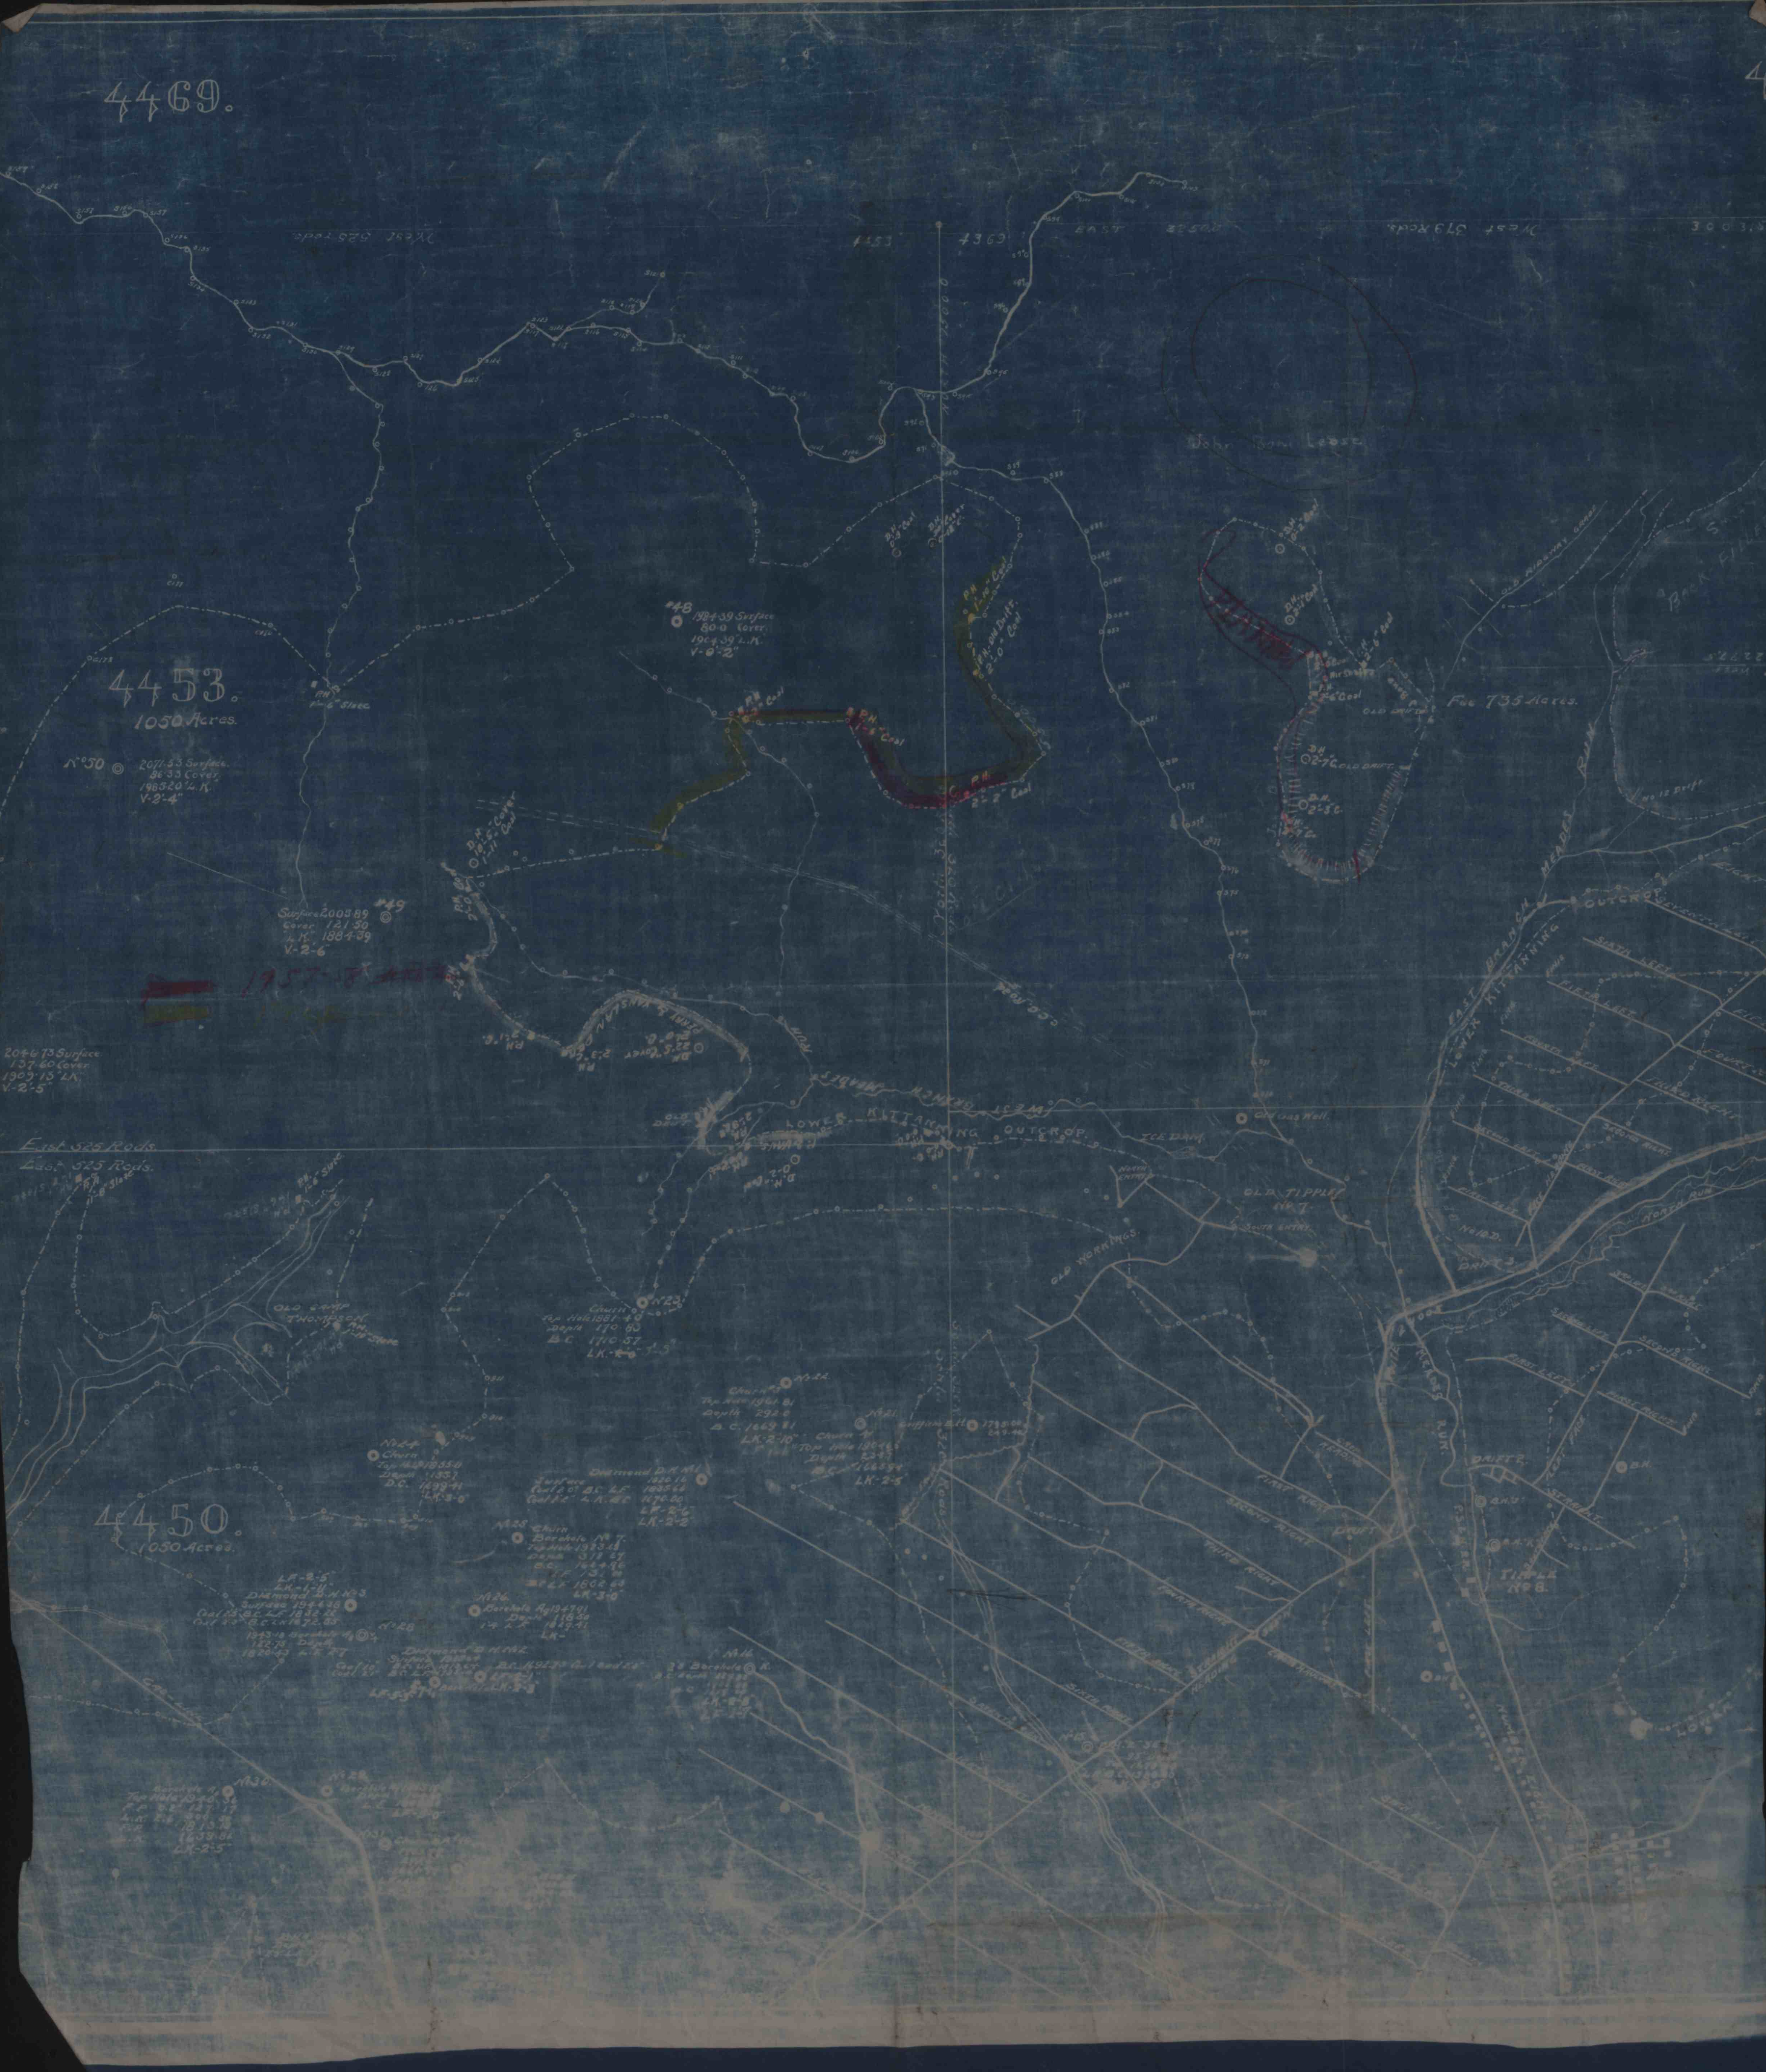
4469.
4453.
1050 Acres.
N°50 2071.53 Surface. 86.33 Cover. 1985.20 "L.K." V-2'-4"
#48 1984.39 Surface 80.0 Cover. 1904.39 "L.K." V-0'-2"
#49 Surface 2005.89 Cover 121.50 "L.K." 1884.39 V-2-6"
2046.73 Surface 137.60 Cover 1909.15 "L.K." V-2'-5"
P.H. 1'-6" Slate
D.H. 18'-5" Cover 1'-11" Coal
P.H. 1'-6" Coal
P.H. 2'-2" Coal
P.H. Old Drift 2'-0" Coal
1957-8
East 525 Rods.
East 525 Rods.
West 525 Rods
4453
4469
John Boni Lease
Fee 735 Acres.
Old Drift
Old Ridgway Grade
Back Filled
Meades Run
East Branch
Lower Kittanning Outcrop
Upper Kittanning Outcrop
Lower Kittanning Outcrop.
Old Gas Well
Ice Dam
North Entry
South Entry
Old Tipple No 7
Old Workings
Old Camp Thompson
No 23 Church
No 10 D.
Drift 3
North Run
Sixth Left
Fifth Left
Fourth Left
Third Left
Second Left
First Left
Third Right
Second Right
First Right
Seventh Left
No 12 Drift
Drift 2
Tipple No 8
4450.
1050 Acres.