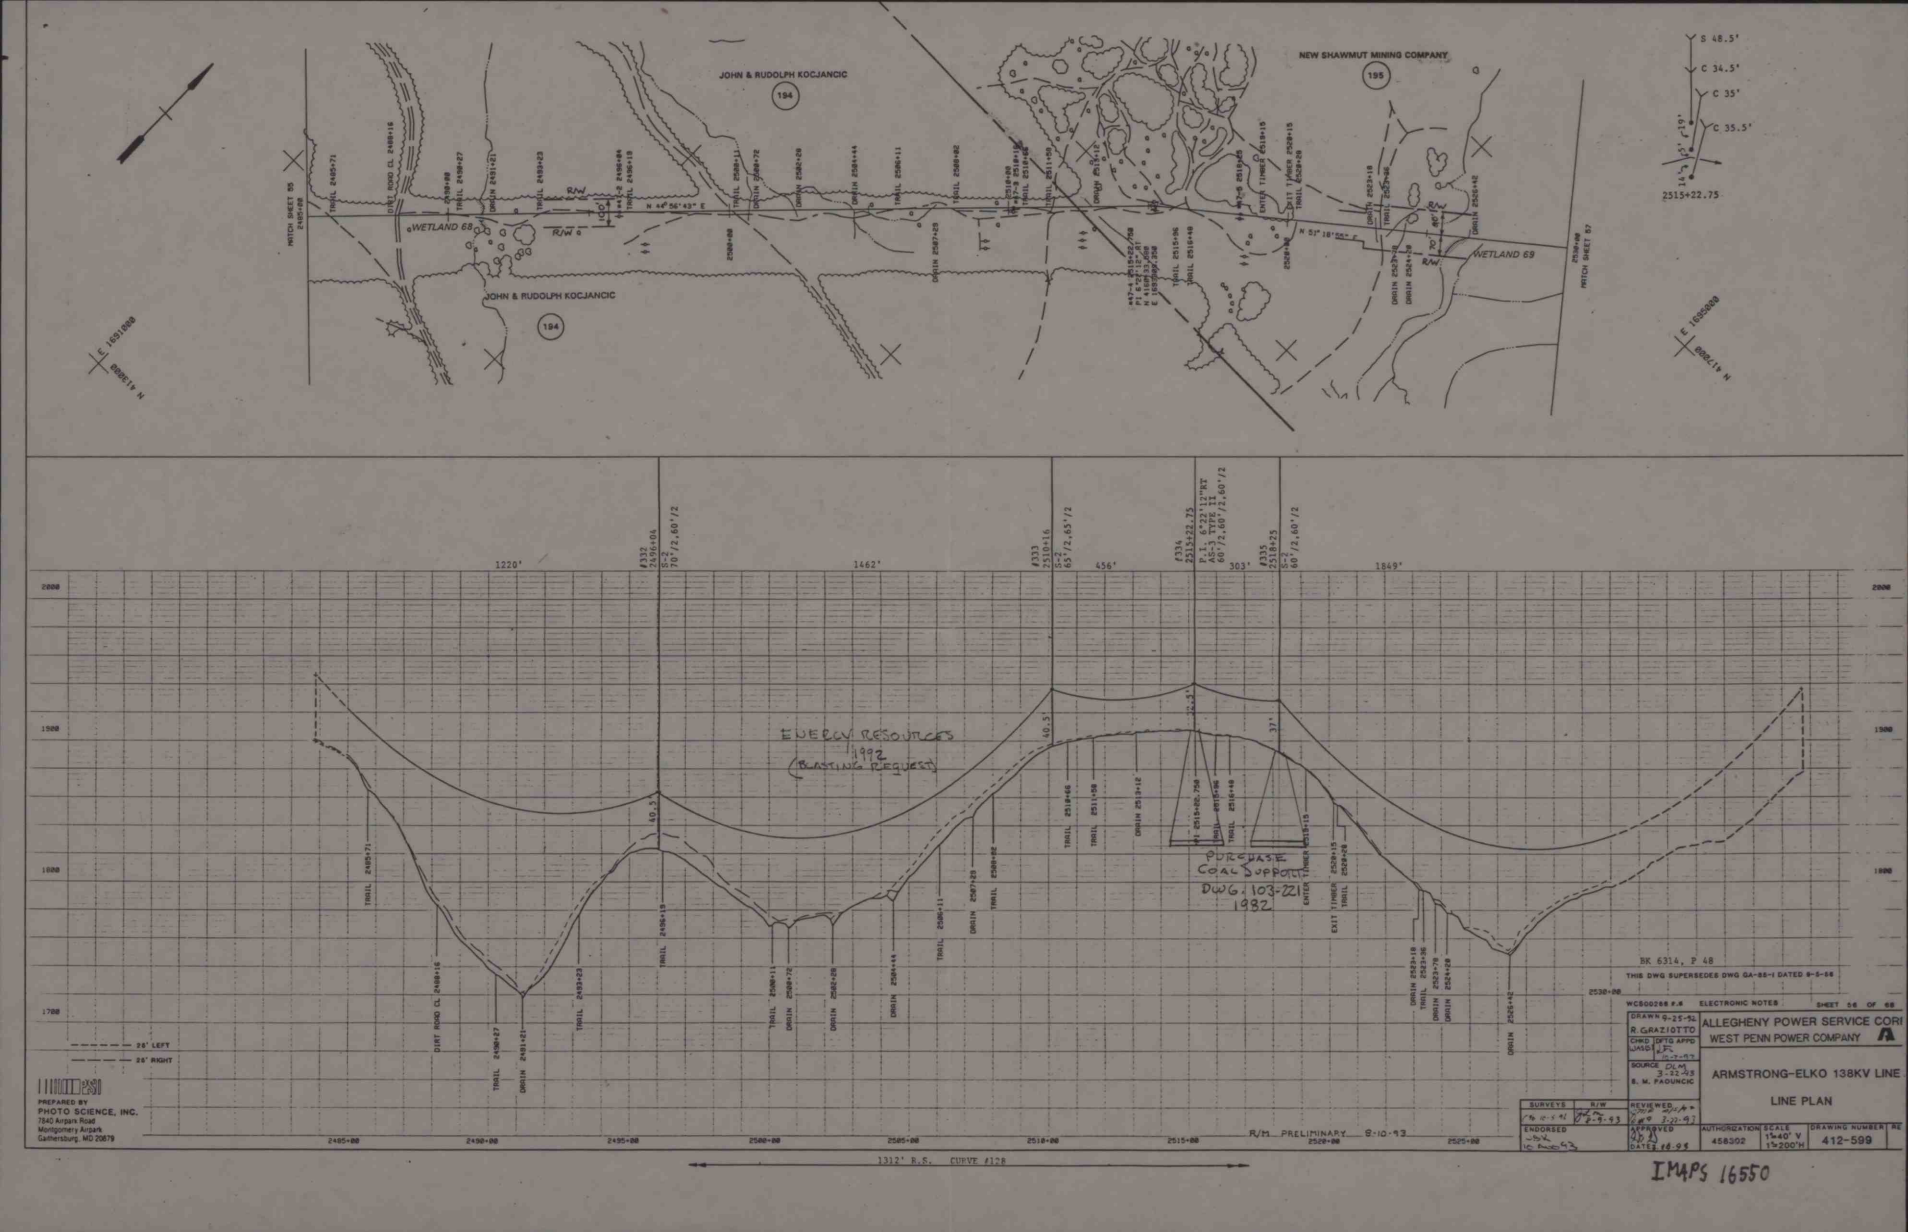
JOHN & RUDOLPH KOCJANCIC
194
NEW SHAWMUT MINING COMPANY
195
WETLAND 68
WETLAND 69
RW
N 44° 56' 43" E
N 51° 18' 55" E
MATCH SHEET 85
MATCH SHEET 87
DIRT ROAD CL 2488+16
TRAIL 2485+71
TRAIL 2490+27
DRAIN 2491+21
TRAIL 2493+23
TRAIL 2495+19
TRAIL 2508+11
DRAIN 2508+72
DRAIN 2509+28
DRAIN 2514+44
TRAIL 2516+11
TRAIL 2518+02
DRAIN 2518+12
DRAIN 2519+12
TRAIL 2523+18
TRAIL 2525+68
DRAIN 2526+42
DRAIN 2523+78
DRAIN 2524+68
DRAIN 2524+38
DRAIN 2507+25
TRAIL 2515+46
TRAIL 2516+40
ENTER TIMBER 2528+15
EXIT TIMBER 2528+78
S 48.5'
C 34.5'
C 35'
C 35.5'
2515+22.75
E 1651000
N 412000
E 1655000
N 412000
#332 2496+06 S-2 70'/2,60'/2
#333 2510+16 S-2 65'/2,65'/2
#334 2514+22.75 P.I. 65°22'13"RT AS-5 TYPE II 60'/2,60'/2,60'/2
#335 2518+25 S-2 60'/2,60'/2
1220'
1462'
456'
303'
1849'
40.5'
37'
PURCHASE COAL SUPPORT DWG 103-221 1982
28' LEFT
28' RIGHT
PREPARED BY
PHOTO SCIENCE, INC.
7840 Airpark Road
Montgomery Airpark
Gaithersburg, MD 20879
R/W PRELIMINARY 8-10-93
1312' R.S. CURVE #128
BK 6314, P 48
THIS DWG SUPERSEDES DWG GA-88-1 DATED 9-5-88
WCS00288 P.# ELECTRONIC NOTES SHEET 56 OF 68
DRAWN 9-25-92 R. GRAZIOTTO
CHKD LMSD JPC
DFTG APPD JPC 9-29-93
SOURCE DLM 3-22-93 S. M. PAOUNCIC
SURVEYS R/W
REVIEWED
APPROVED
DATES 10-8-93
ENDORSED
ALLEGHENY POWER SERVICE CORP
WEST PENN POWER COMPANY
ARMSTRONG-ELKO 138KV LINE
LINE PLAN
AUTHORIZATION 458302
SCALE 1"=40' V 1"=200'H
DRAWING NUMBER 412-599
RE
IMAPS 16550