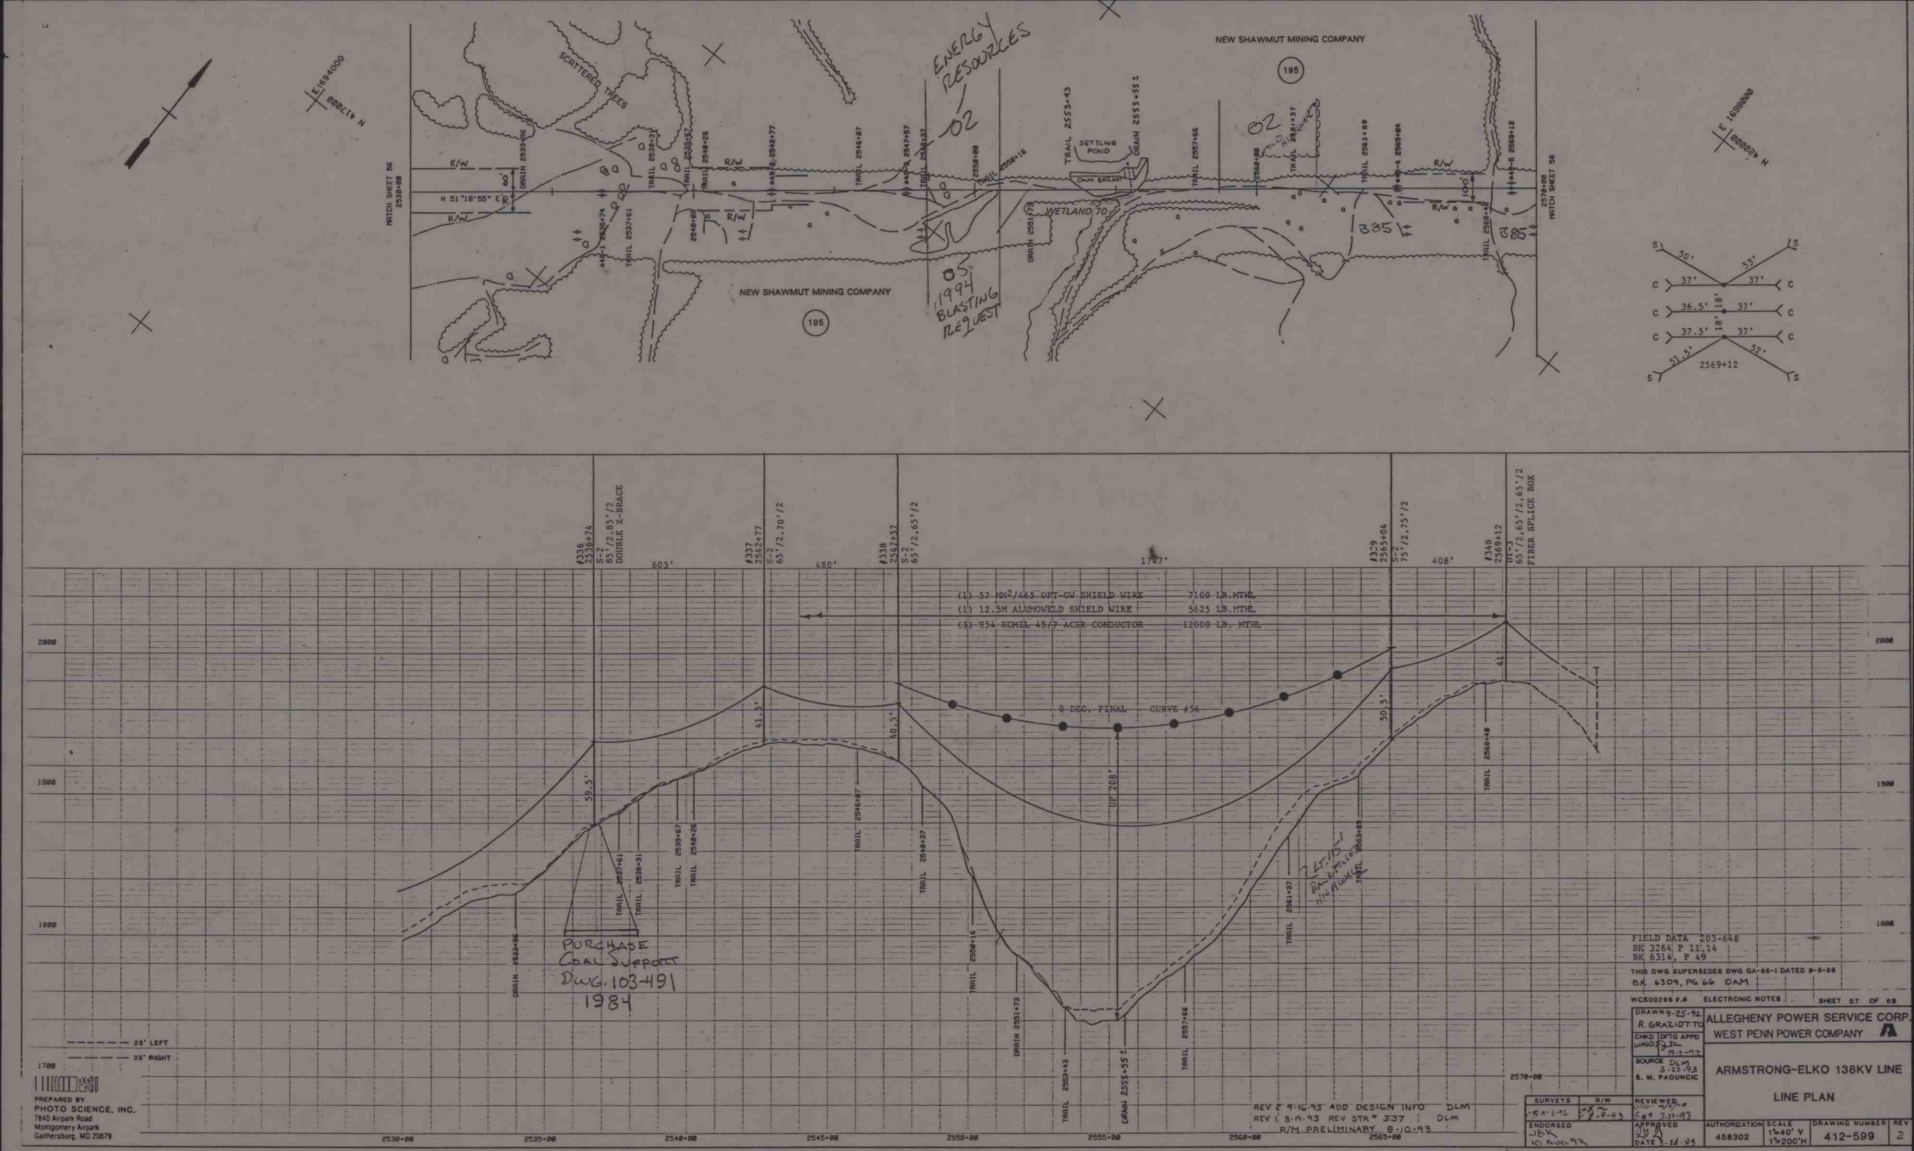
NEW SHAWMUT MINING COMPANY
ENERGY RESOURCES
SCATTERED TREES
SETTLING POND
DAM BREAK
WETLAND 70
NEW SHAWMUT MINING COMPANY
1994 BLASTING REQUEST
MATCH SHEET 56
MATCH SHEET 58
N 51°18'55" E
R/W
(1) 57-10(2)/465 OPT-GW SHIELD WIRE 7160 LB.MTHL
(1) 12.5M ALUMOWELD SHIELD WIRE 5625 LB.MTHL
(3) 954 KCMIL 45/7 ACSR CONDUCTOR 12000 LB. MTHL
0 DEG. FINAL CURVE #56
DOUBLE X-BRACE
FIBER SPLICE BOX
PURCHASE COAL SUPPORT DWG. 103-491 1984
25' LEFT
25' RIGHT
PREPARED BY
PHOTO SCIENCE, INC.
7840 Airpark Road
Montgomery Airpark
Gaithersburg, MD 20879
REV 2 9-16-93 ADD DESIGN INFO DLM
REV 1 5-9-93 REV STR # 337 DLM
R/M PRELIMINARY 8-10-93
FIELD DATA 203-648
BK 3264 P 111,14
BK 6314, P 49
THIS DWG SUPERSEDES DWG GA-86-1 DATED 9-8-86
BK 4309, PG 66 DAM
WCS00286 F.8 ELECTRONIC NOTES
SHEET 57 OF 68
DRAWN 9-25-92 R. GRAZIOTTO
CHKD LINES 3-31-93
CHKD OPTO 15-2-92
APPD
SOURCE DLM 3-23-93 S. M. PAOUNCIC
ALLEGHENY POWER SERVICE CORP.
WEST PENN POWER COMPANY
ARMSTRONG-ELKO 138KV LINE
LINE PLAN
SURVEYS
R/W
REVIEWED
ENDORSED
APPROVED
DATE
AUTHORIZATION 458302
SCALE 1"=40' V 1"=200'H
DRAWING NUMBER 412-599
REV 2
IMAPS 16551