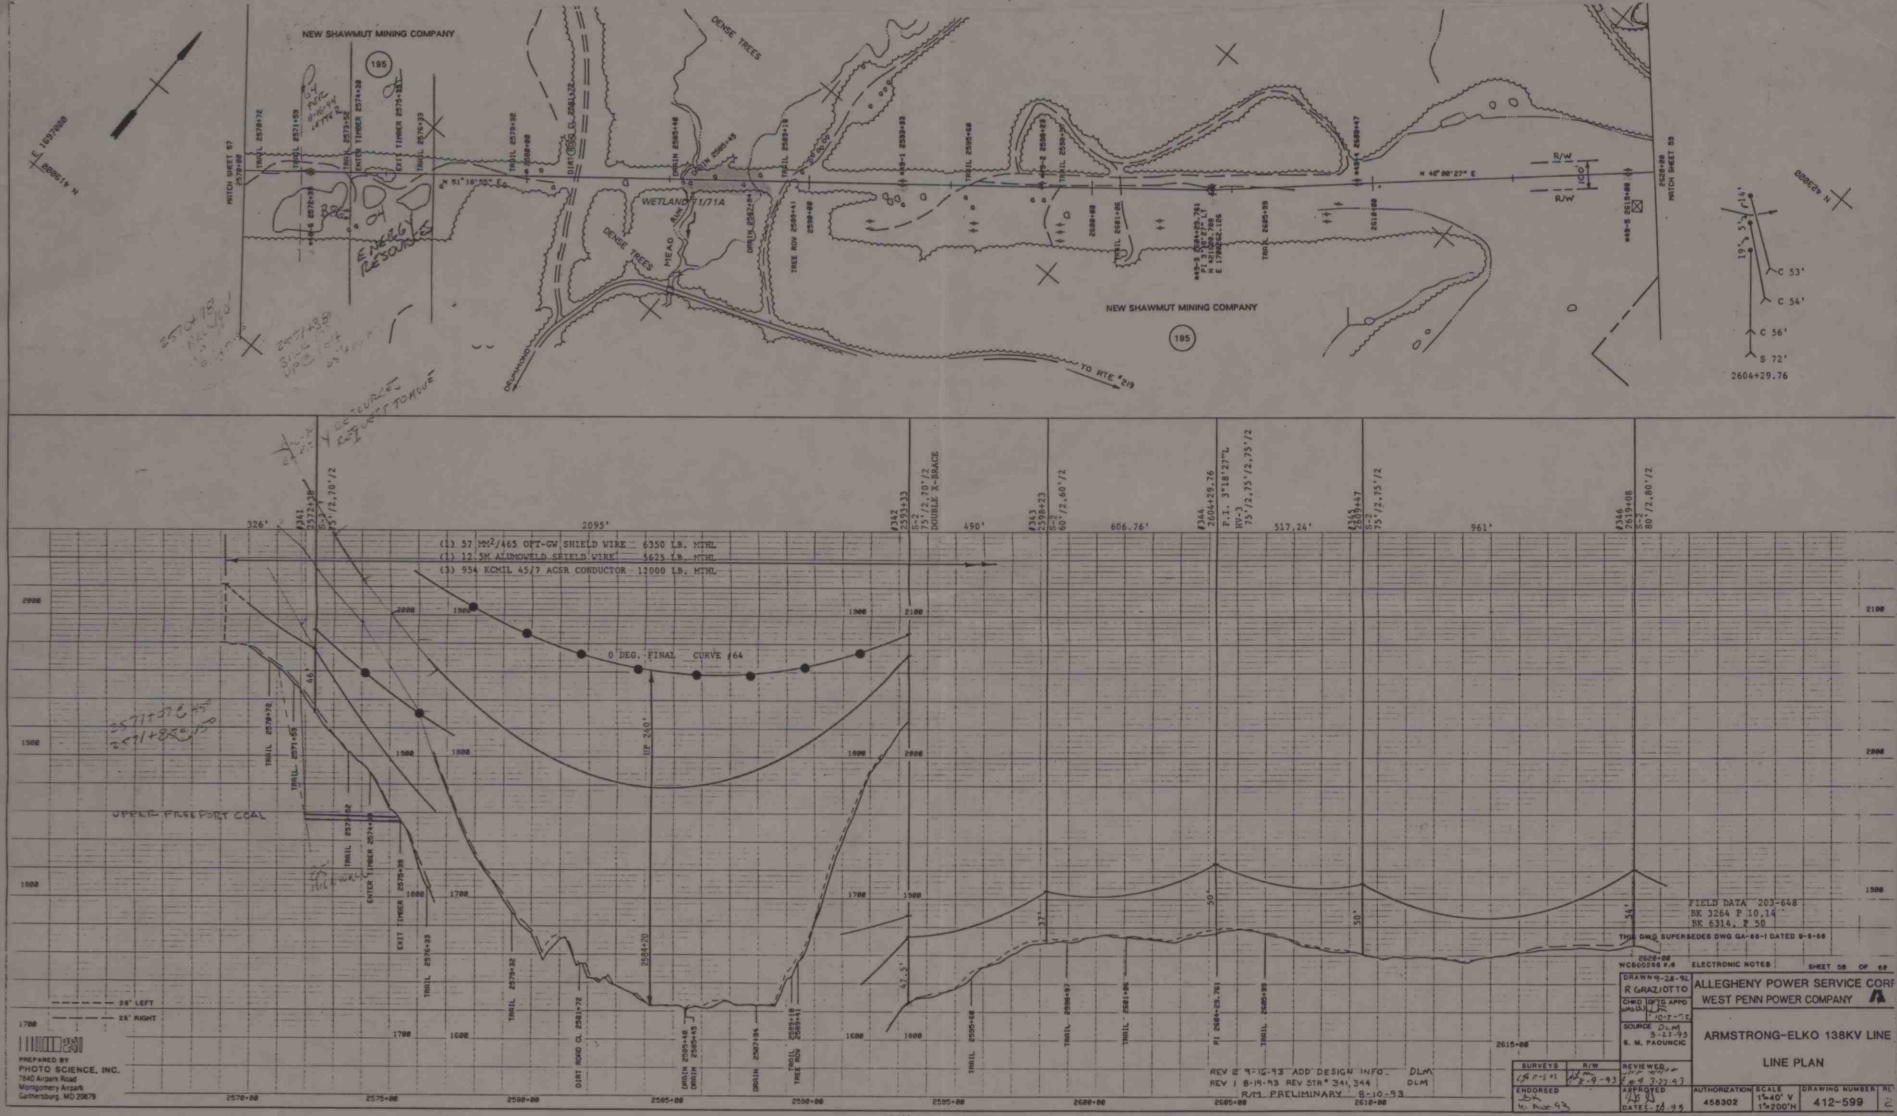
NEW SHAWMUT MINING COMPANY
195
DENSE TREES
WETLAND 11/11A
MEAD
DRAINAGE
TO RTE #219
N 48° 00' 27" E
R/W
NEW SHAWMUT MINING COMPANY
195
C 53'
C 54'
C 56'
S 72'
2604+29.76
326'
2095'
490'
606.76'
517.24'
961'
(1) 57 MM²/465 OPT-GW SHIELD WIRE 6350 LB. MTHL
(1) 12.5M ALUMOWELD SHIELD WIRE 5625 LB. MTHL
(3) 954 KCMIL 45/7 ACSR CONDUCTOR 12000 LB. MTHL
0 DEG. FINAL CURVE #64
UPPER FREEPORT COAL
25' LEFT
25' RIGHT
PREPARED BY
PHOTO SCIENCE, INC.
7840 Airpark Road
Montgomery Airpark
Gaithersburg, MD 20879
REV E 9-16-93 ADD DESIGN INFO. DLM
REV I 8-19-93 REV STA# 341, 344 DLM
RMS PRELIMINARY 8-10-93
FIELD DATA 203-648
BK 3264 P 10,14
BK 6314, P 50
THIS DWG SUPERSEDES DWG GA-88-1 DATED 9-8-88
WC860266 F.6
ELECTRONIC NOTES
SHEET 58 OF 69
DRAWN 9-28-91
R GRAZIOTTO
CHKD BY
APPD BY
SOURCE DLM
5-23-93
G. M. FAOUNCIC
ALLEGHENY POWER SERVICE CORP
WEST PENN POWER COMPANY
ARMSTRONG-ELKO 138KV LINE
LINE PLAN
SURVEYS
R/W
REVIEWED
ENDORSED
APPROVED
DATE 10-9-93
AUTHORIZATION 458302
SCALE 1"=40' V 1"=200' H
DRAWING NUMBER 412-599
REV 2

IMAPS 16552