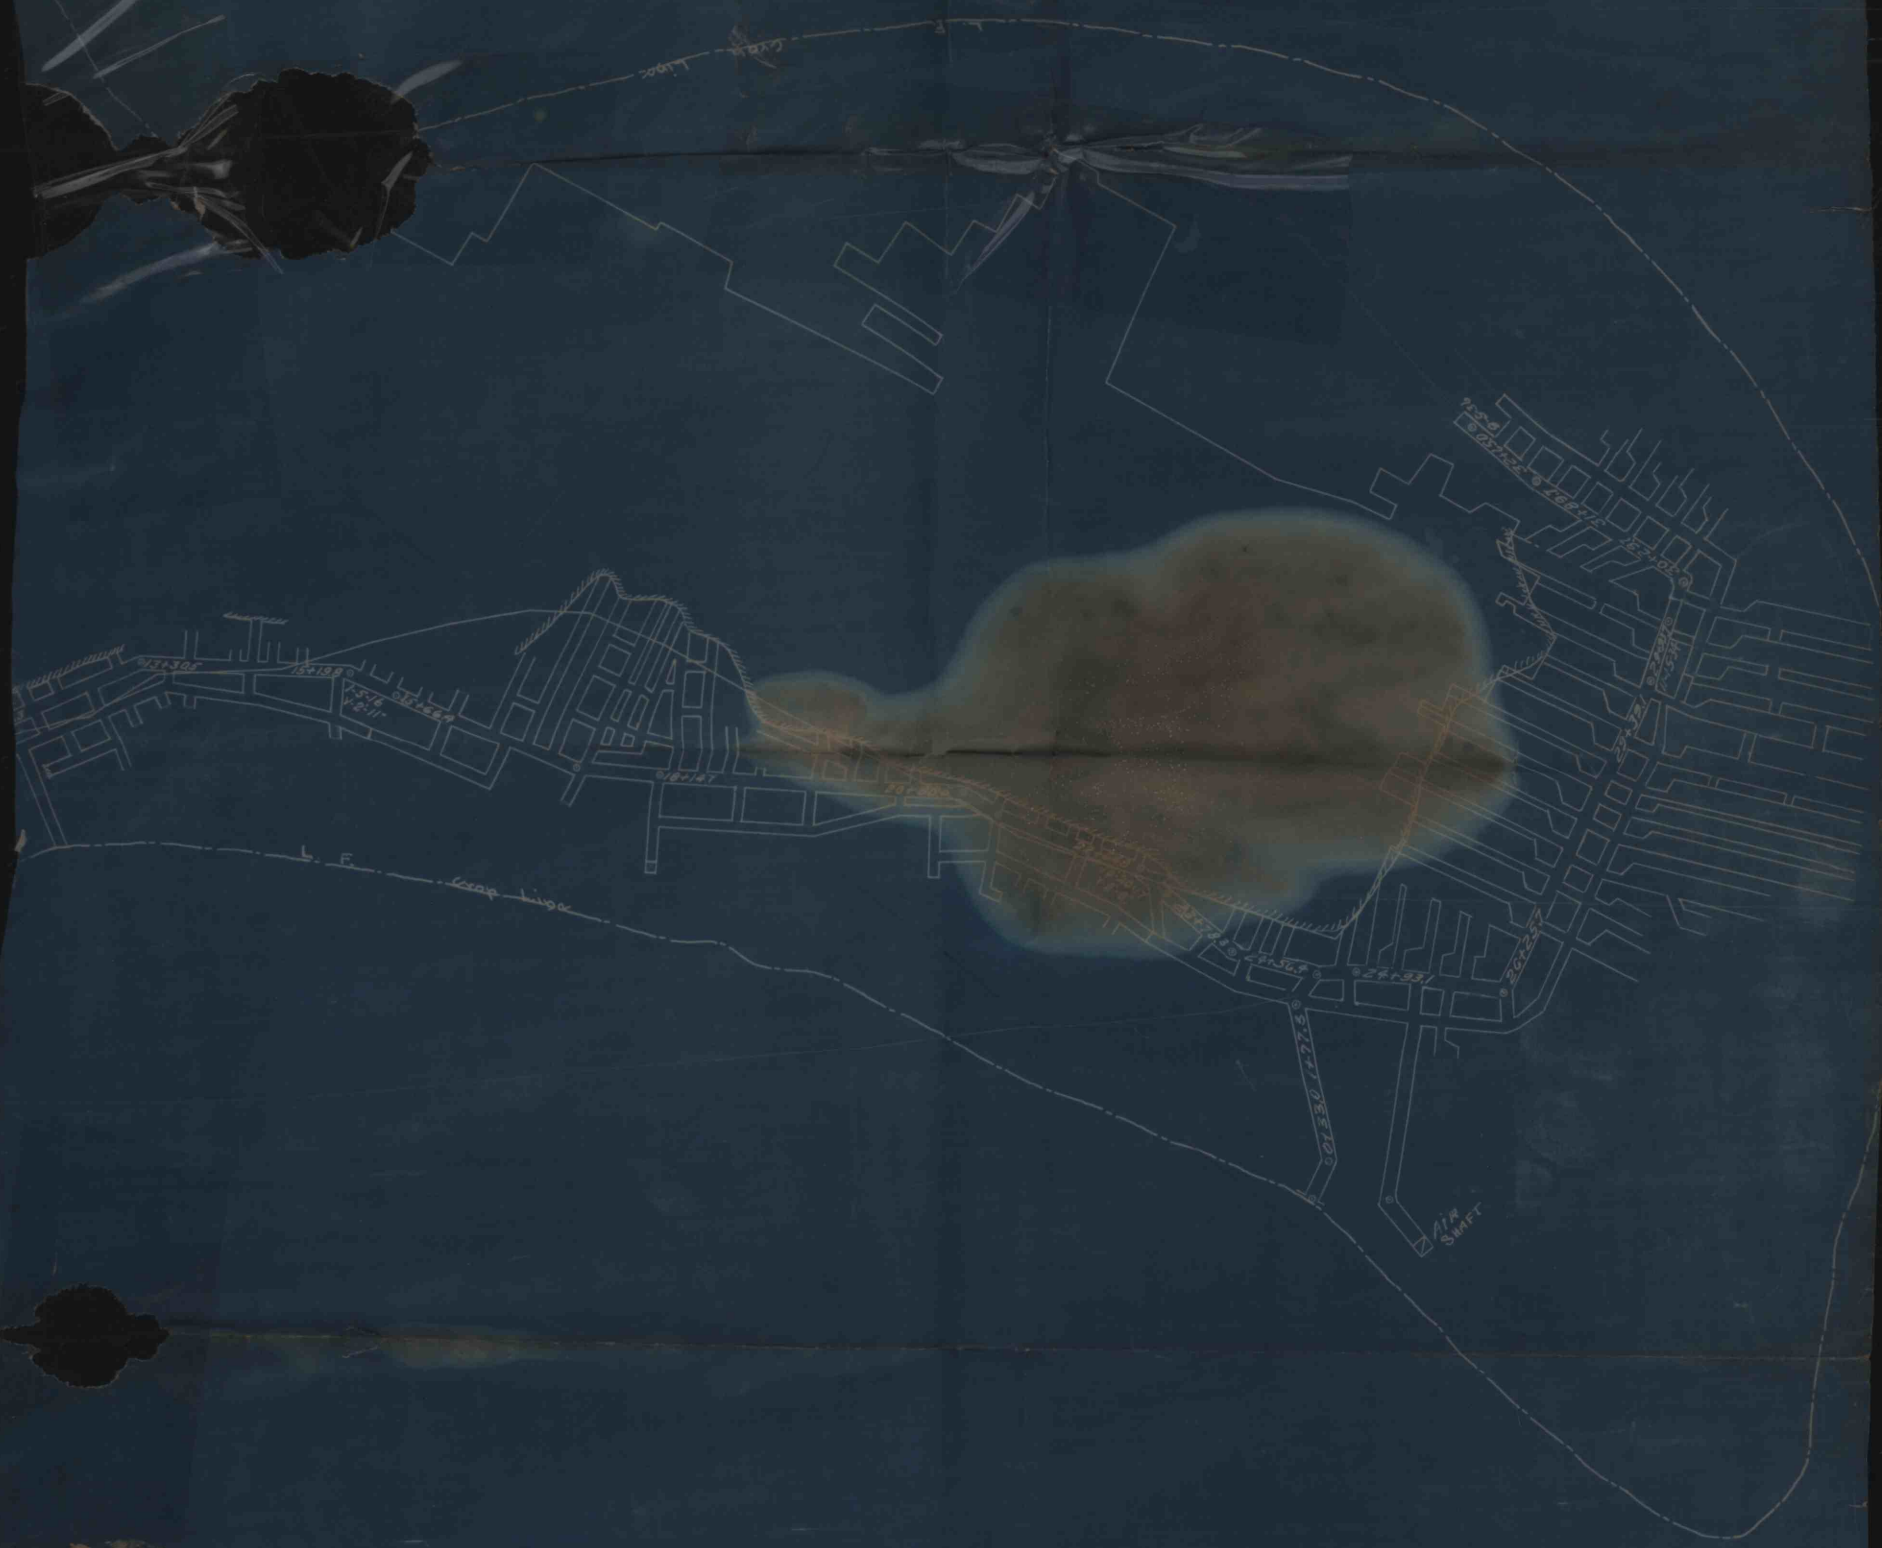

DRIFT FOR BRICK-WORKS
AND
OLD WORKINGS.
AT
SHAWMUT-PA.

Scale 1"=100'

P.A.A.
9/13/11. 10/27/14
5/2/13 1/5/16
12/30/15 10/20/17

R.R.B.
11-15-34
8-5-36

Number-	538
Date-	July-5-'12.
Scale-	1"=100'
Now Tracing by-	P.A.A.
Approved	Chief Engr.

R. W. BRIAN, MINE
SHAWMUT PA.

IMAPS #16557