


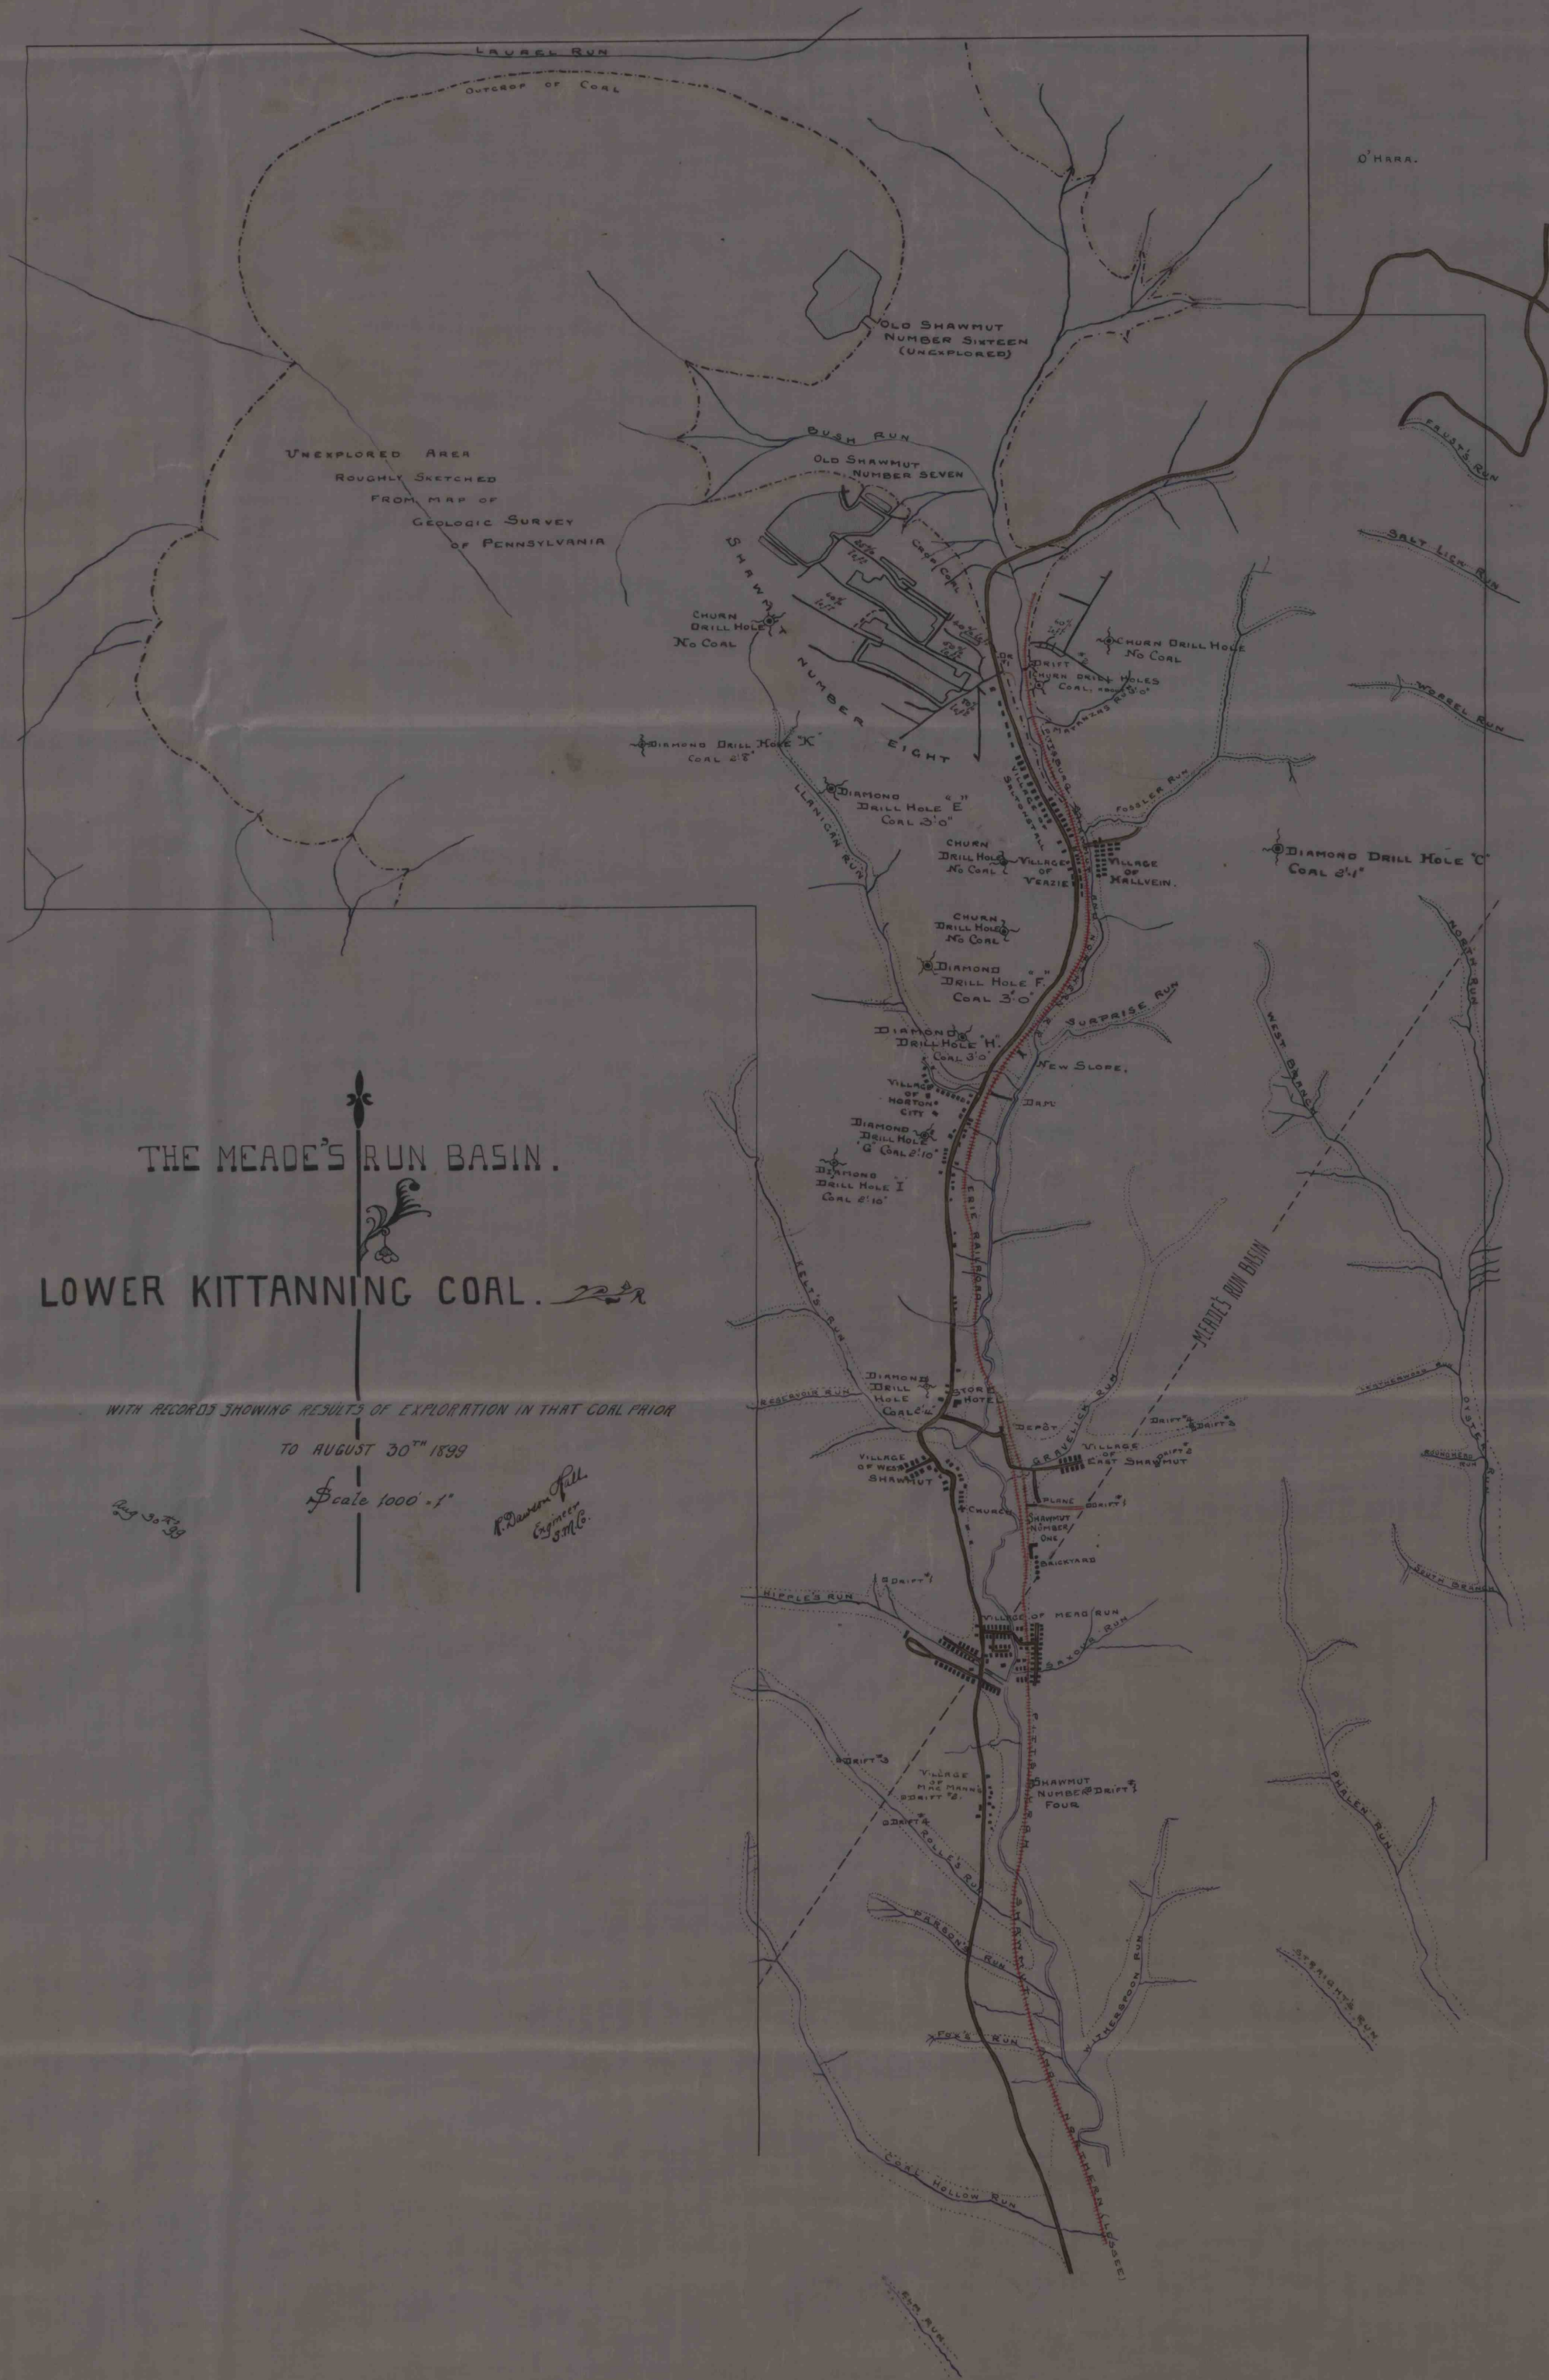

THE MEADE'S RUN BASIN.  
 LOWER KITTANNING COAL.

WITH RECORDS SHOWING RESULTS OF EXPLORATION IN THAT COAL PRIOR  
 TO AUGUST 30<sup>TH</sup> 1899

Scale 1000' = 1"

*A. Dawson*  
 Engineer  
 1899