


IMAPS # 16576

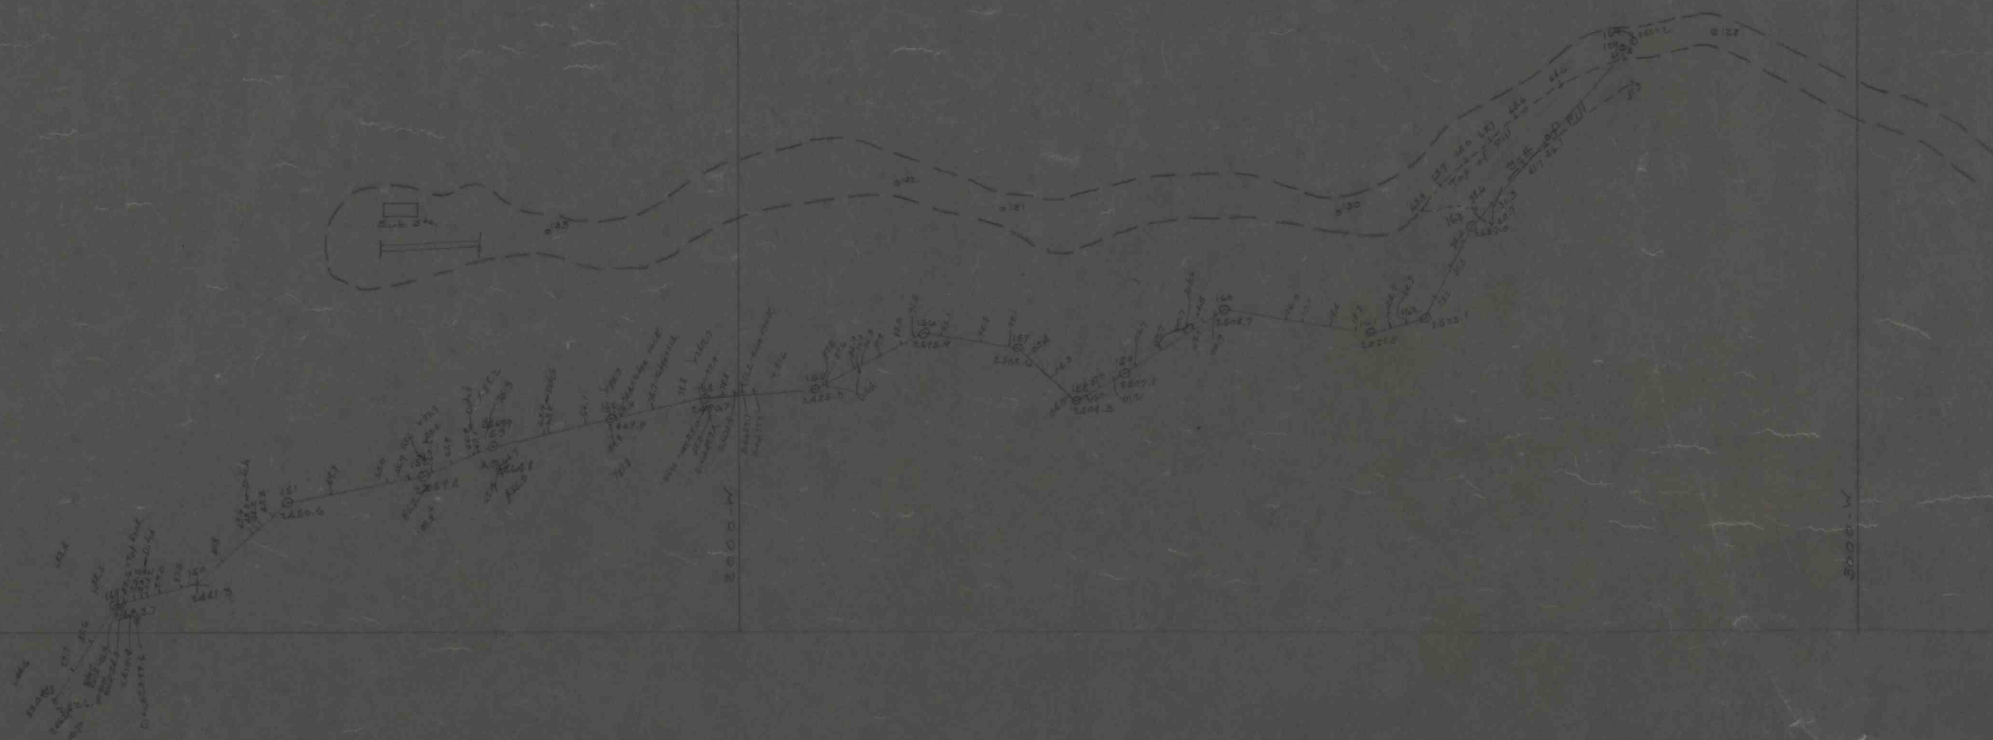

12.000 N

12.000 N