


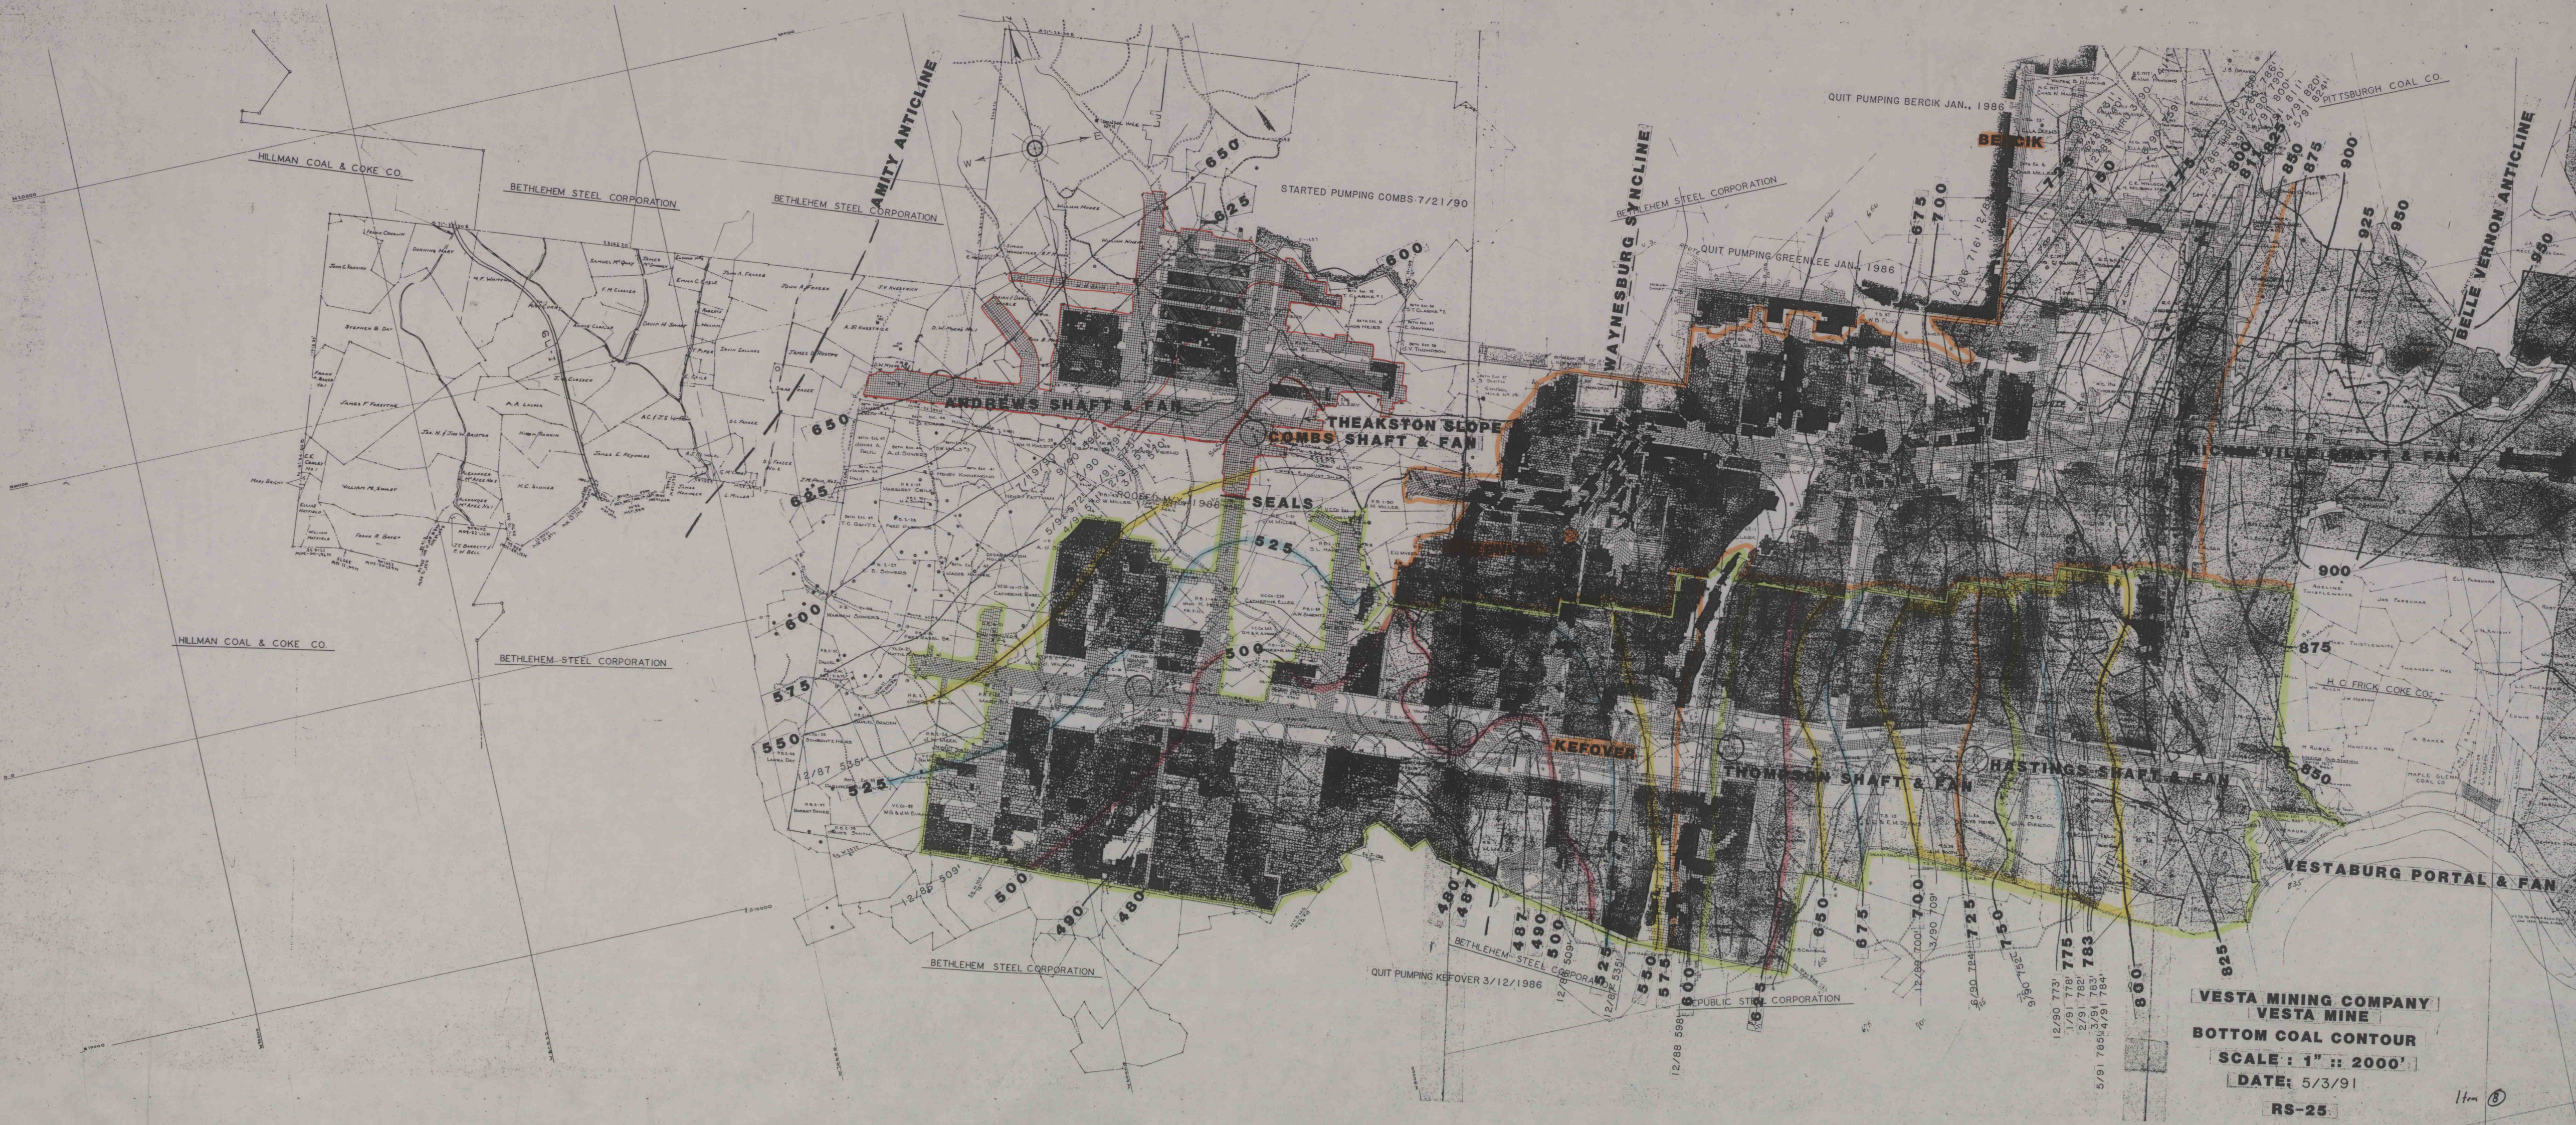

VESTA MINING COMPANY
VESTA MINE
BOTTOM COAL CONTOUR
SCALE: 1" = 2000'
DATE: 5/3/91
RS-25

IMAPS#16604