




MATCH TO SHEET 2

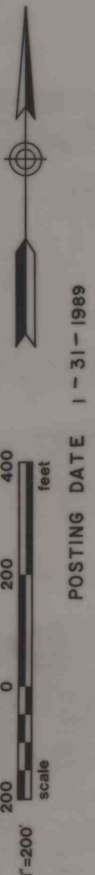

IMAPS# 16607

JANE MINE (MSHA) No. 3600823
JANE MINE PERMIT (DER) No. 03831305
MATCH TO SHEET 5

(COAL SEAM)
LOWER FREEPORT
JANE MINE
KEYSTONE COAL MINING CORP.
PLUMCREEK & COWANSHANNOCK TWP. ARMSTRONG CO.