
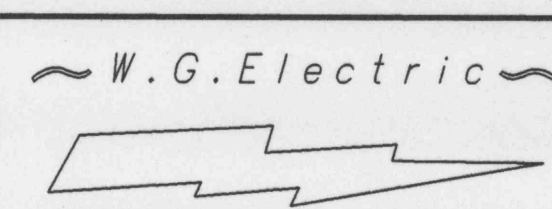
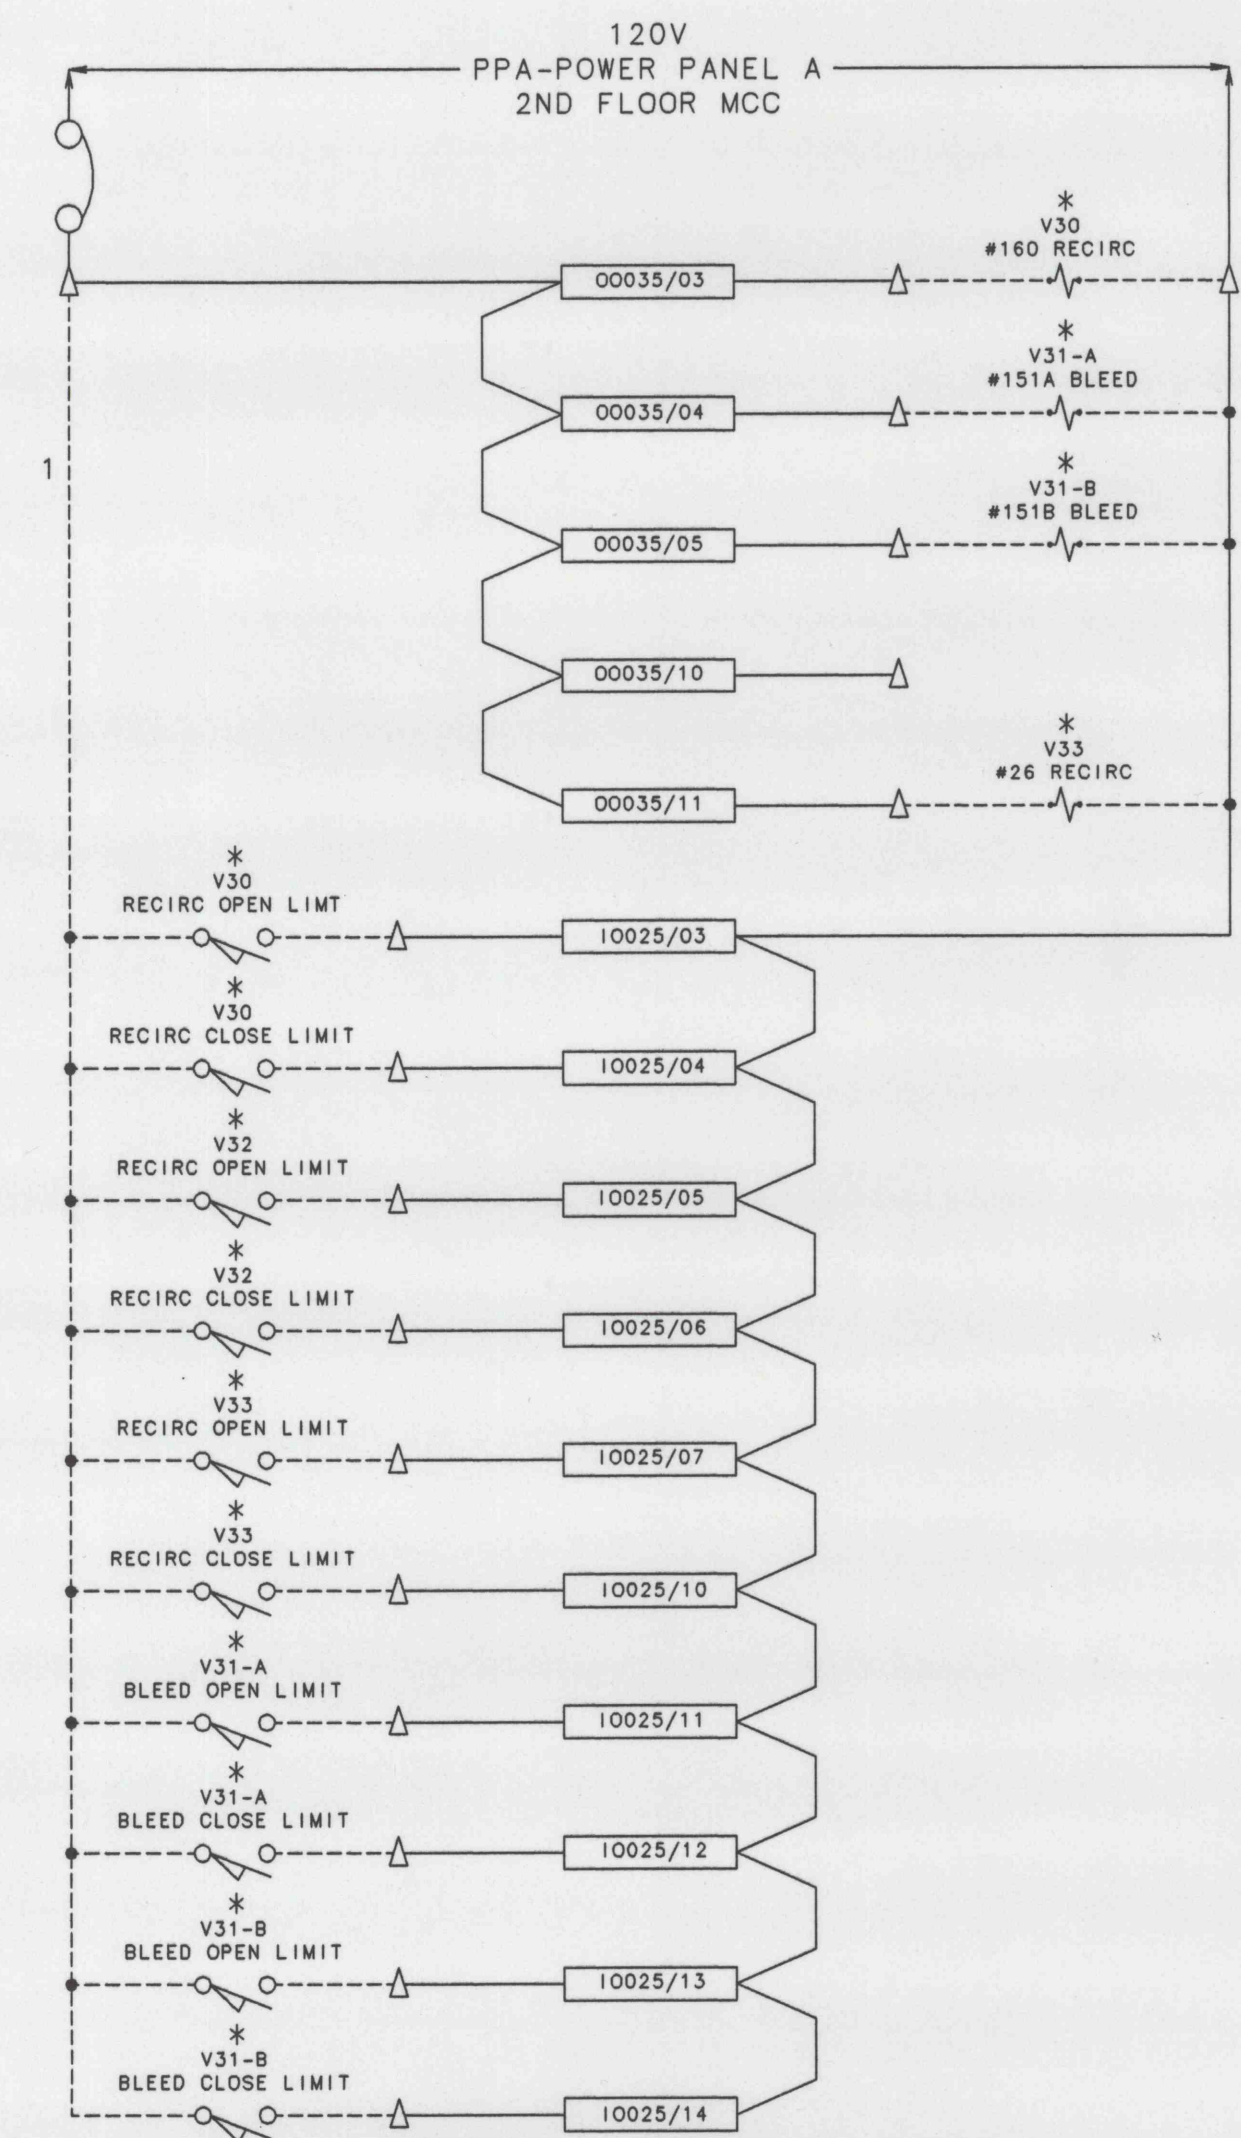


ANALOG INPUTS

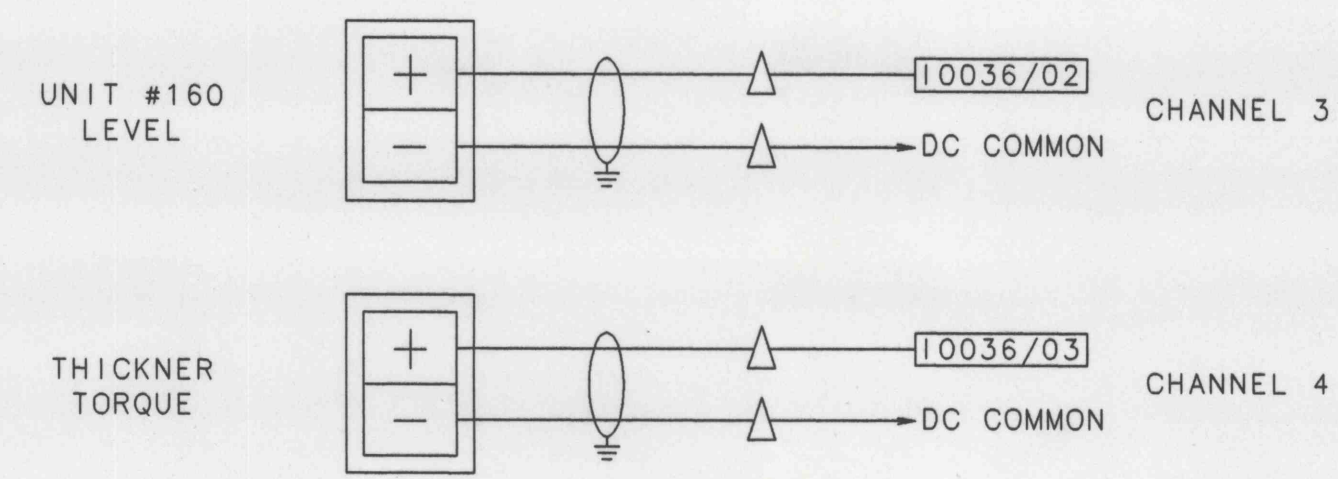

REVISION DESCRIPTION	MADE BY	DATE	CHECKED BY	DATE
1 CHANGES IN CIRCUIT	RAH	11/17/95		

DRAWN BY	RAH	DATE	02/24/95
DESIGNED BY		DATE	
CHECKED BY		DATE	
APPROVED BY		DATE	

ROCHESTER & PITTSBURGH COAL COMPANY
KEYSTONE COAL MINING CORP.
PREPARATION PLANT MODIFICATIONS
ELECTRICAL SCHEMATIC

NO. DWS. THIS PROJECT	NONE	PROJECT NO.	93-123
DRAWING NO.	EL-21	FILE NO.	93-123-EL21