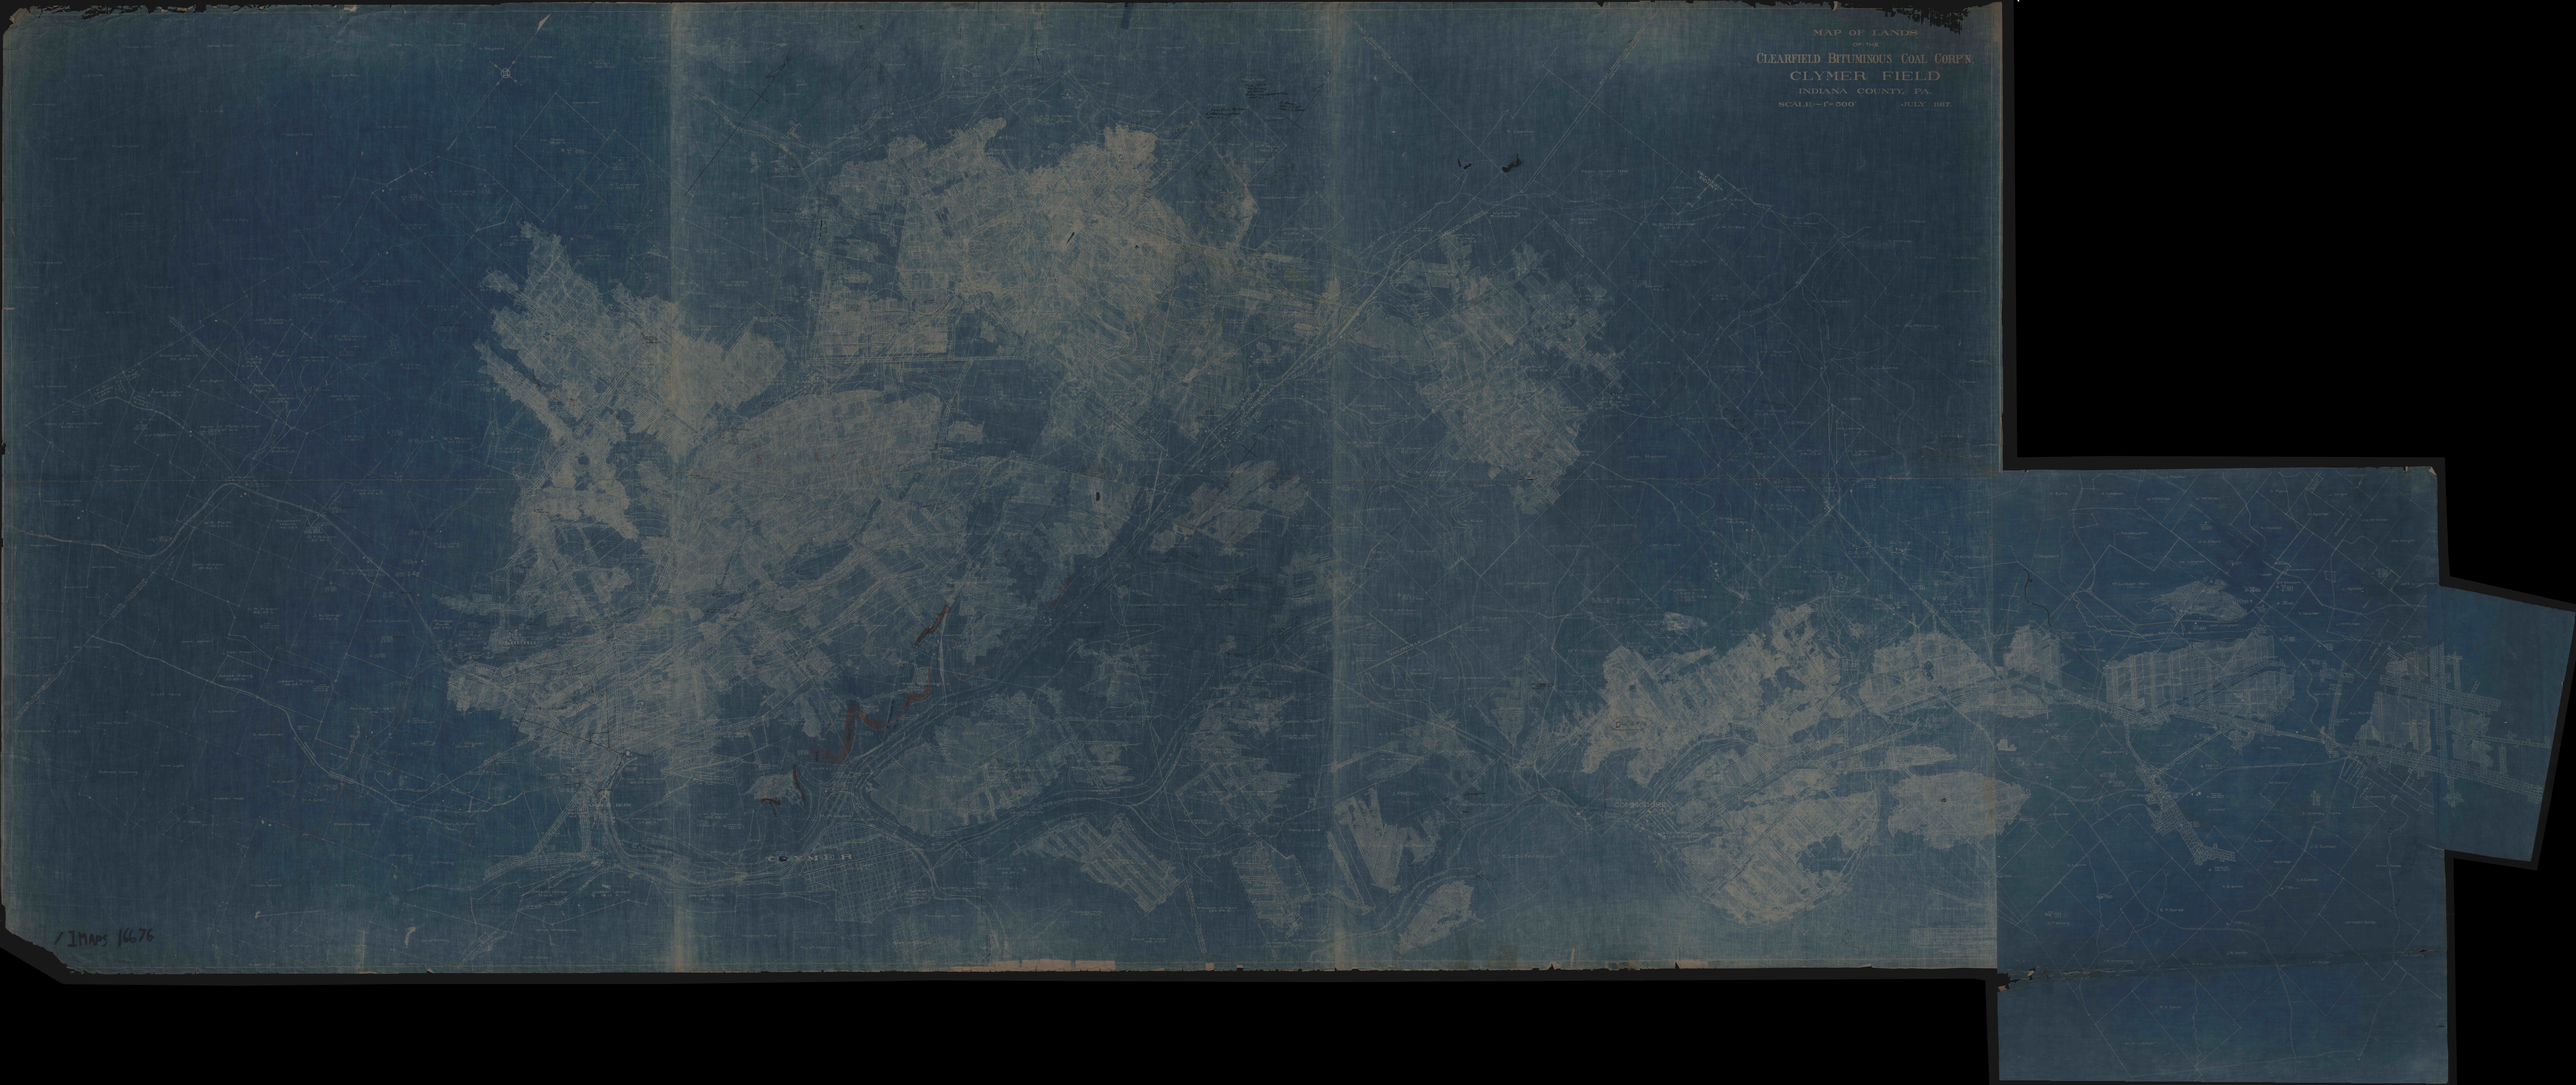

MAP OF LANDS
OF THE
CLEARFIELD BITUMINOUS COAL CORP'N.
CLYMER FIELD
INDIANA COUNTY, PA.
SCALE-1"=500'
JULY 1917.
CLYMER

/ Maps 16676