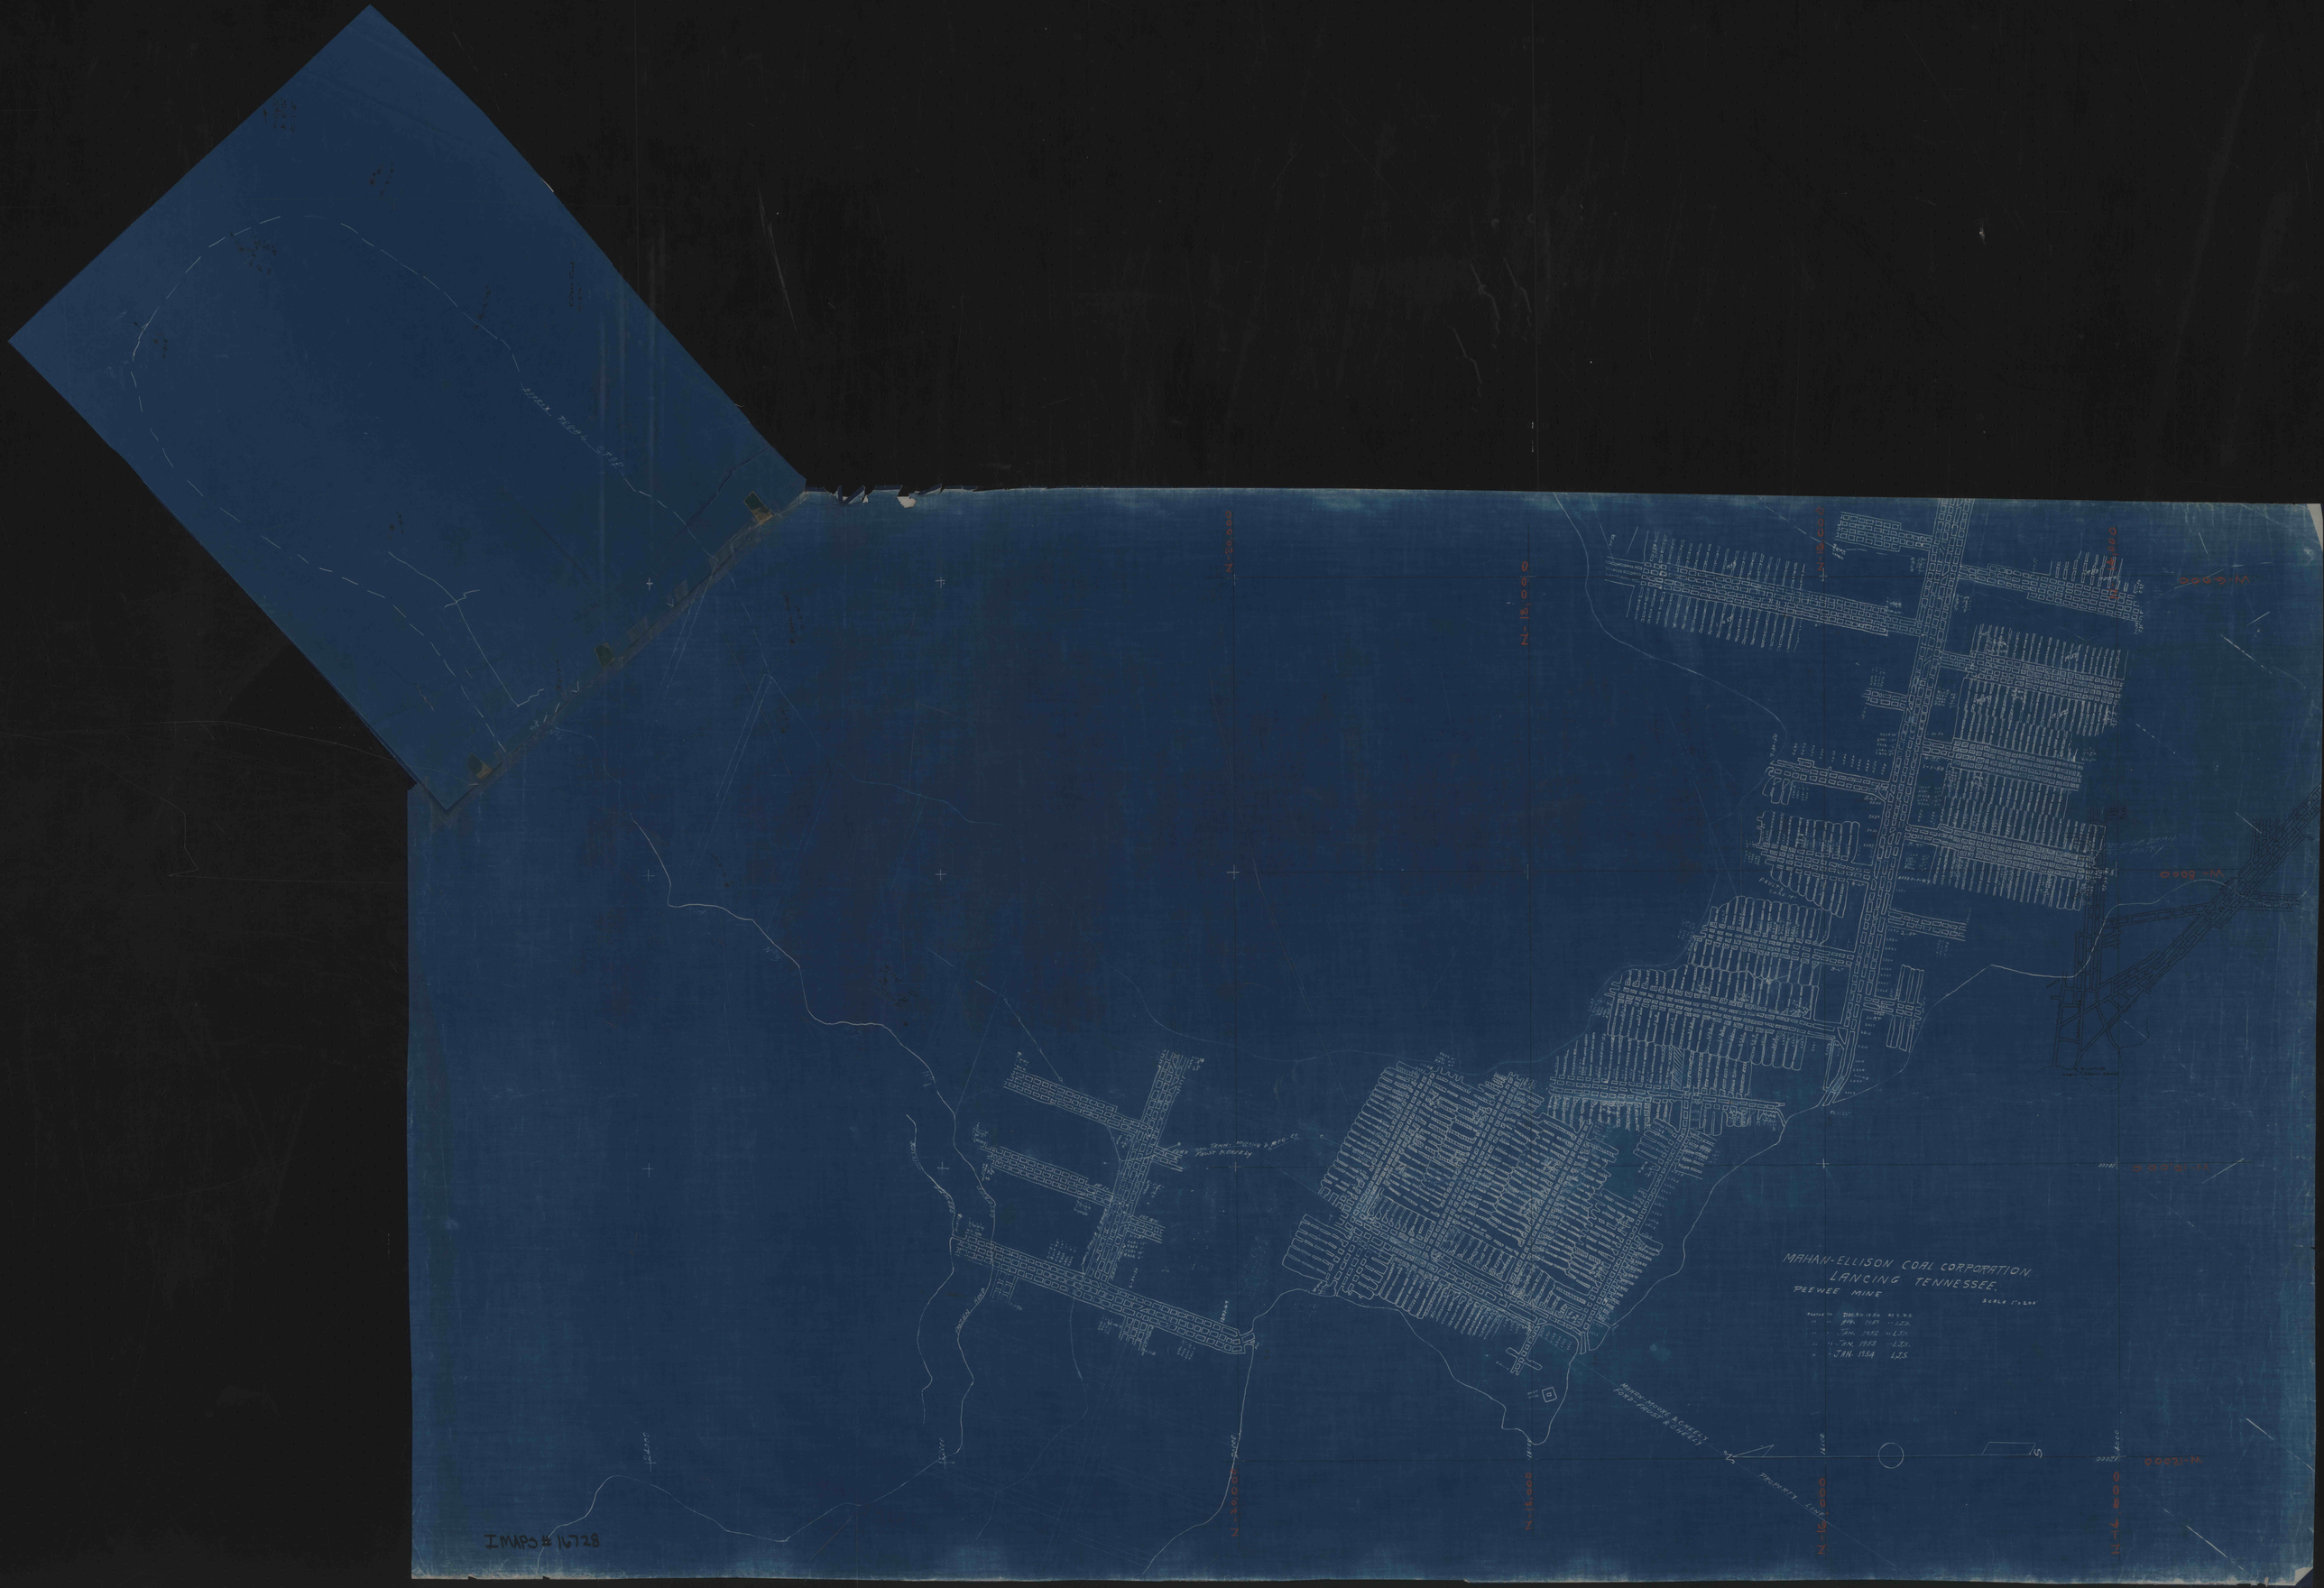
MAHAN-ELLISON COAL CORPORATION
LANCING TENNESSEE.
PEEWEE MINE
SCALE 1"=200'
PROPERTY LINE
N
S

IMAPS # 16728