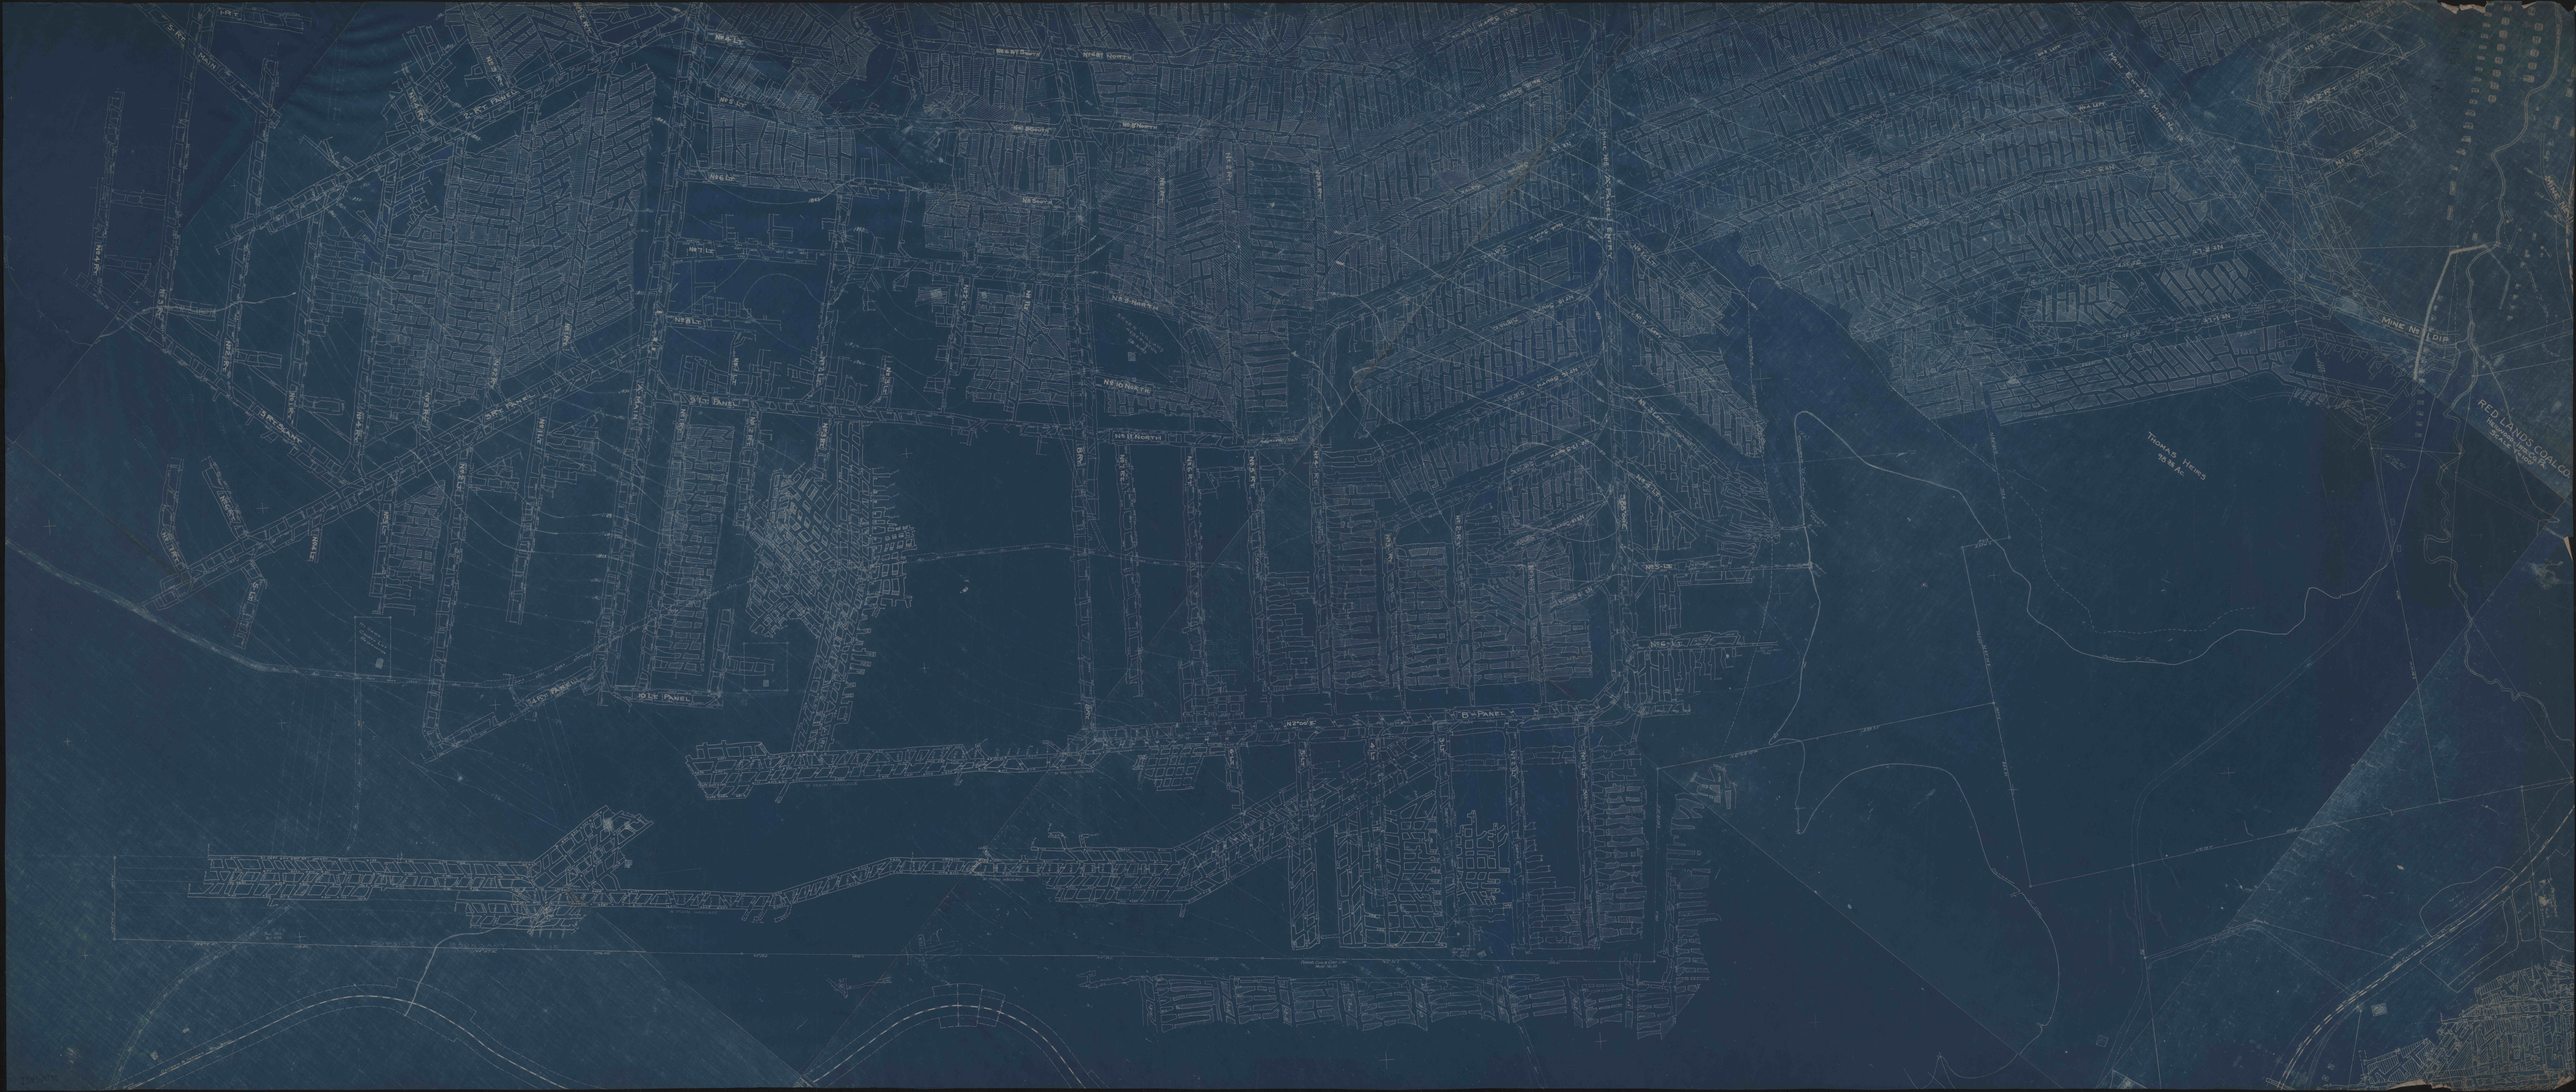
RED LANDS COAL CO.
MINE No 1 DIP.
THOMAS HEWES
B-PANEL
2ND PANEL
3RD PANEL
4TH PANEL
5TH PANEL
1ST PANEL
3RD SEAM
No 1 NORTH
No 2 NORTH
No 3 NORTH
No 4 NORTH
No 5 NORTH
No 6 NORTH
No 7 NORTH
No 8 NORTH
No 9 NORTH
No 10 NORTH
No 11 NORTH
No 1 SOUTH
No 2 SOUTH
No 3 SOUTH
No 4 SOUTH
No 5 SOUTH
No 6 SOUTH
No 7 SOUTH
No 8 SOUTH
No 9 SOUTH
No 10 SOUTH
No 11 SOUTH
No 1 E
No 2 E
