13103-151

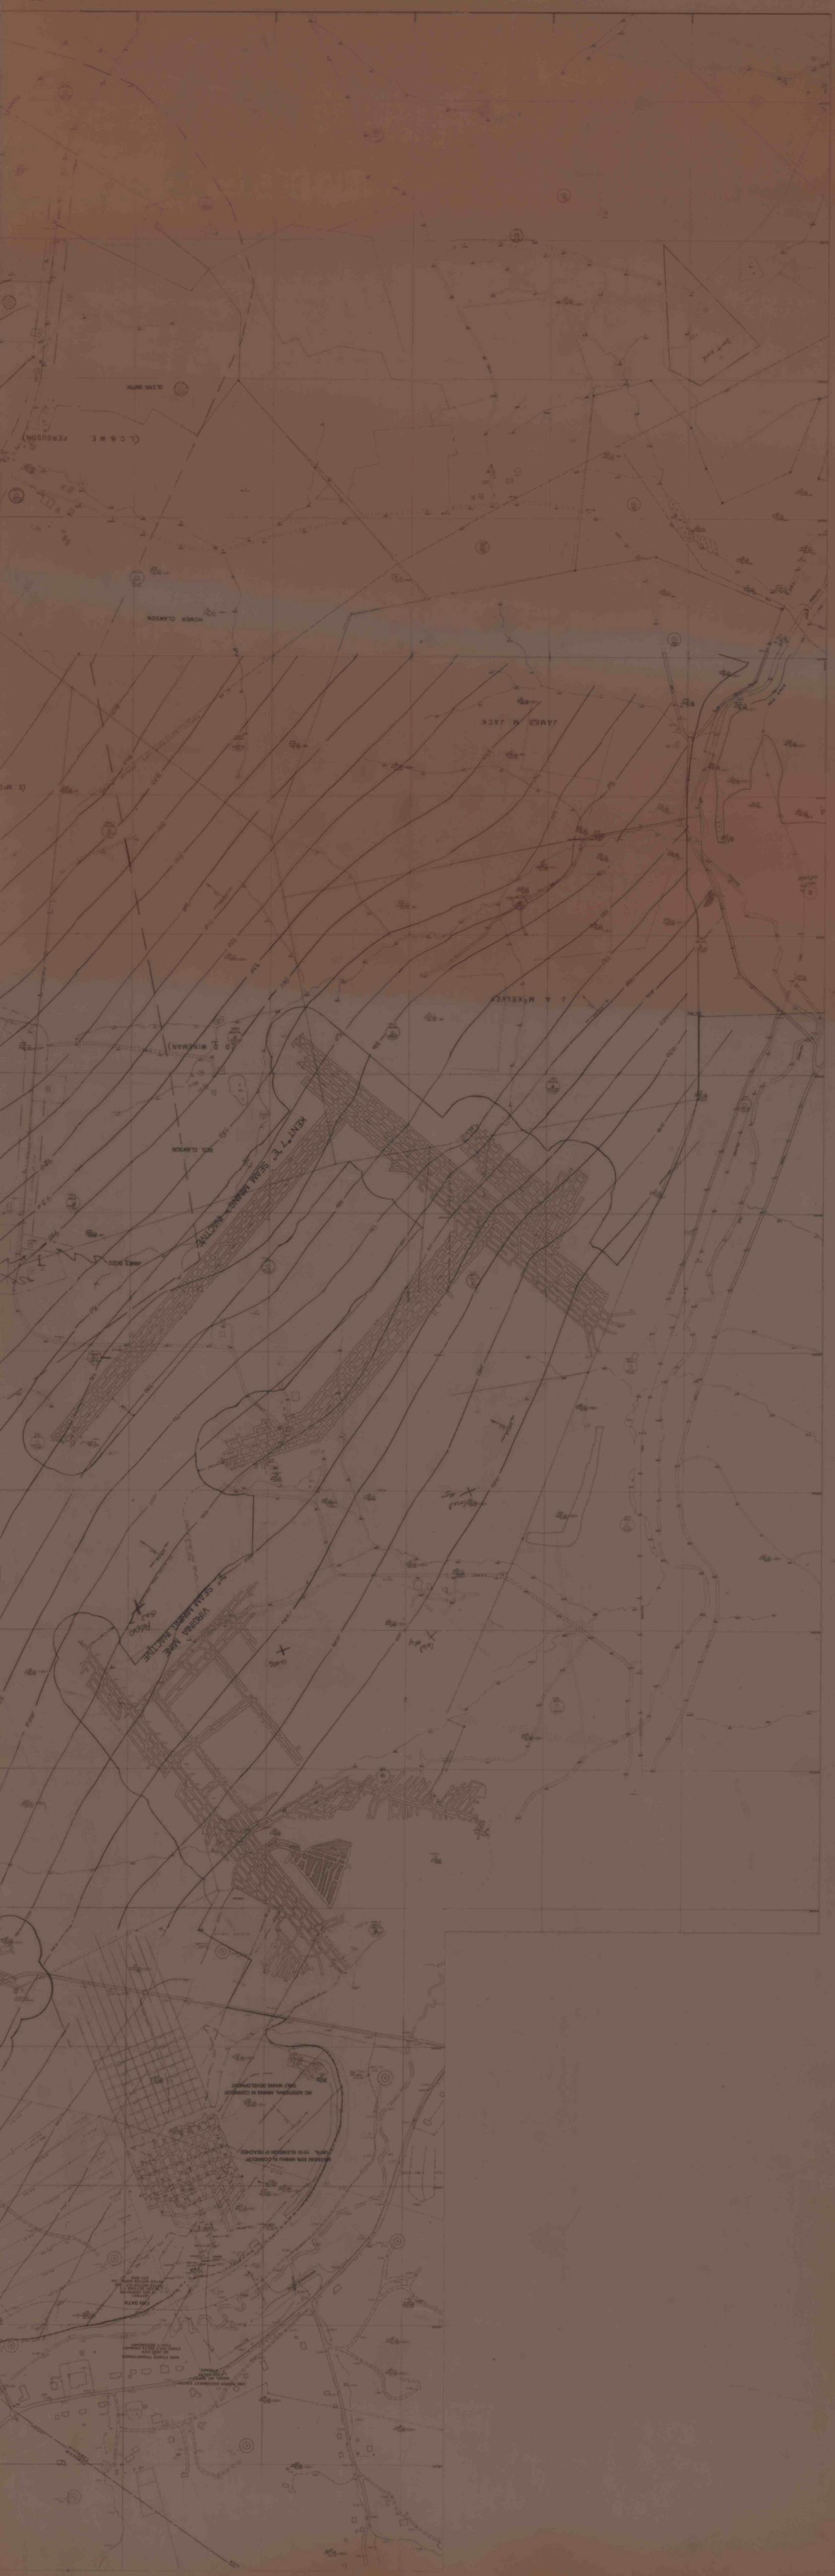


13103-151

IMAPS 16798