




HELVETIA COAL COMPANY
LUCERNE No. 6 MINE
C.M.A.P. No. 32841303

MINE MAP
MINE CLOSURE PLAN

SCALE 1" = 400'
DATE AUG. 15, 1990

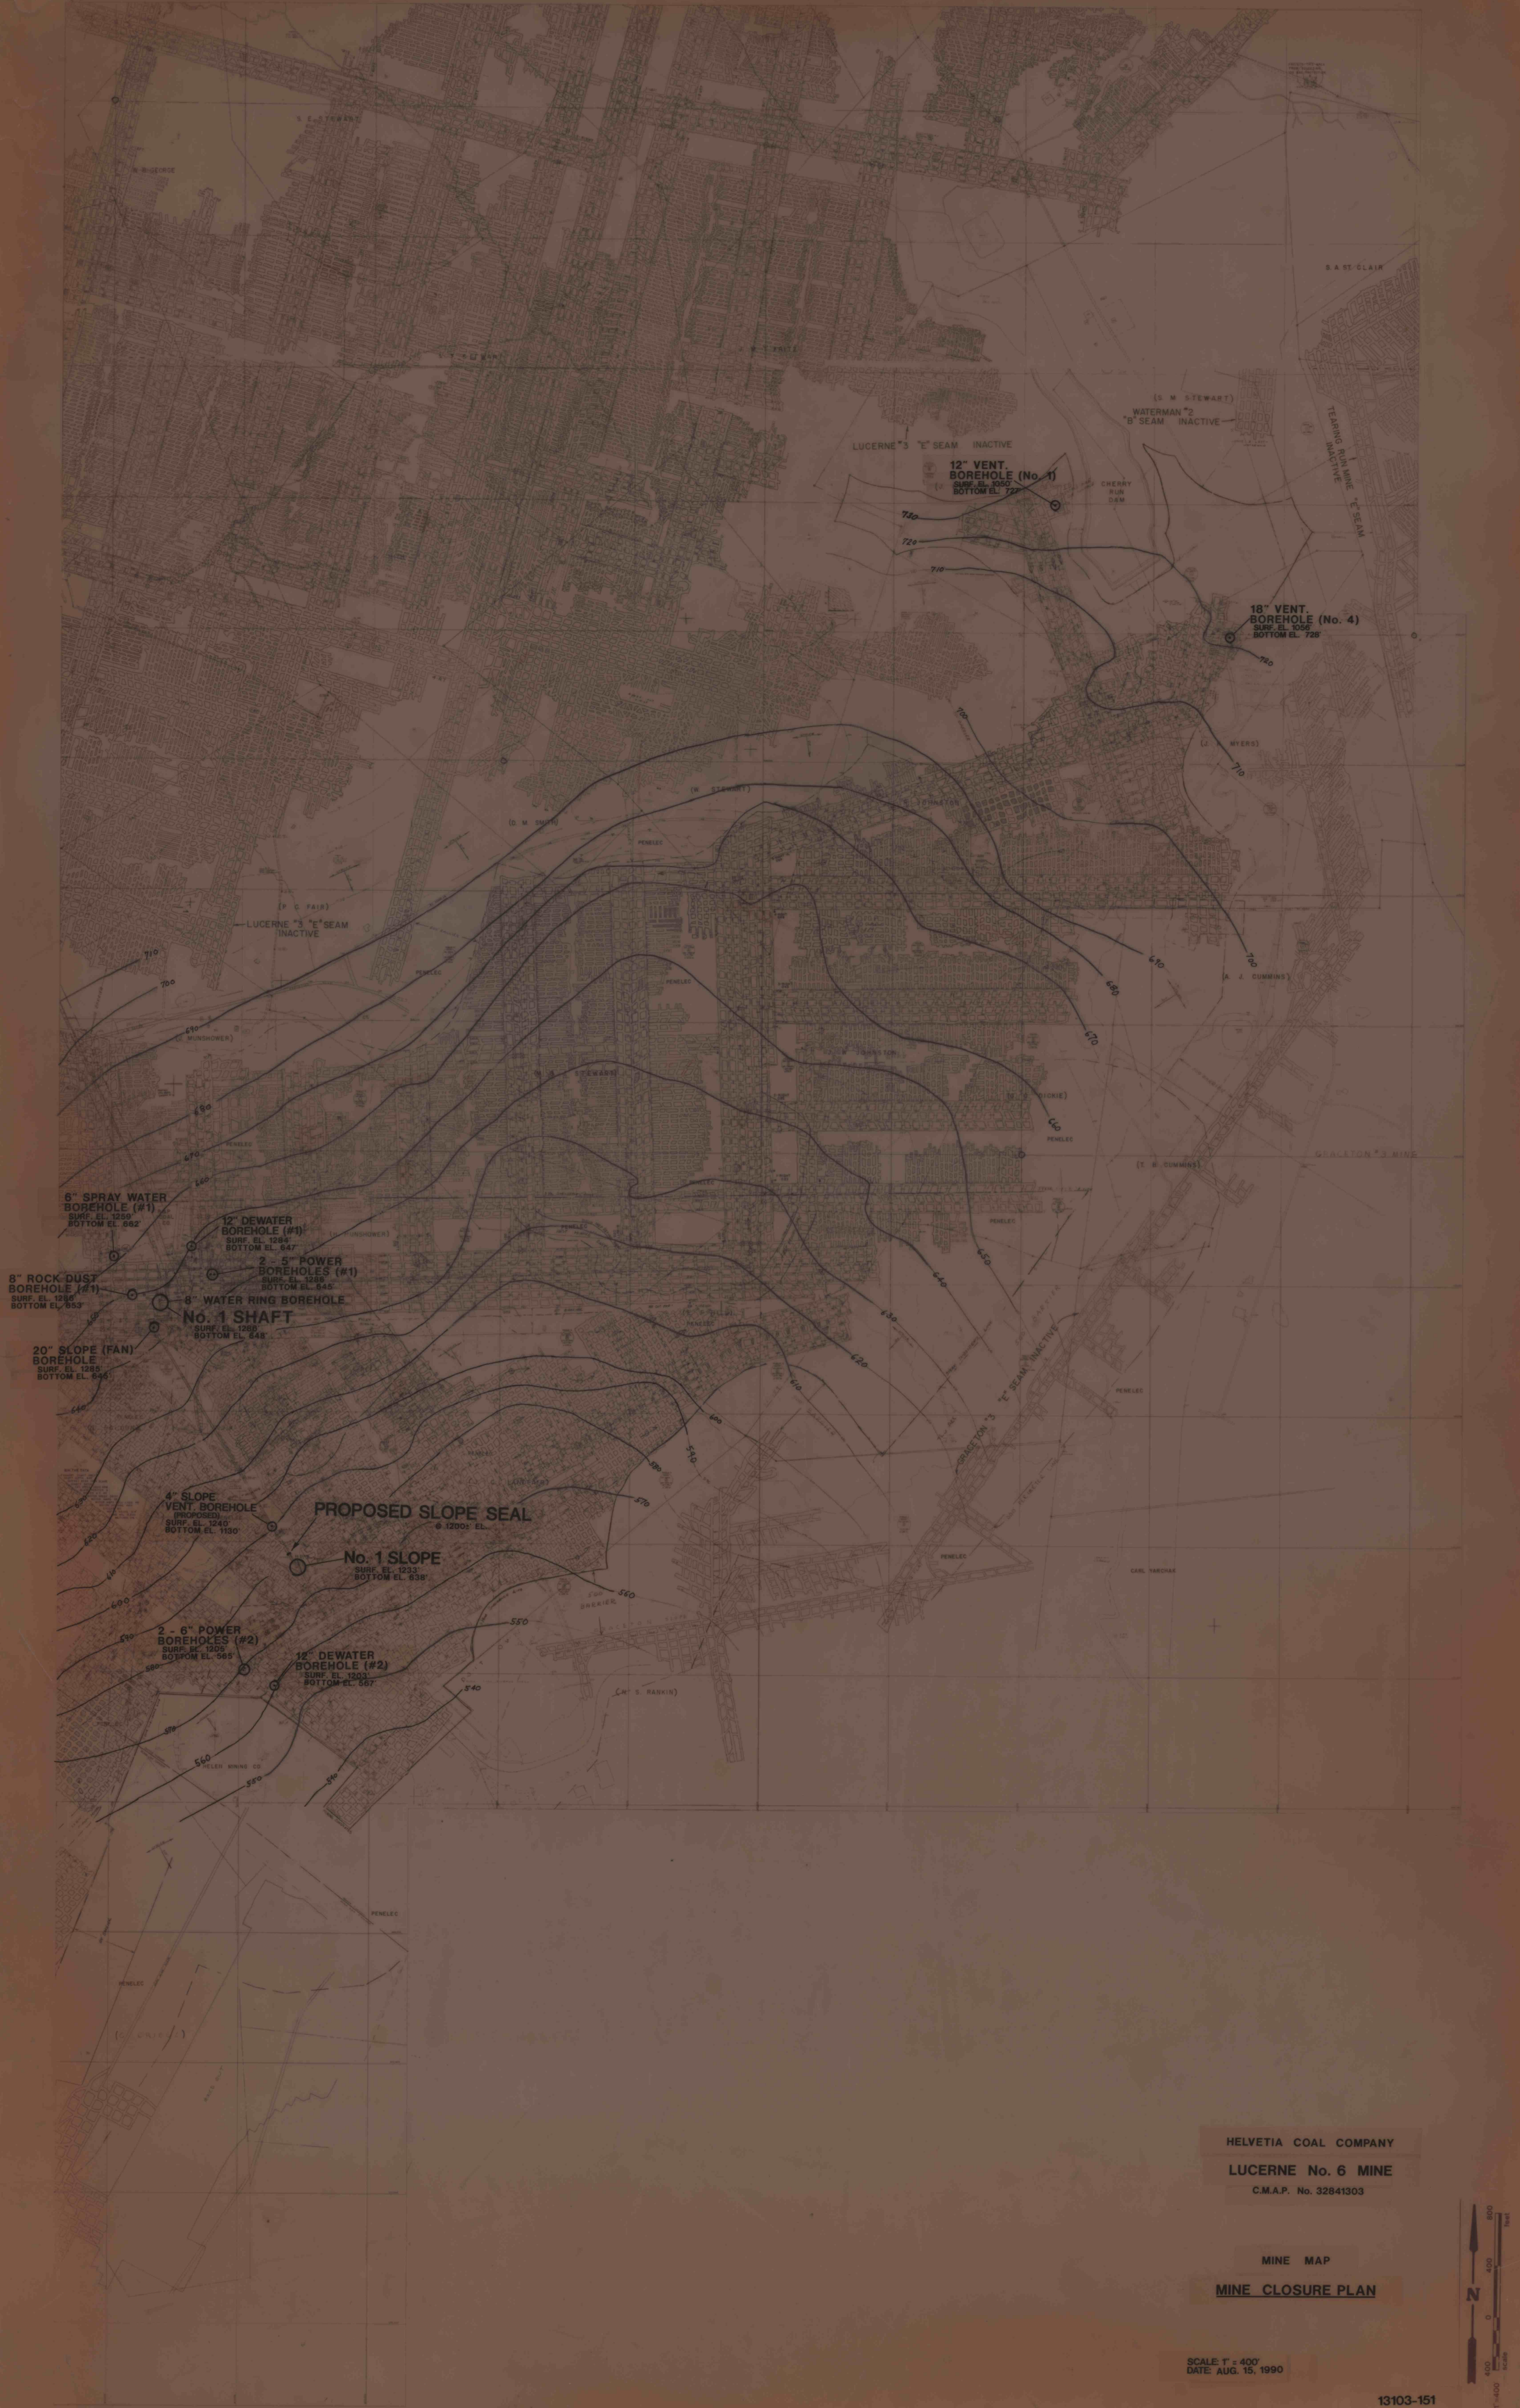