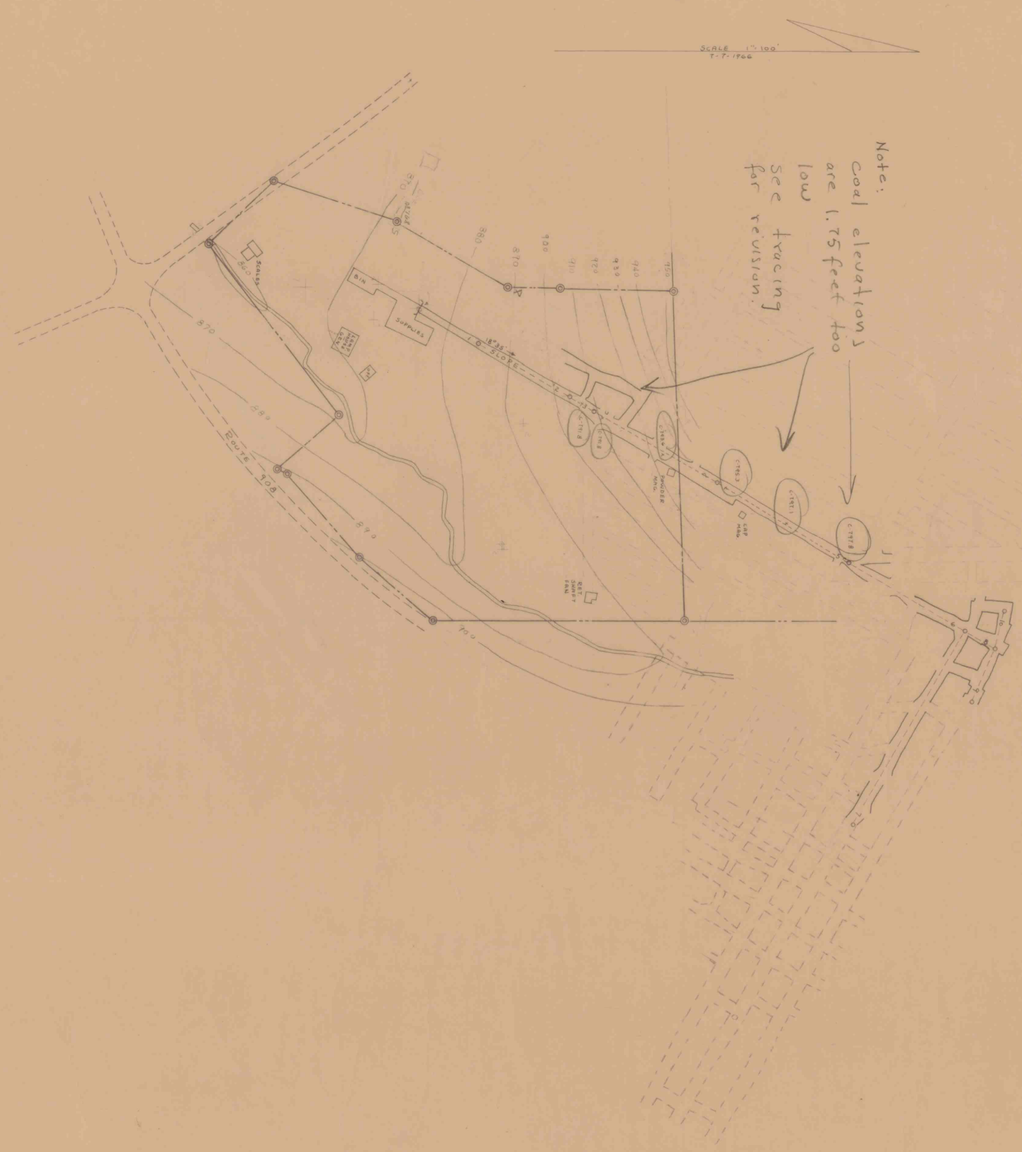
Note:
Coal elevations
low
SCALE 1" = 100'
5-7-1966
