


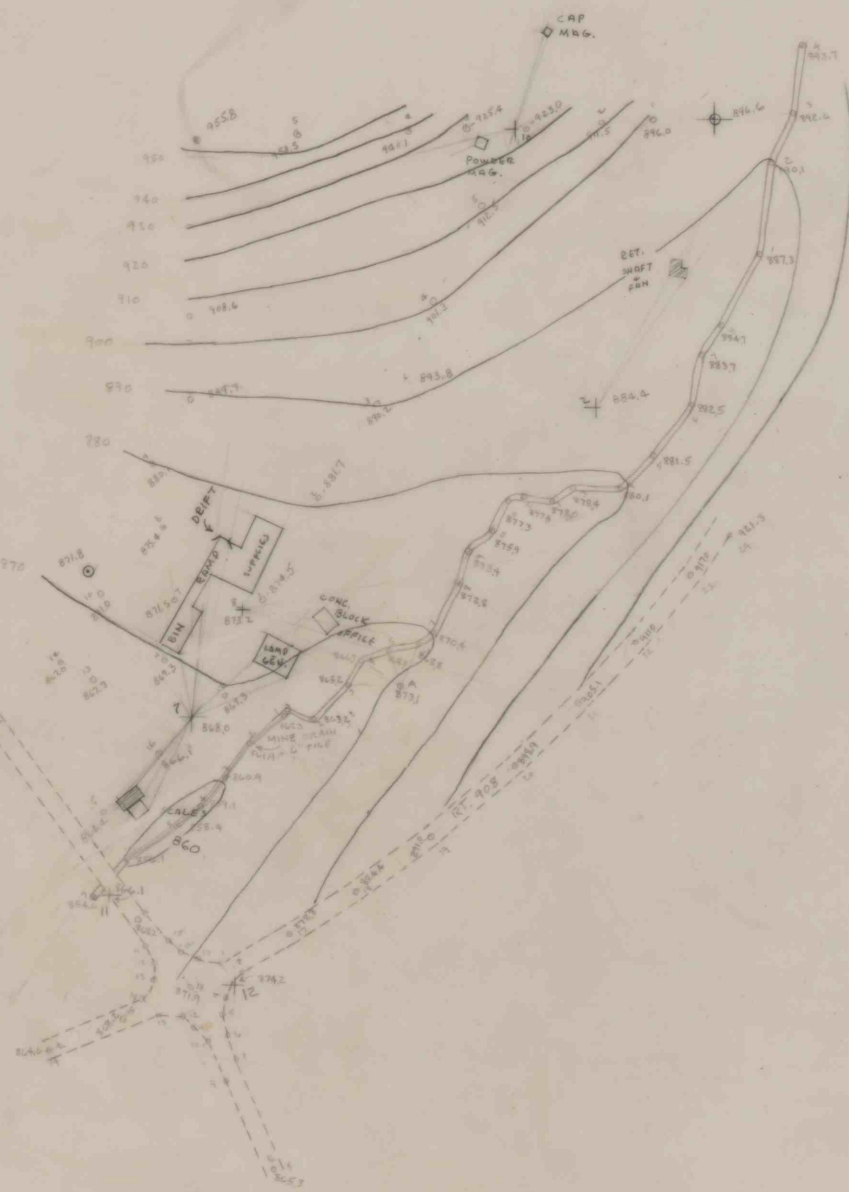

MAPS#1682B

9630-11-28