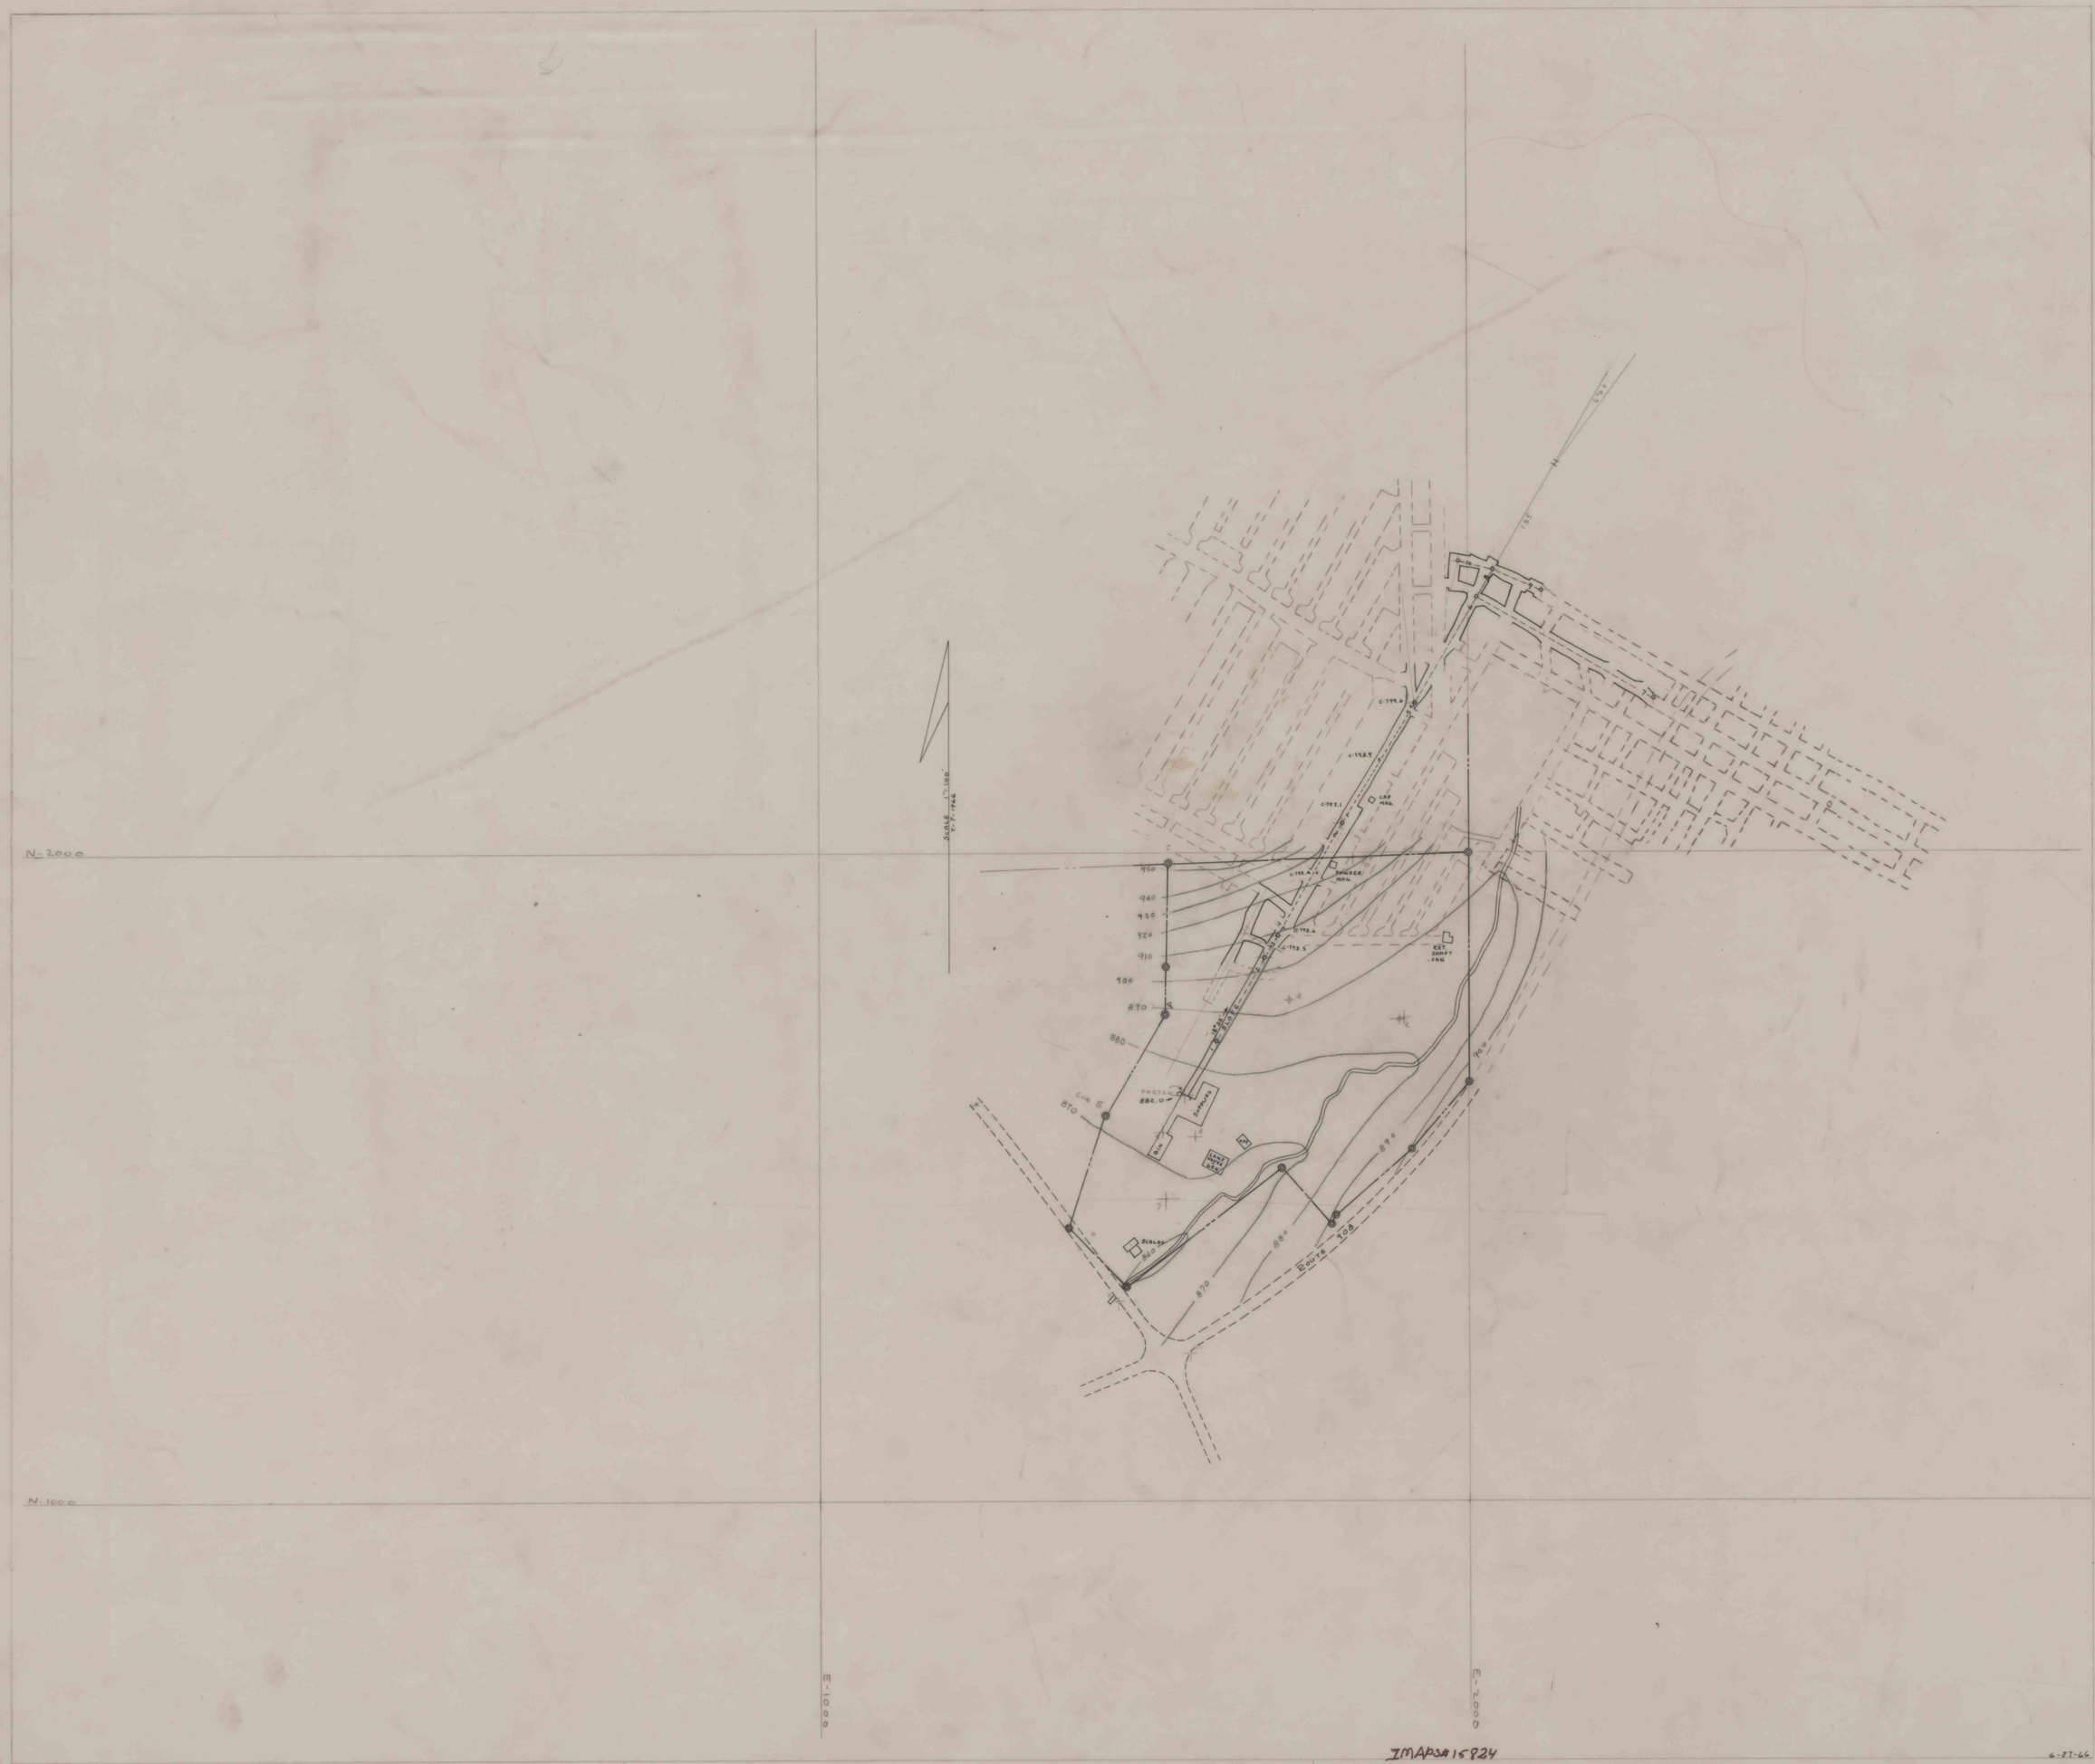

PENN-ALLEGH COAL CO.
KOLEN MINE

2EV-1-18-68

9650-683