



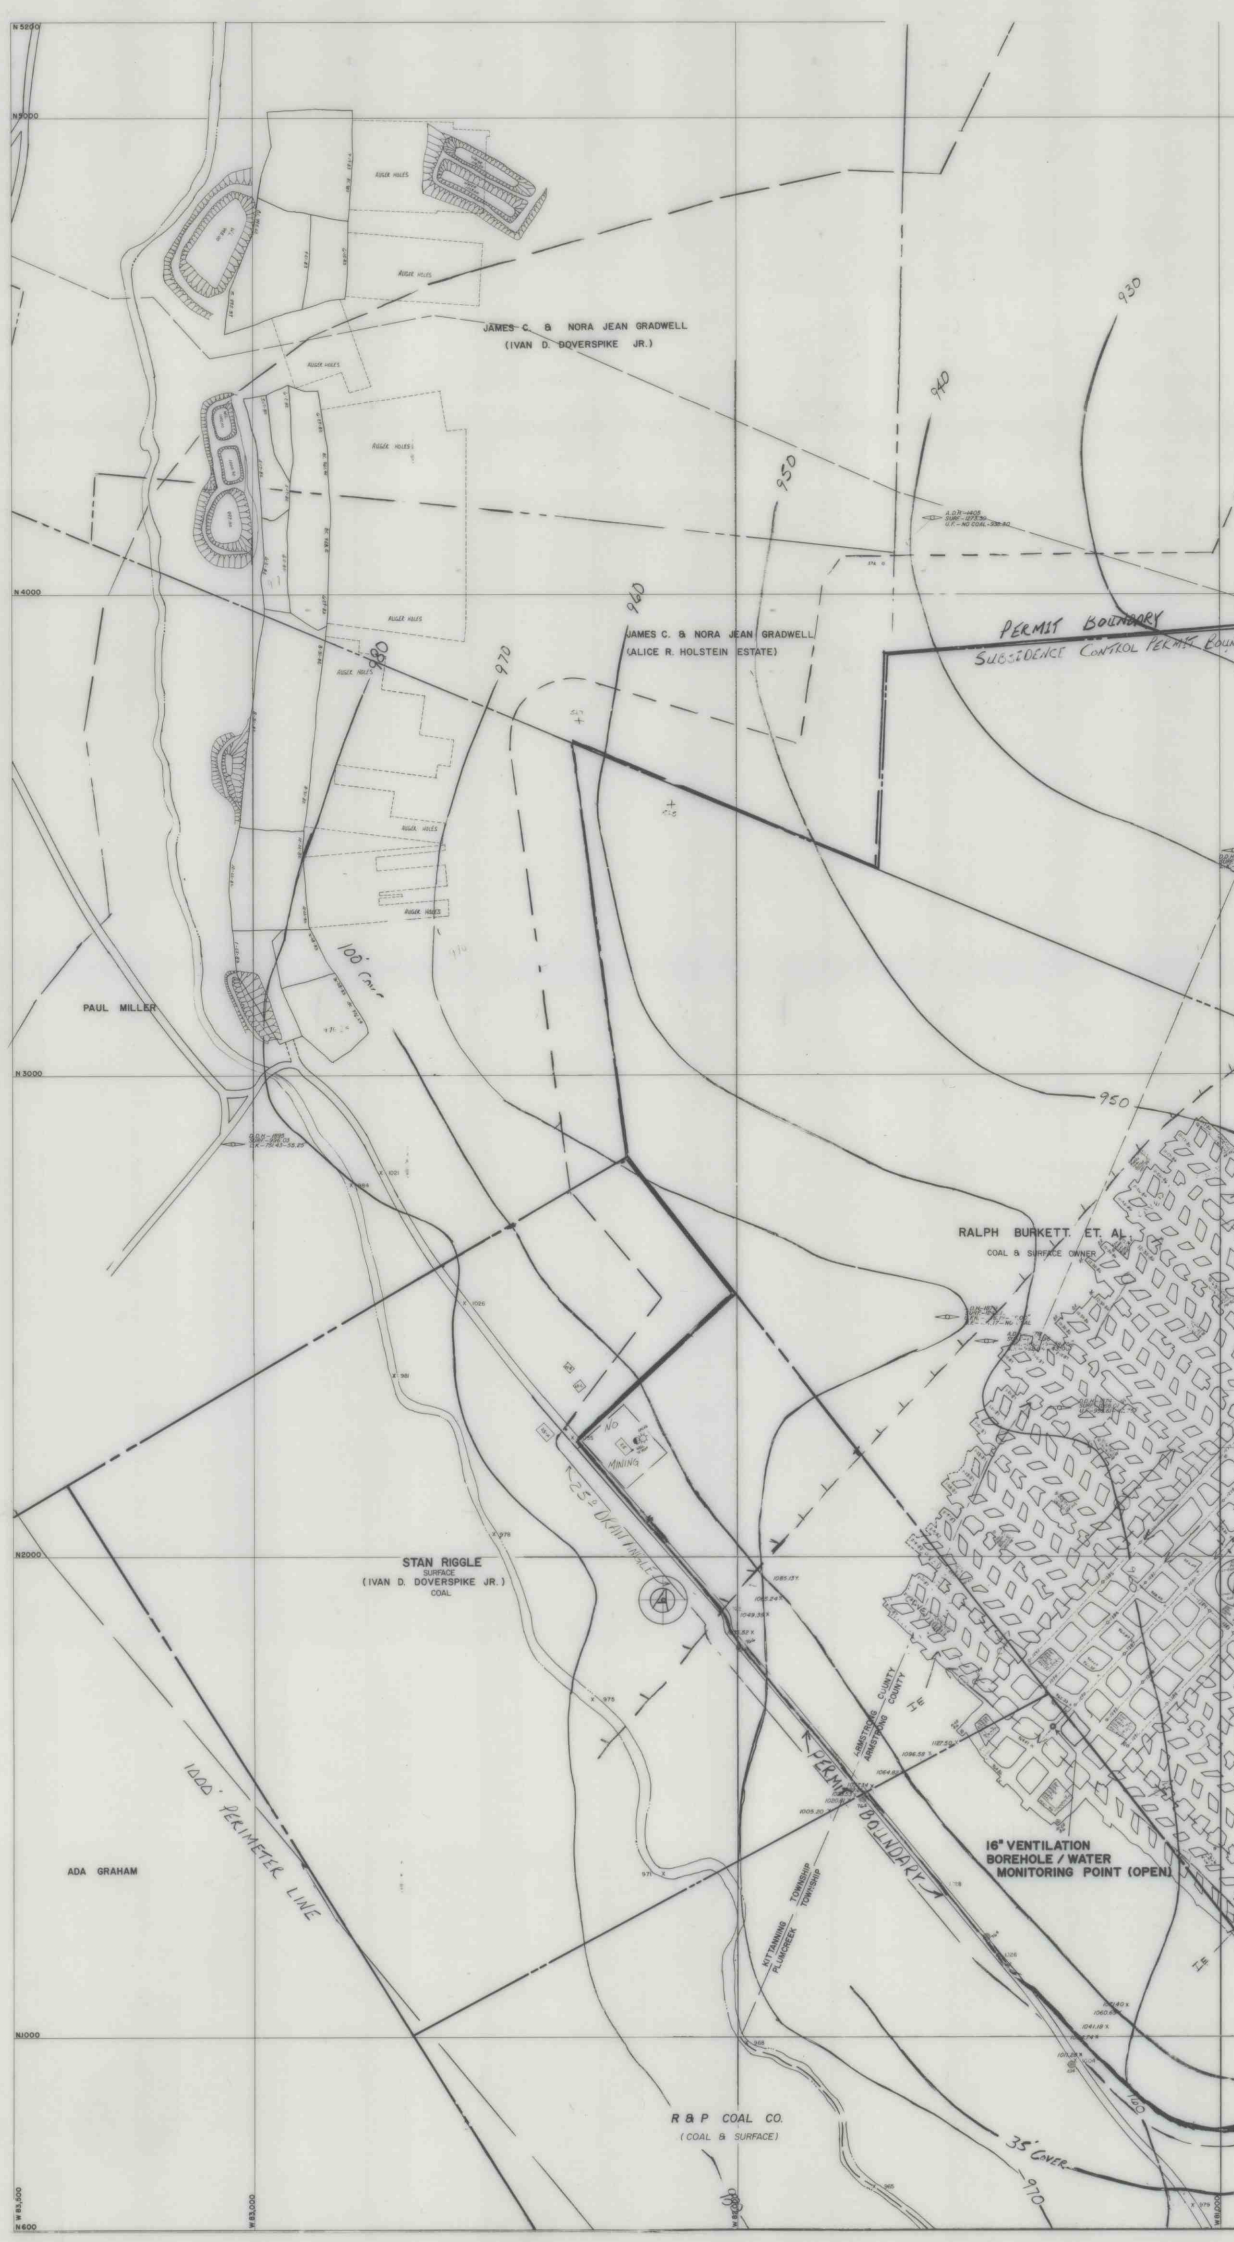

POSTING DATE 11-1-1910

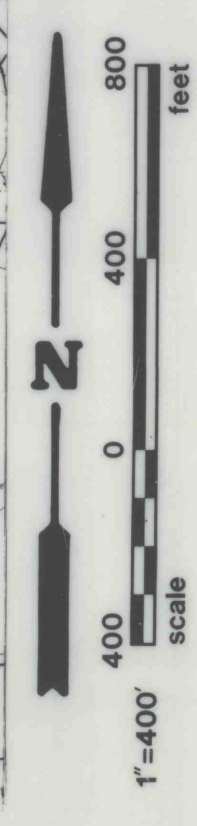

FINAL MINE MAP

KEYSTONE COAL MINING CORPORATION MARGARET No. 11 MINE UPPER FREEPORT COAL SEAM PLUMCREEK TWR ARMSTRONG COUNTY

IMAP 16919