

N 3,000

N 2,500


N 2,000

W 76,000

W 75,500

W 75,000

W 74,500

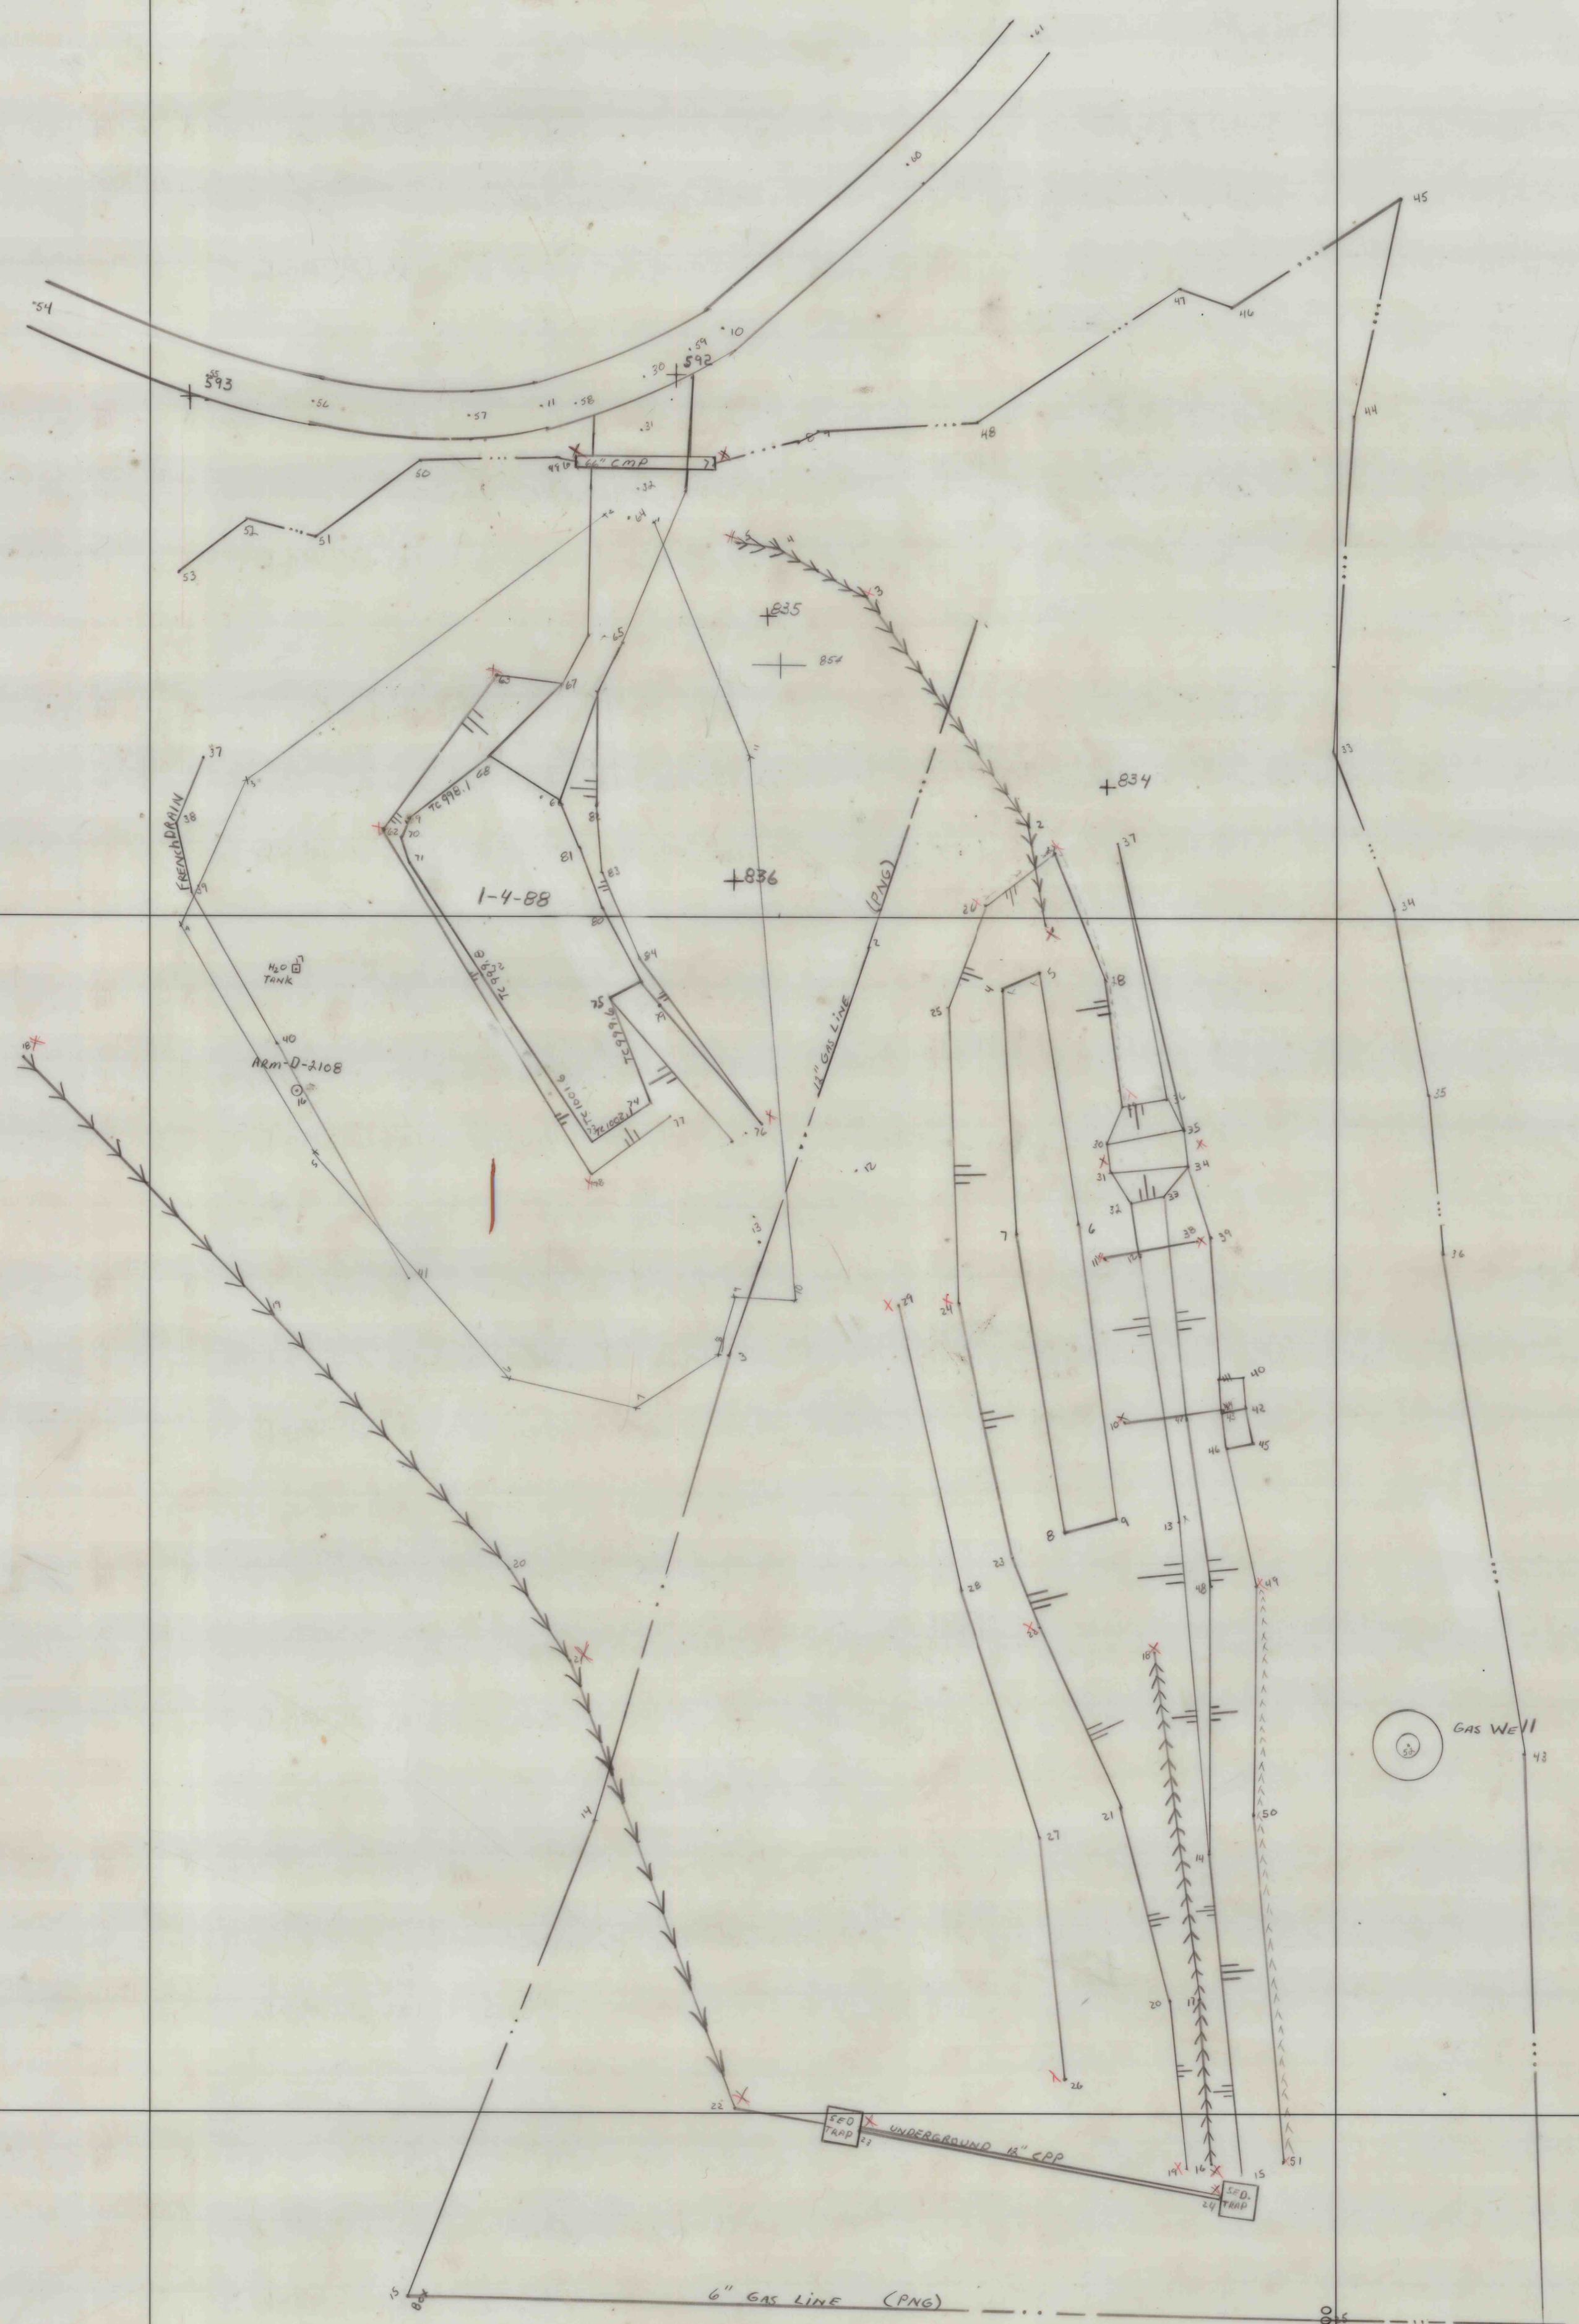

ROCHESTER & PITTSBURGH COAL COMPANY	
ENGINEERING DEPT., INDIANA, PA.	
MARGARET II	
AIR INTAKE	
MADE BY T.J.D.	SCALE 1"= 50'
TRACED BY	DATE NOV. 1987
CHECKED BY	NO.

IMAPS#16922