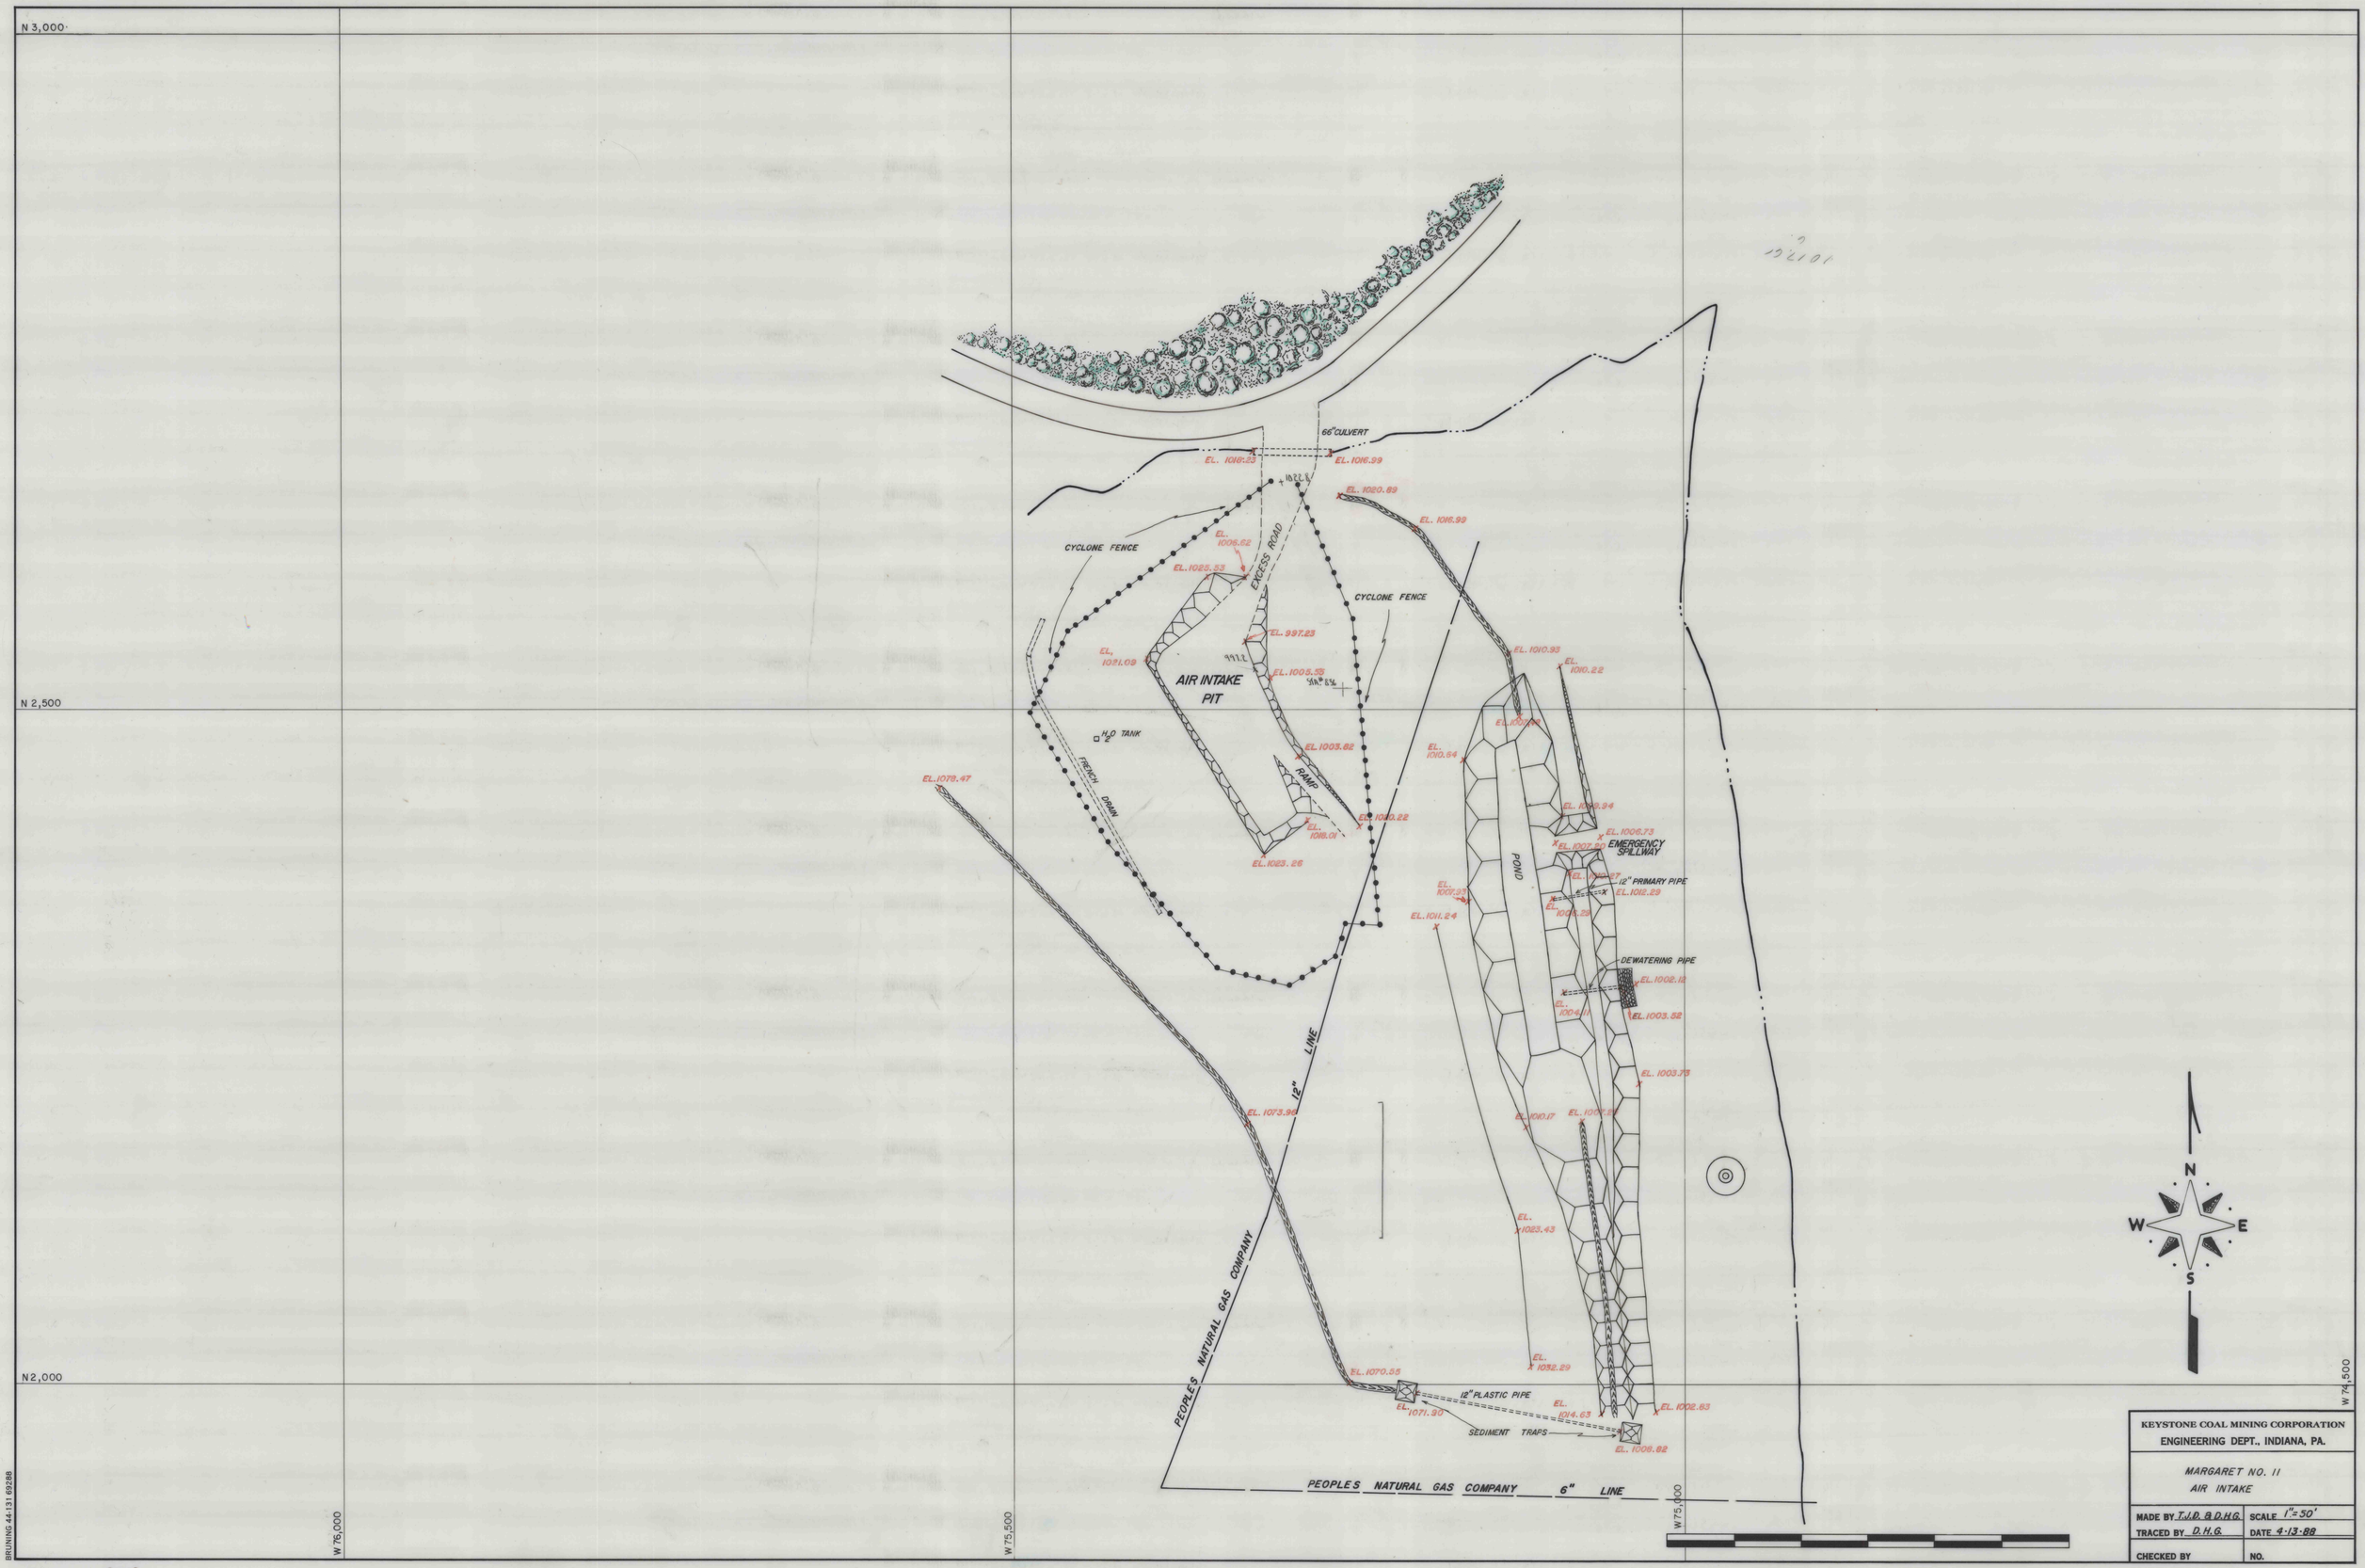
N 3,000
N 2,500
N2,000
W 75,000
W 75,500
W 76,000
W 76,500
66" CULVERT
EL. 1016.99
EL. 1020.89
EL. 1016.99
CYCLONE FENCE
EL. 1006.62
EL. 1025.53
ACCESS ROAD
CYCLONE FENCE
EL. 997.23
EL. 1021.09
AIR INTAKE PIT
EL. 1005.53
EL. 1010.93
EL. 1010.22
H_2O TANK
EL. 1003.82
RAMP
EL. 1018.01
EL. 1023.26
EL. 1010.22
EL. 1078.47
FRENCH DRAIN
EL. 1010.64
EL. 1006.73
EMERGENCY SPILLWAY
12" PRIMARY PIPE
EL. 1012.29
POND
EL. 1011.24
DEWATERING PIPE
EL. 1002.12
EL. 1003.82
EL. 1003.73
EL. 1073.96
12" LINE
EL. 1023.43
EL. 1032.29
PEOPLES NATURAL GAS COMPANY
EL. 1070.55
12" PLASTIC PIPE
EL. 1071.30
EL. 1014.63
EL. 1002.83
SEDIMENT TRAPS
EL. 1008.82
PEOPLES NATURAL GAS COMPANY 6" LINE
N
S
E
W
KEYSTONE COAL MINING CORPORATION
ENGINEERING DEPT., INDIANA, PA.
MARGARET NO. 11
AIR INTAKE
MADE BY T.J.D. & D.H.G.
SCALE 1"=50'
TRACED BY D.H.G.
DATE 4-13-88
CHECKED BY
NO.
BRUNING 44-131 69288

IMAPS# 16923