


1691#1691

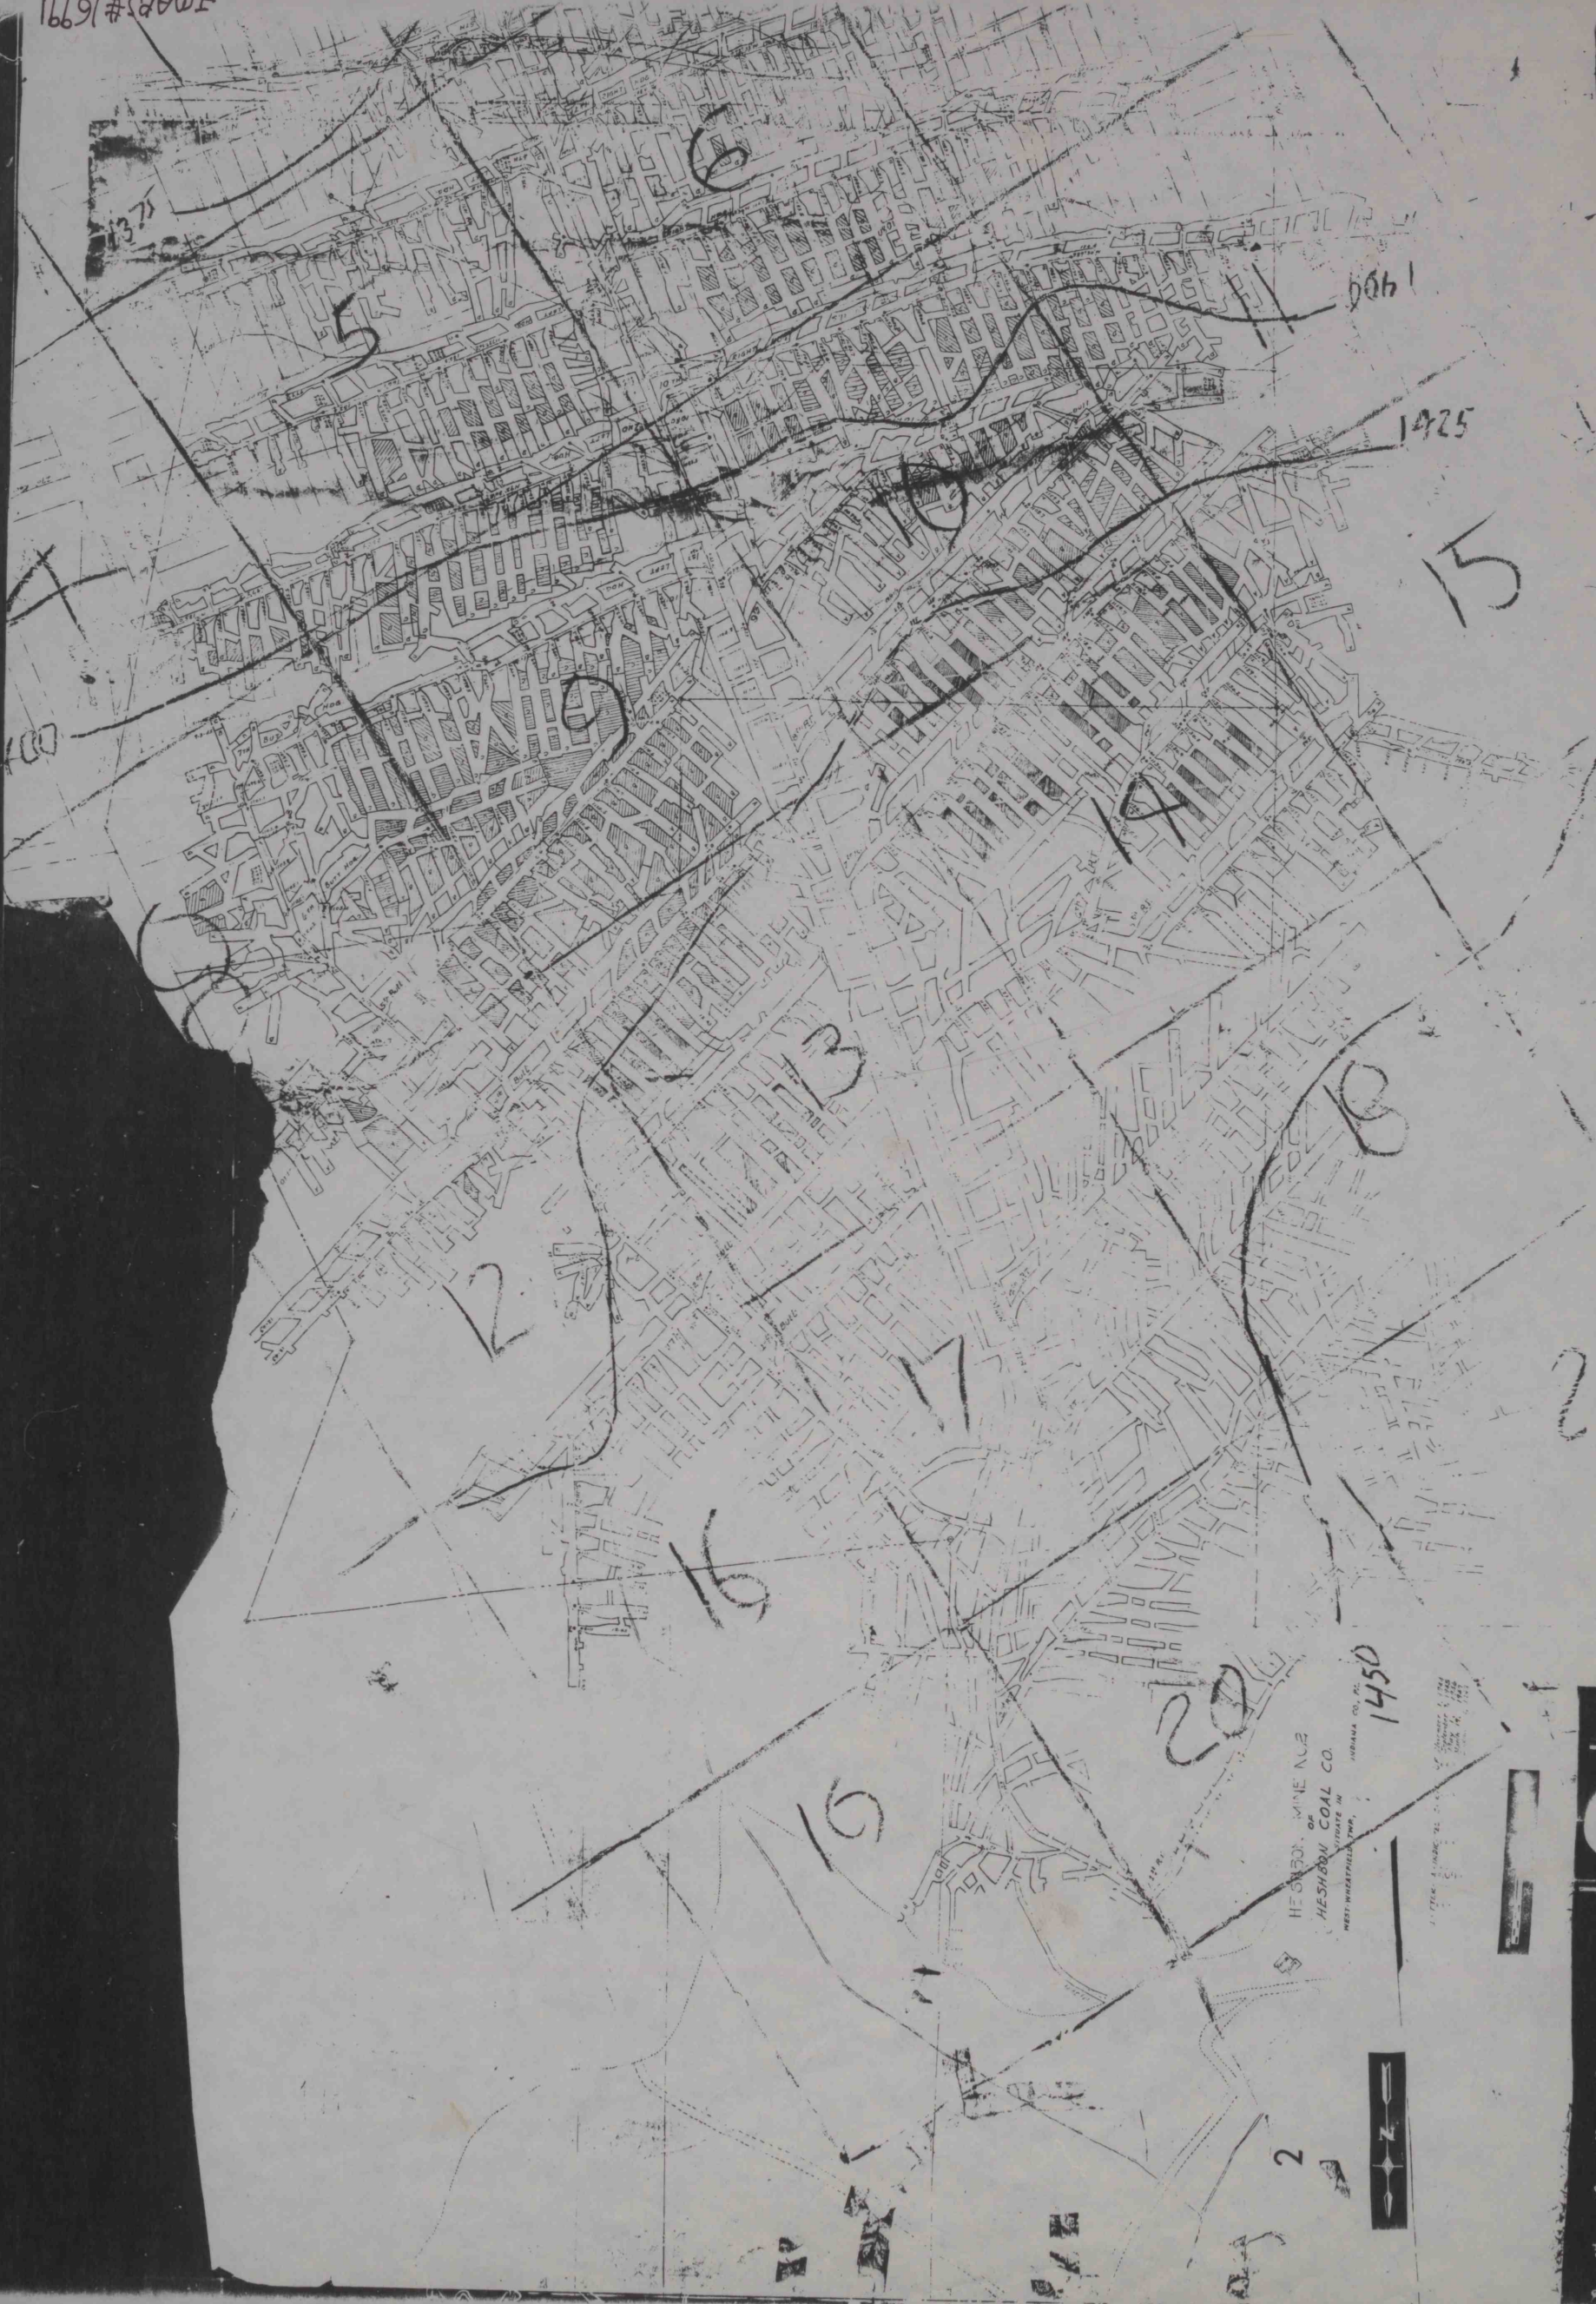

03013 221 36X 303858

HESBON COAL CO.  

1450

