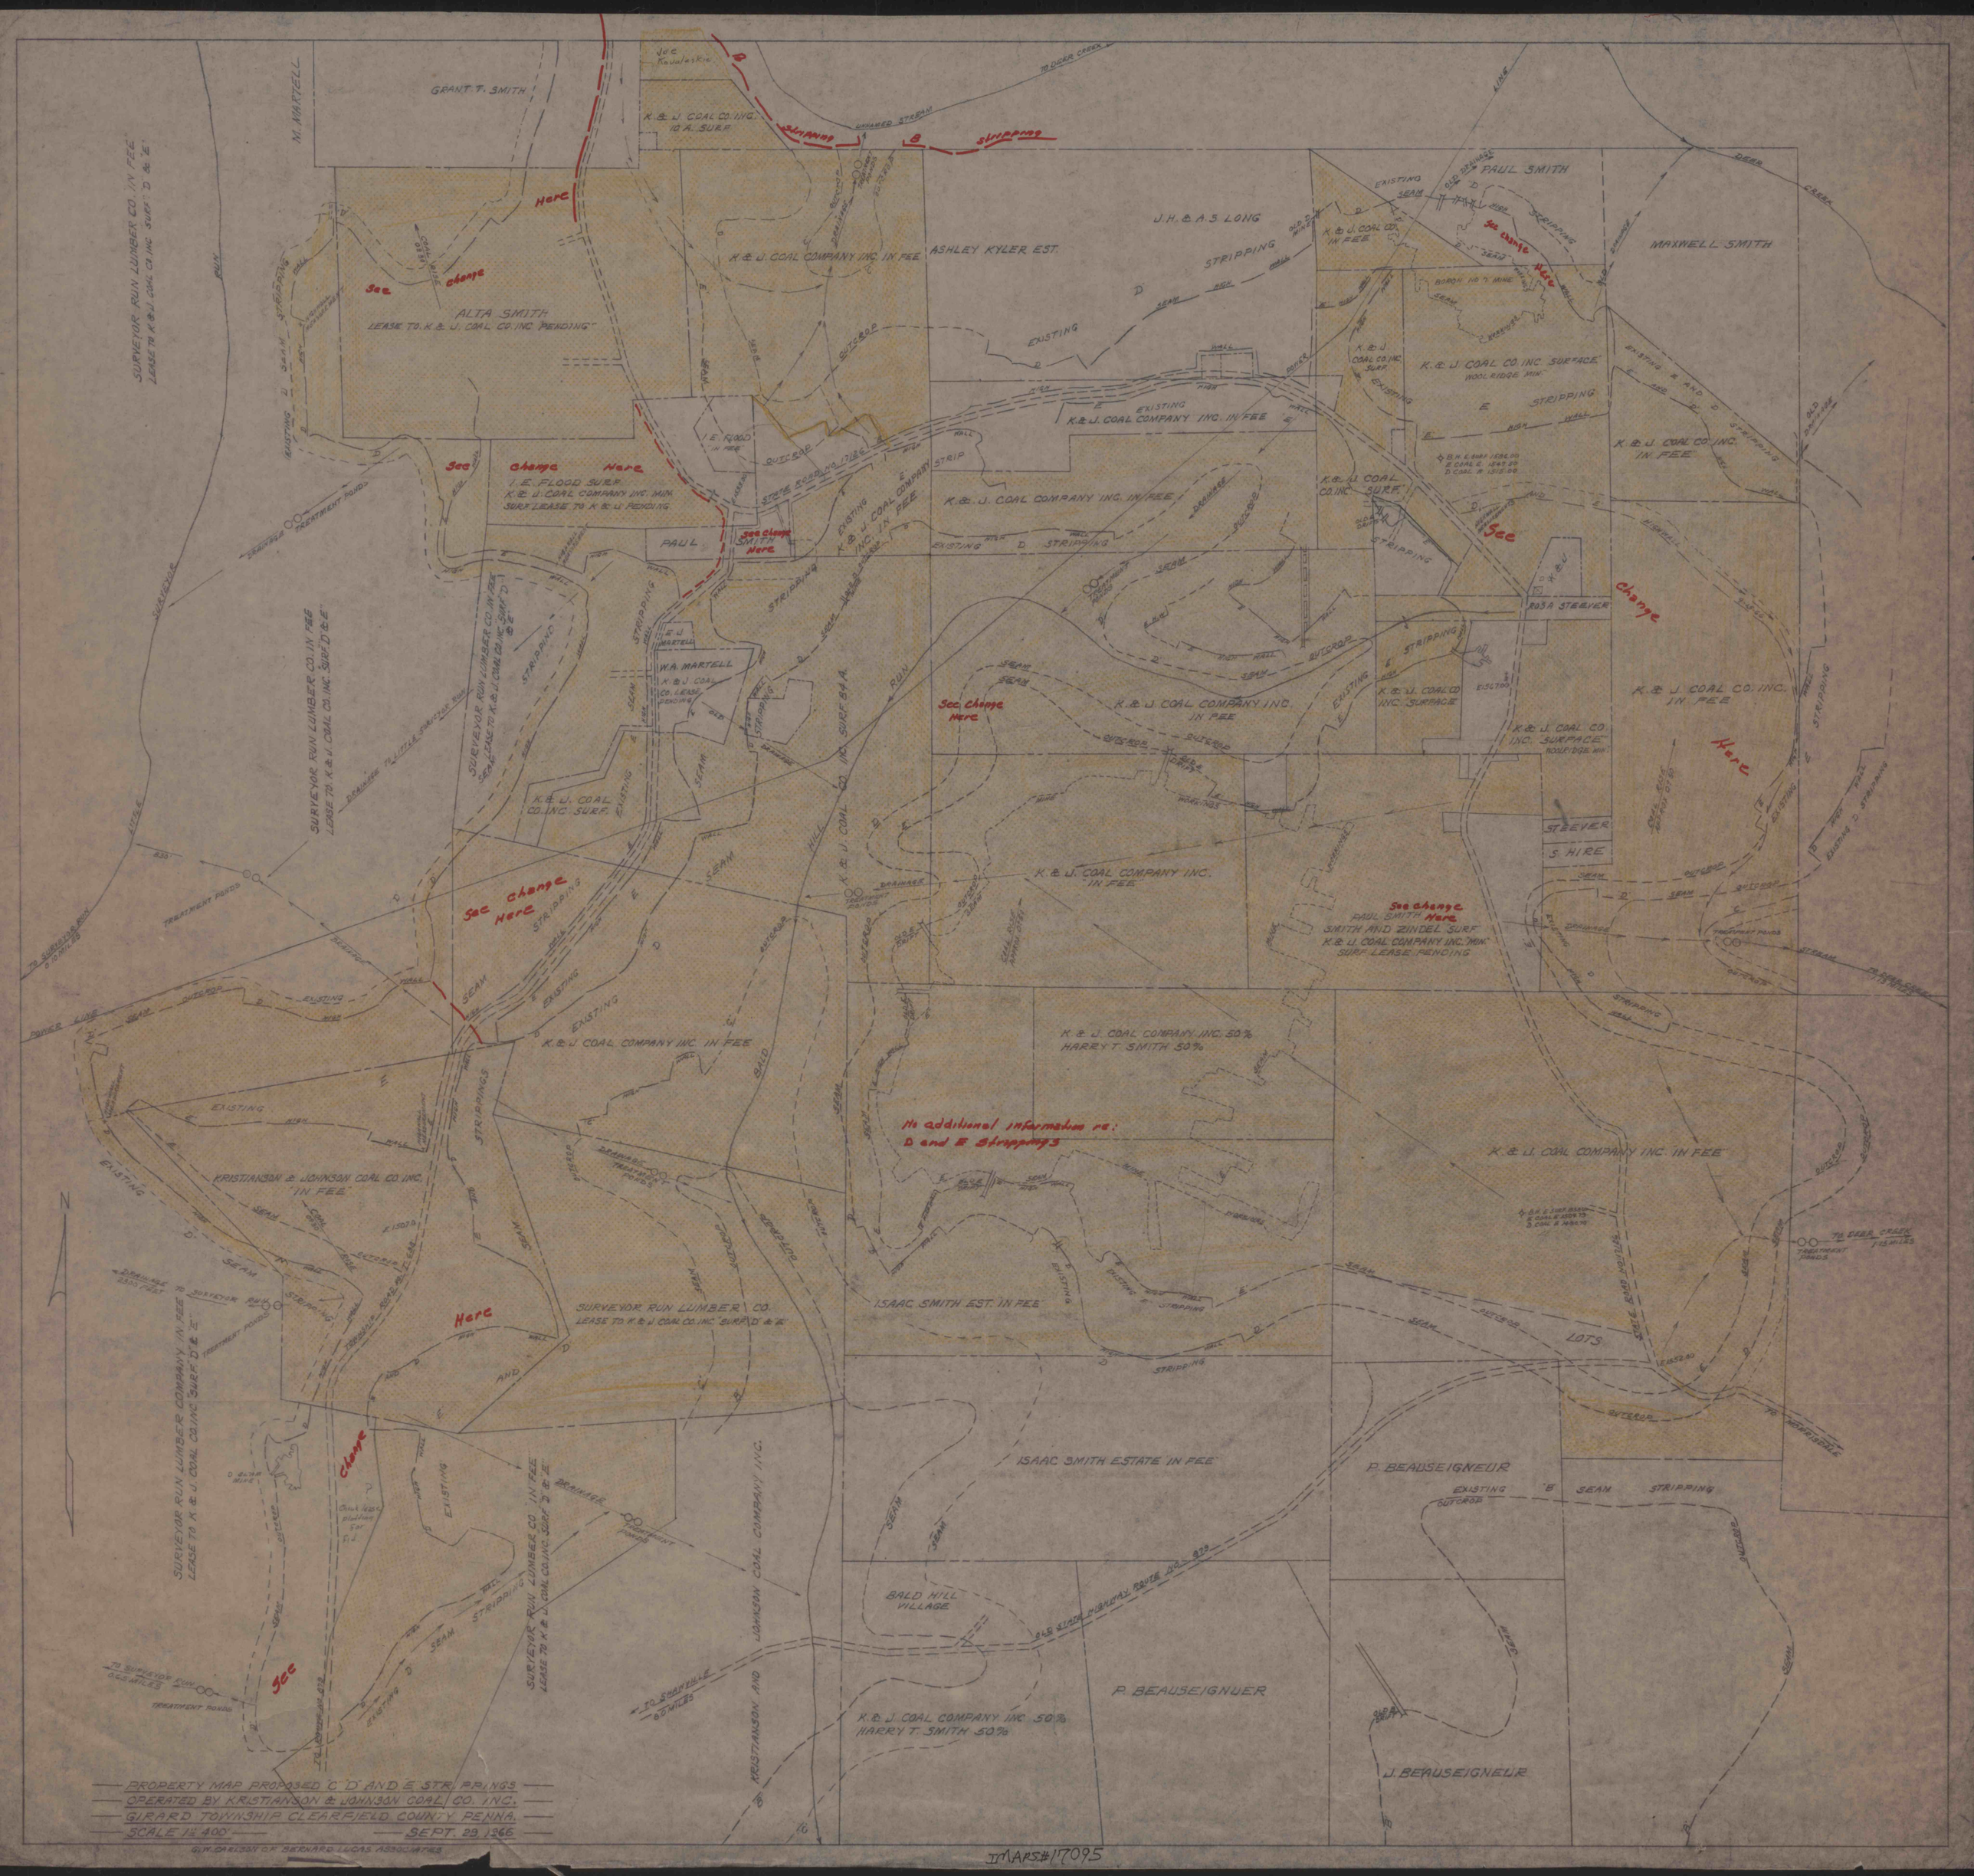
PROPERTY MAP PROPOSED 'C' 'D' AND 'E' STRIPPINGS
OPERATED BY KRISTIANSON & JOHNSON COAL CO. INC.
GIRARD TOWNSHIP CLEARFIELD COUNTY PENNA.
SCALE 1" = 400'
SEPT. 29 1966
G.W. CARLSON & BERNARD LUCAS ASSOCIATES
GRANT T. SMITH
M. MARTELL
K. & J. COAL CO. INC. 10 A. SURF.
K. & J. COAL COMPANY INC. IN FEE
ASHLEY KYLER EST.
J.H. & A.S. LONG
PAUL SMITH
MAXWELL SMITH
ALTA SMITH
LEASE TO K. & J. COAL CO. INC. "PENDING"
I.E. FLOOD SURF.
K. & J. COAL CO. INC. MIN.
SURF. LEASE TO K. & J. PENDING.
K. & J. COAL CO. INC. "SURFACE"
WOOL RIDGE MIN.
K. & J. COAL CO. INC. IN FEE
K. & J. COAL CO. INC. SURF.
K. & J. COAL CO. INC. "SURFACE"
K. & J. COAL CO. INC. SURFACE
K. & J. COAL CO. INC. SURFACE
WOOLRIDGE MIN.
STEEVER
S. HIRE
PAUL SMITH
SMITH AND ZINDEL SURF.
SURF. LEASE PENDING
K. & J. COAL COMPANY INC. 50%
HARRY T. SMITH 50%
No additional information re:
D and E Strippings
K. & J. COAL COMPANY INC. IN FEE
KRISTIANSON & JOHNSON COAL CO. INC. "IN FEE"
SURVEYOR RUN LUMBER CO.
LEASE TO K. & J. COAL CO. INC. "SURF. 'D' & 'E'"
ISAAC SMITH EST. IN FEE
ISAAC SMITH ESTATE IN FEE
LOTS
P. BEAUSEIGNEUR
BALD HILL VILLAGE
J. BEAUSEIGNEUR
KRISTIANSON AND JOHNSON COAL COMPANY INC.
TREATMENT PONDS
TO DEER CREEK
TO WATERSDALE
TO SHAWVILLE
TO SURVEYOR RUN
See change Here
Here
change
See

MARS#17095