


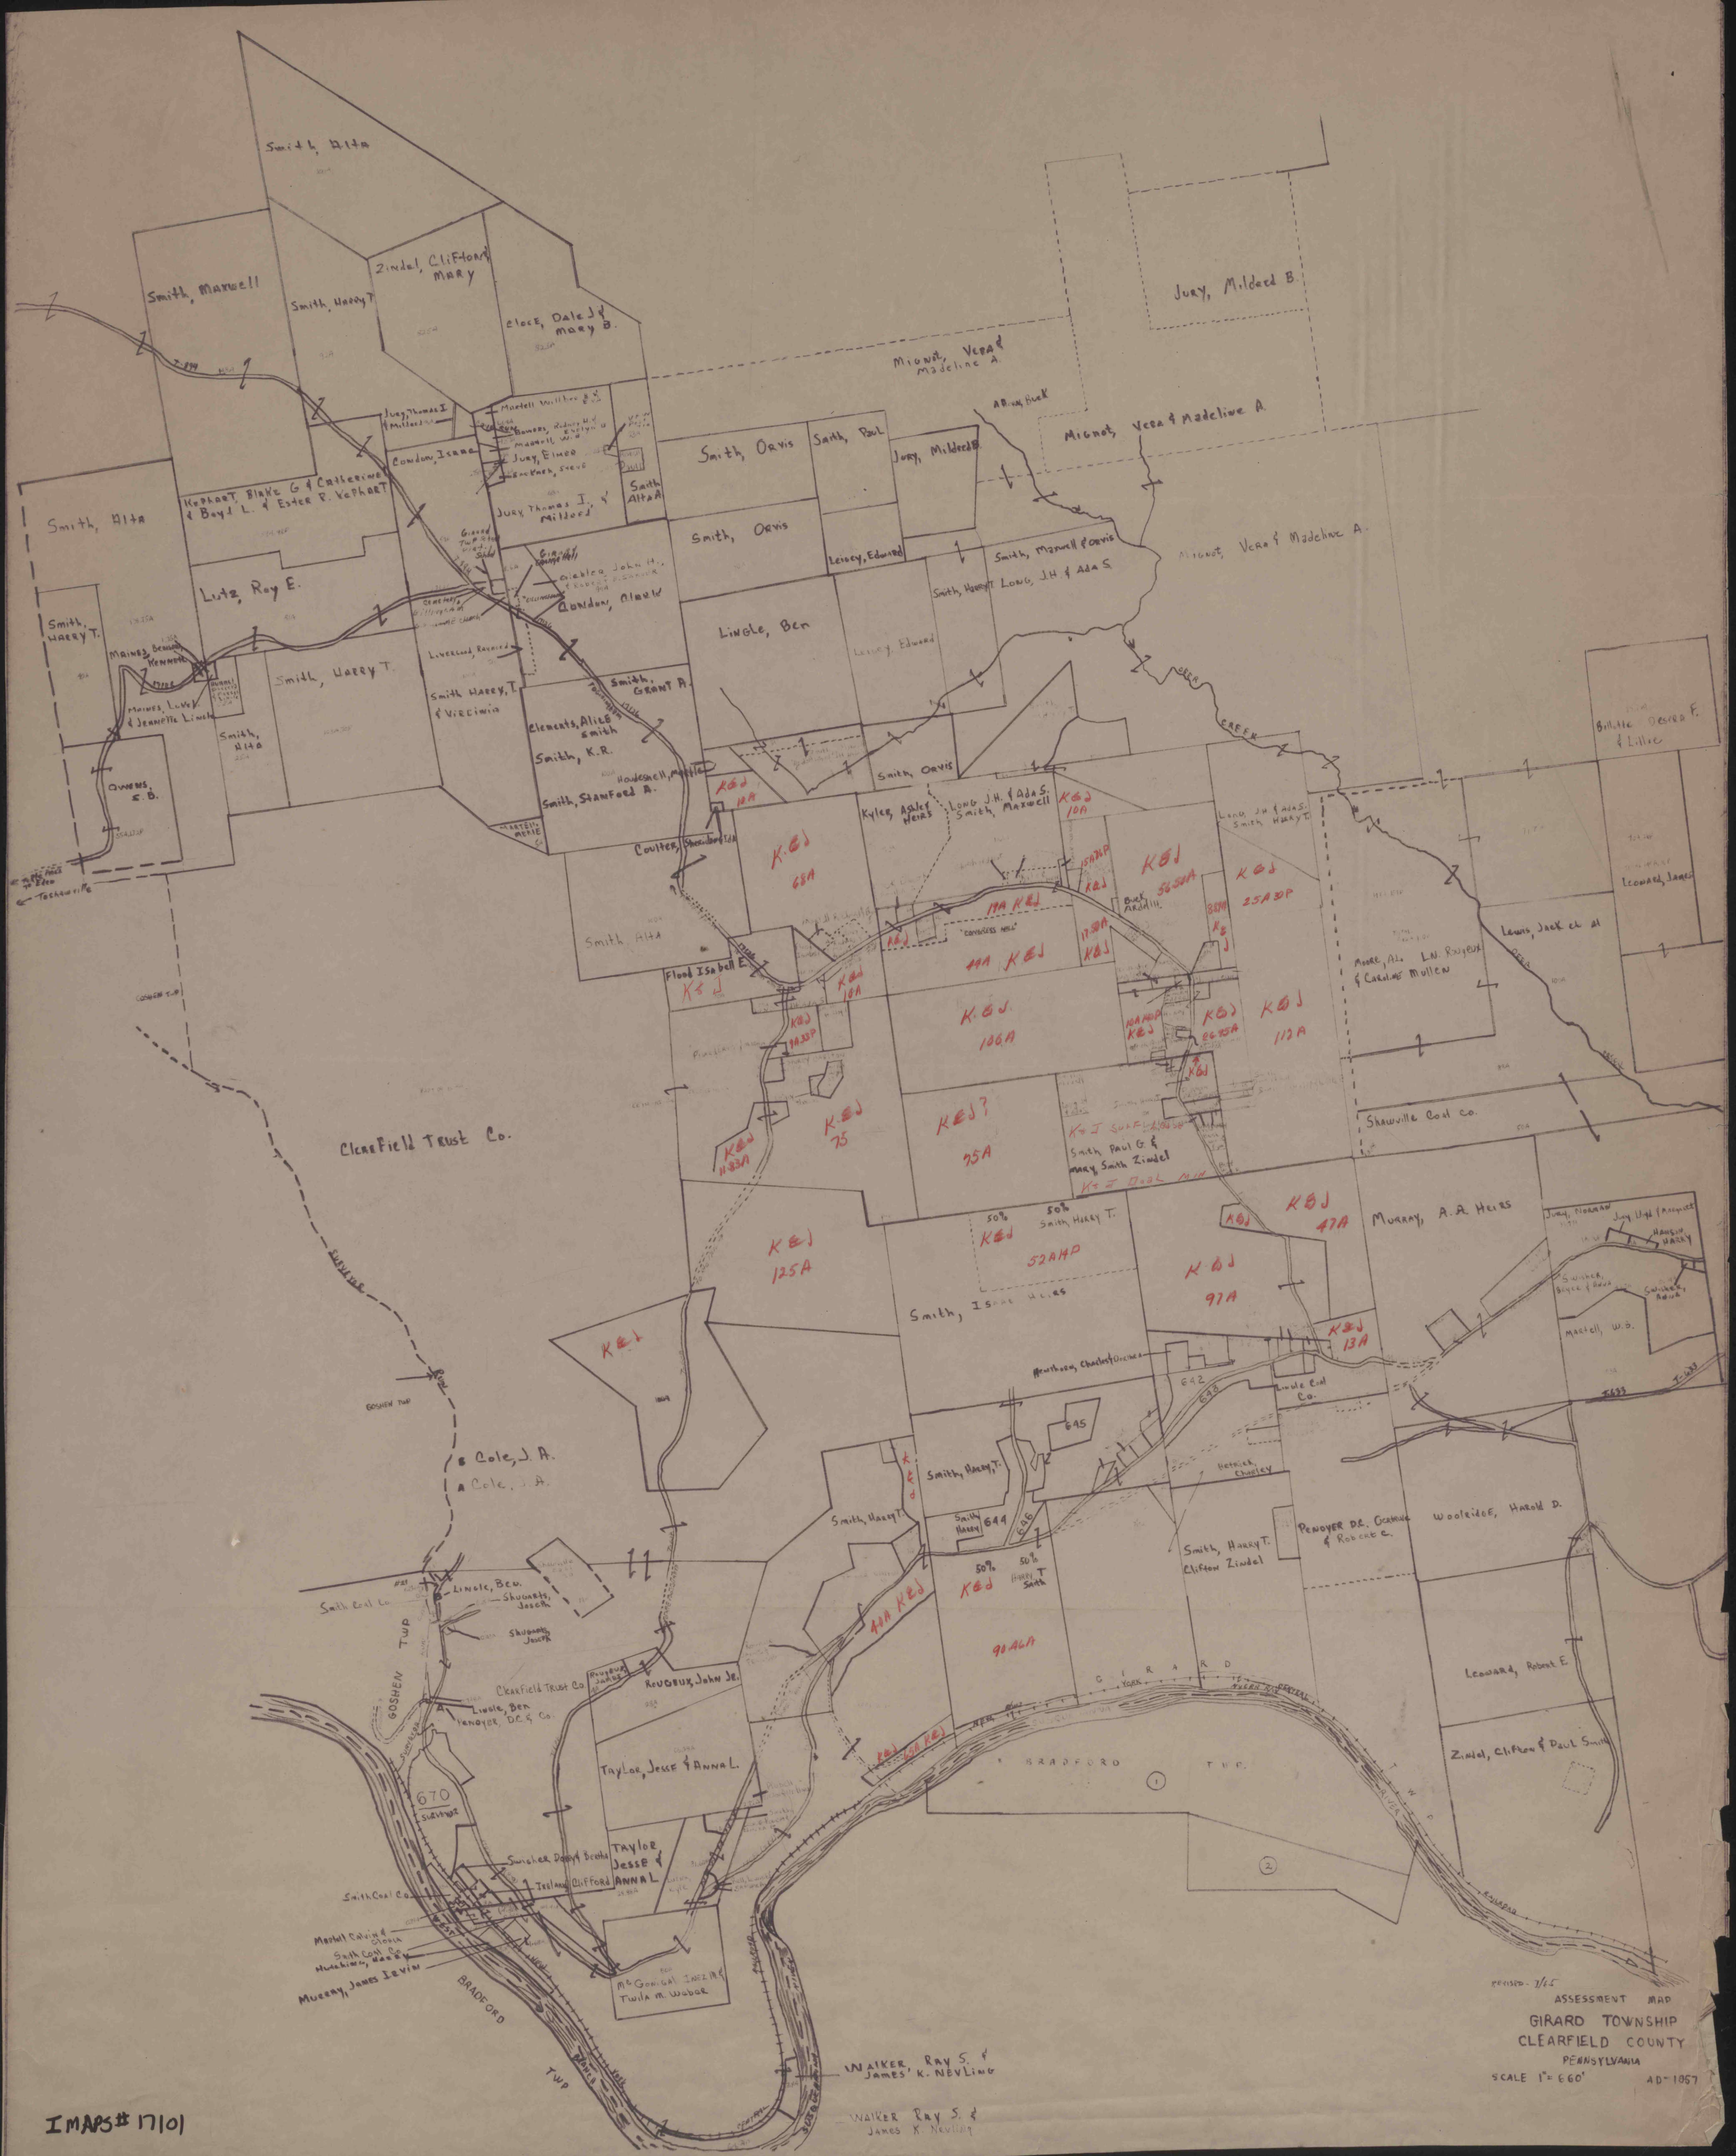

IMAPS# 17101

REVISED - 7/25
ASSESSMENT MAP
GIRARD TOWNSHIP
CLEARFIELD COUNTY
PENNSYLVANIA
SCALE 1" = 660'
AD-1057