


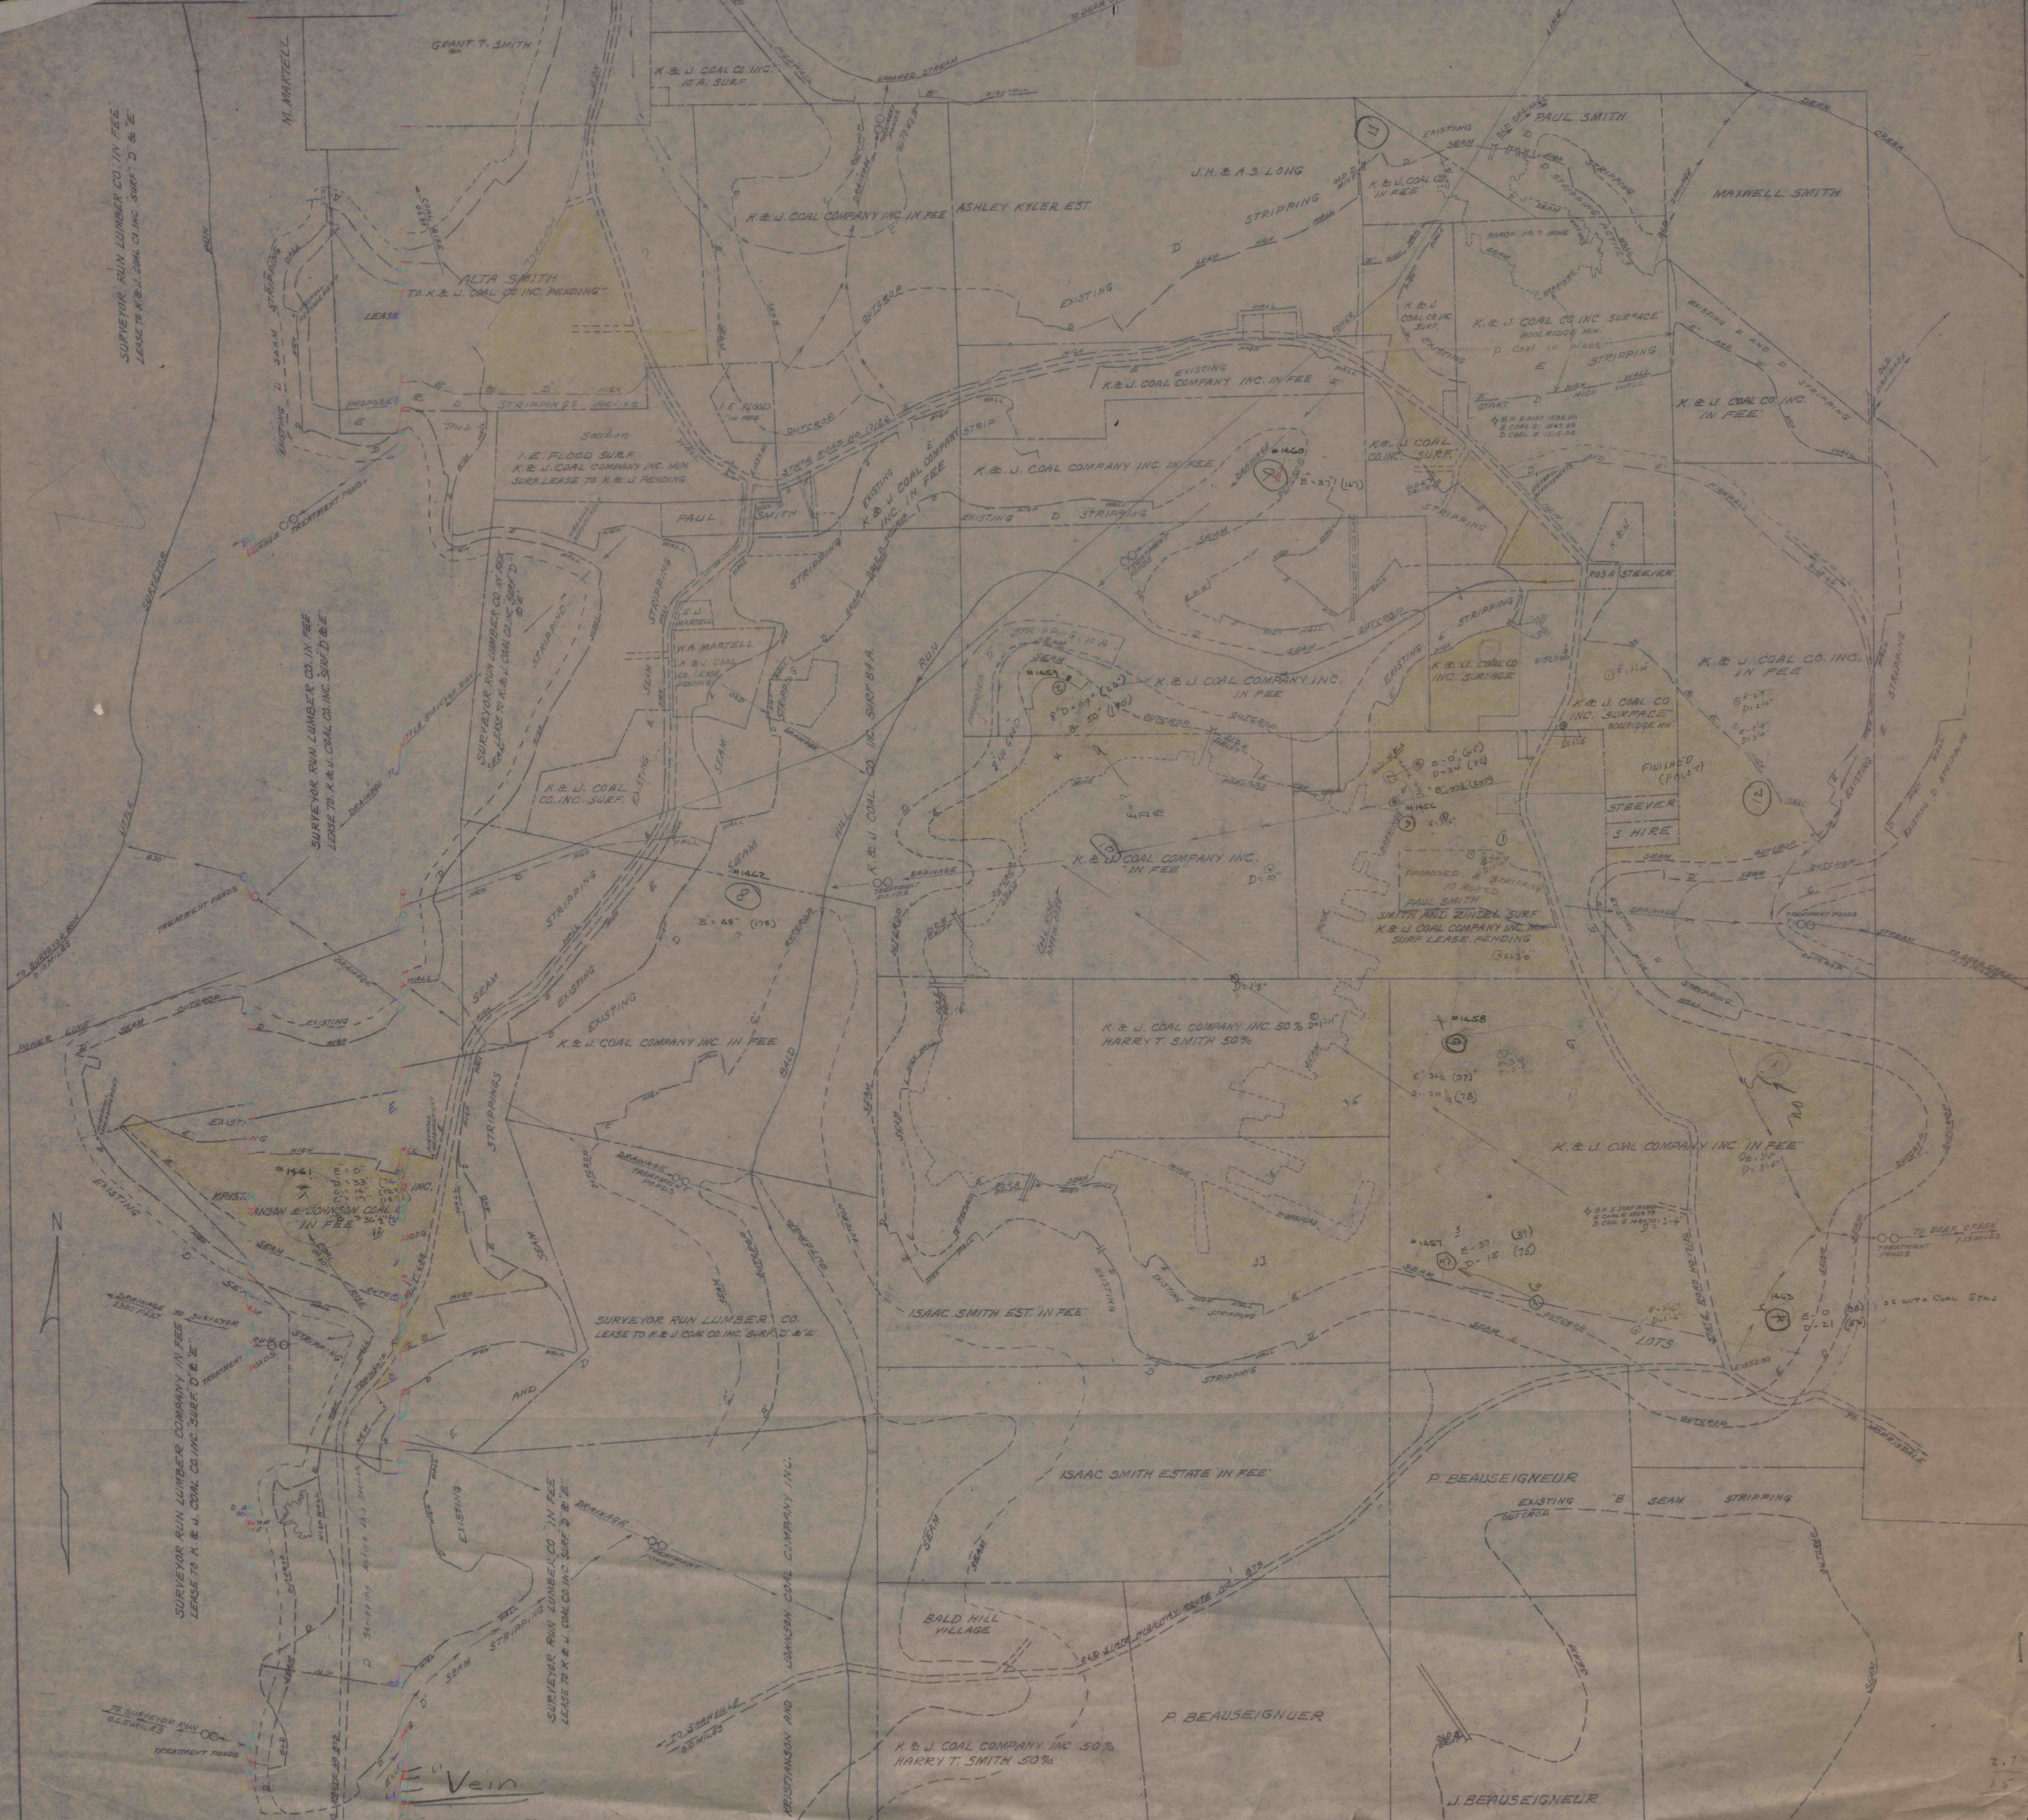

PROPERTY MAP
OPERATED BY K & J PROPOSED C & D A
SCALE 1/4" = 400' SHIP CLEARANCE
DATE SEPT. 23, 1966