


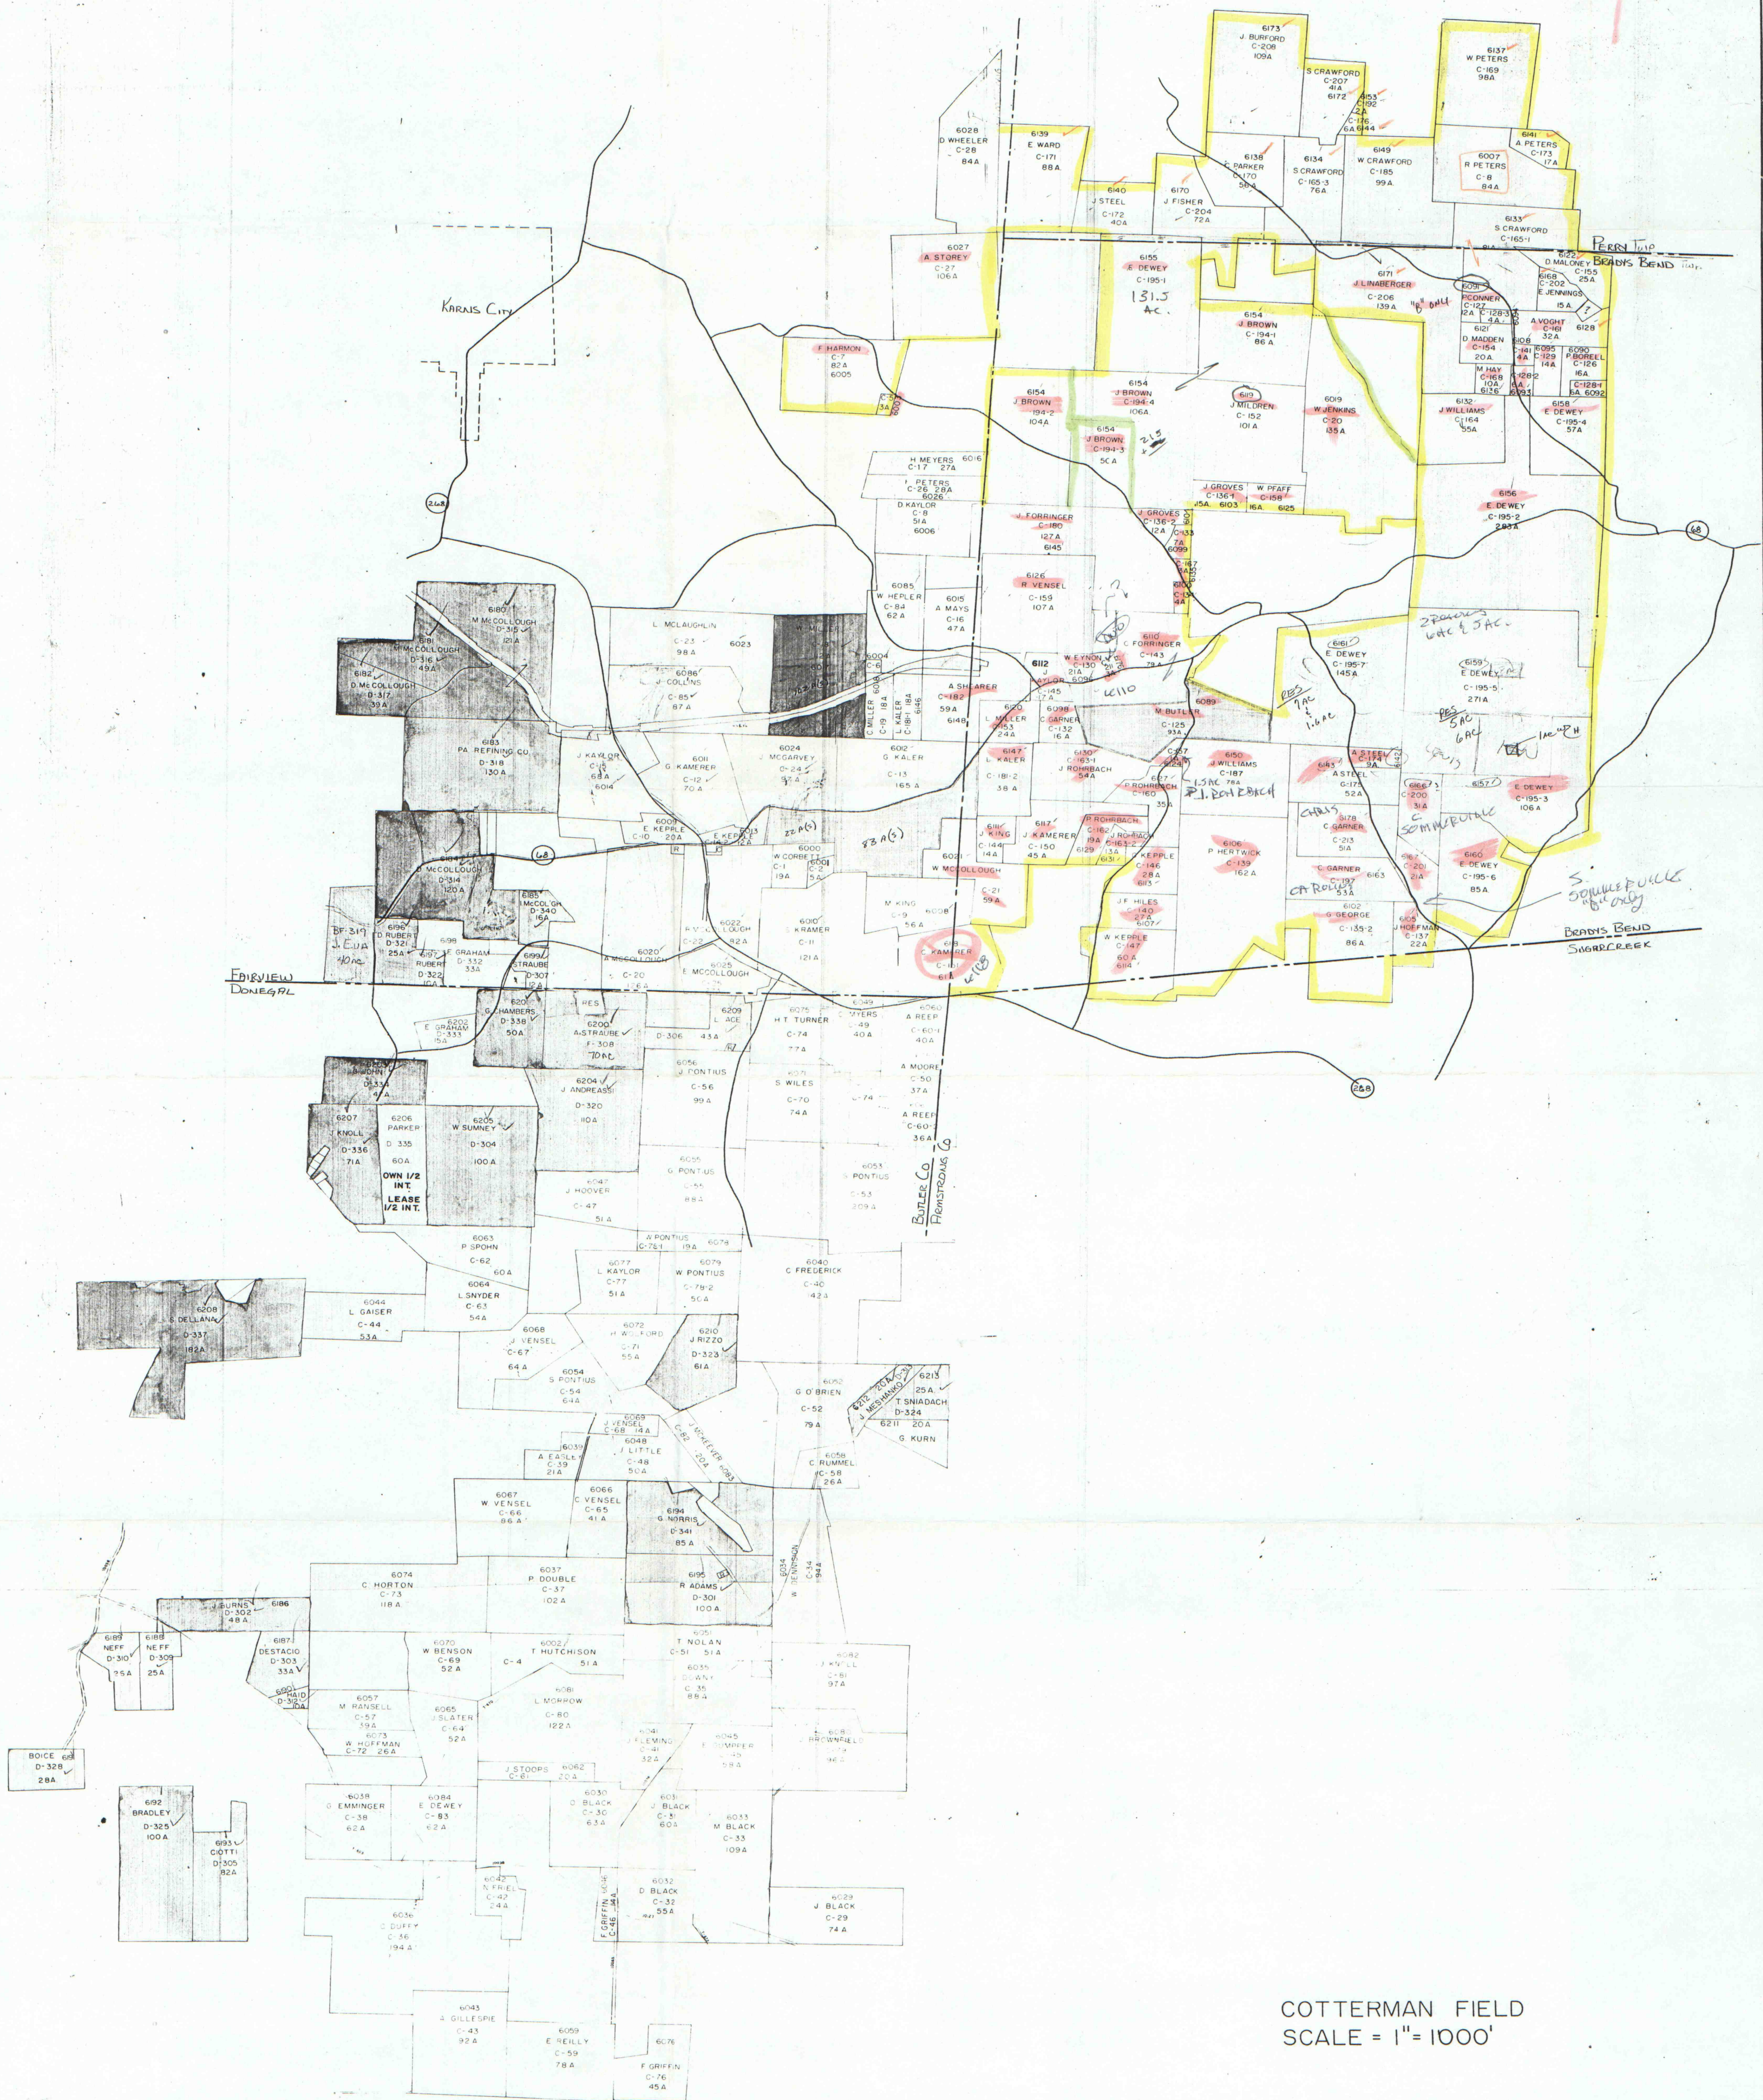

COTTERMAN FIELD
SCALE = 1"= 1000'

IMAPS #17153