


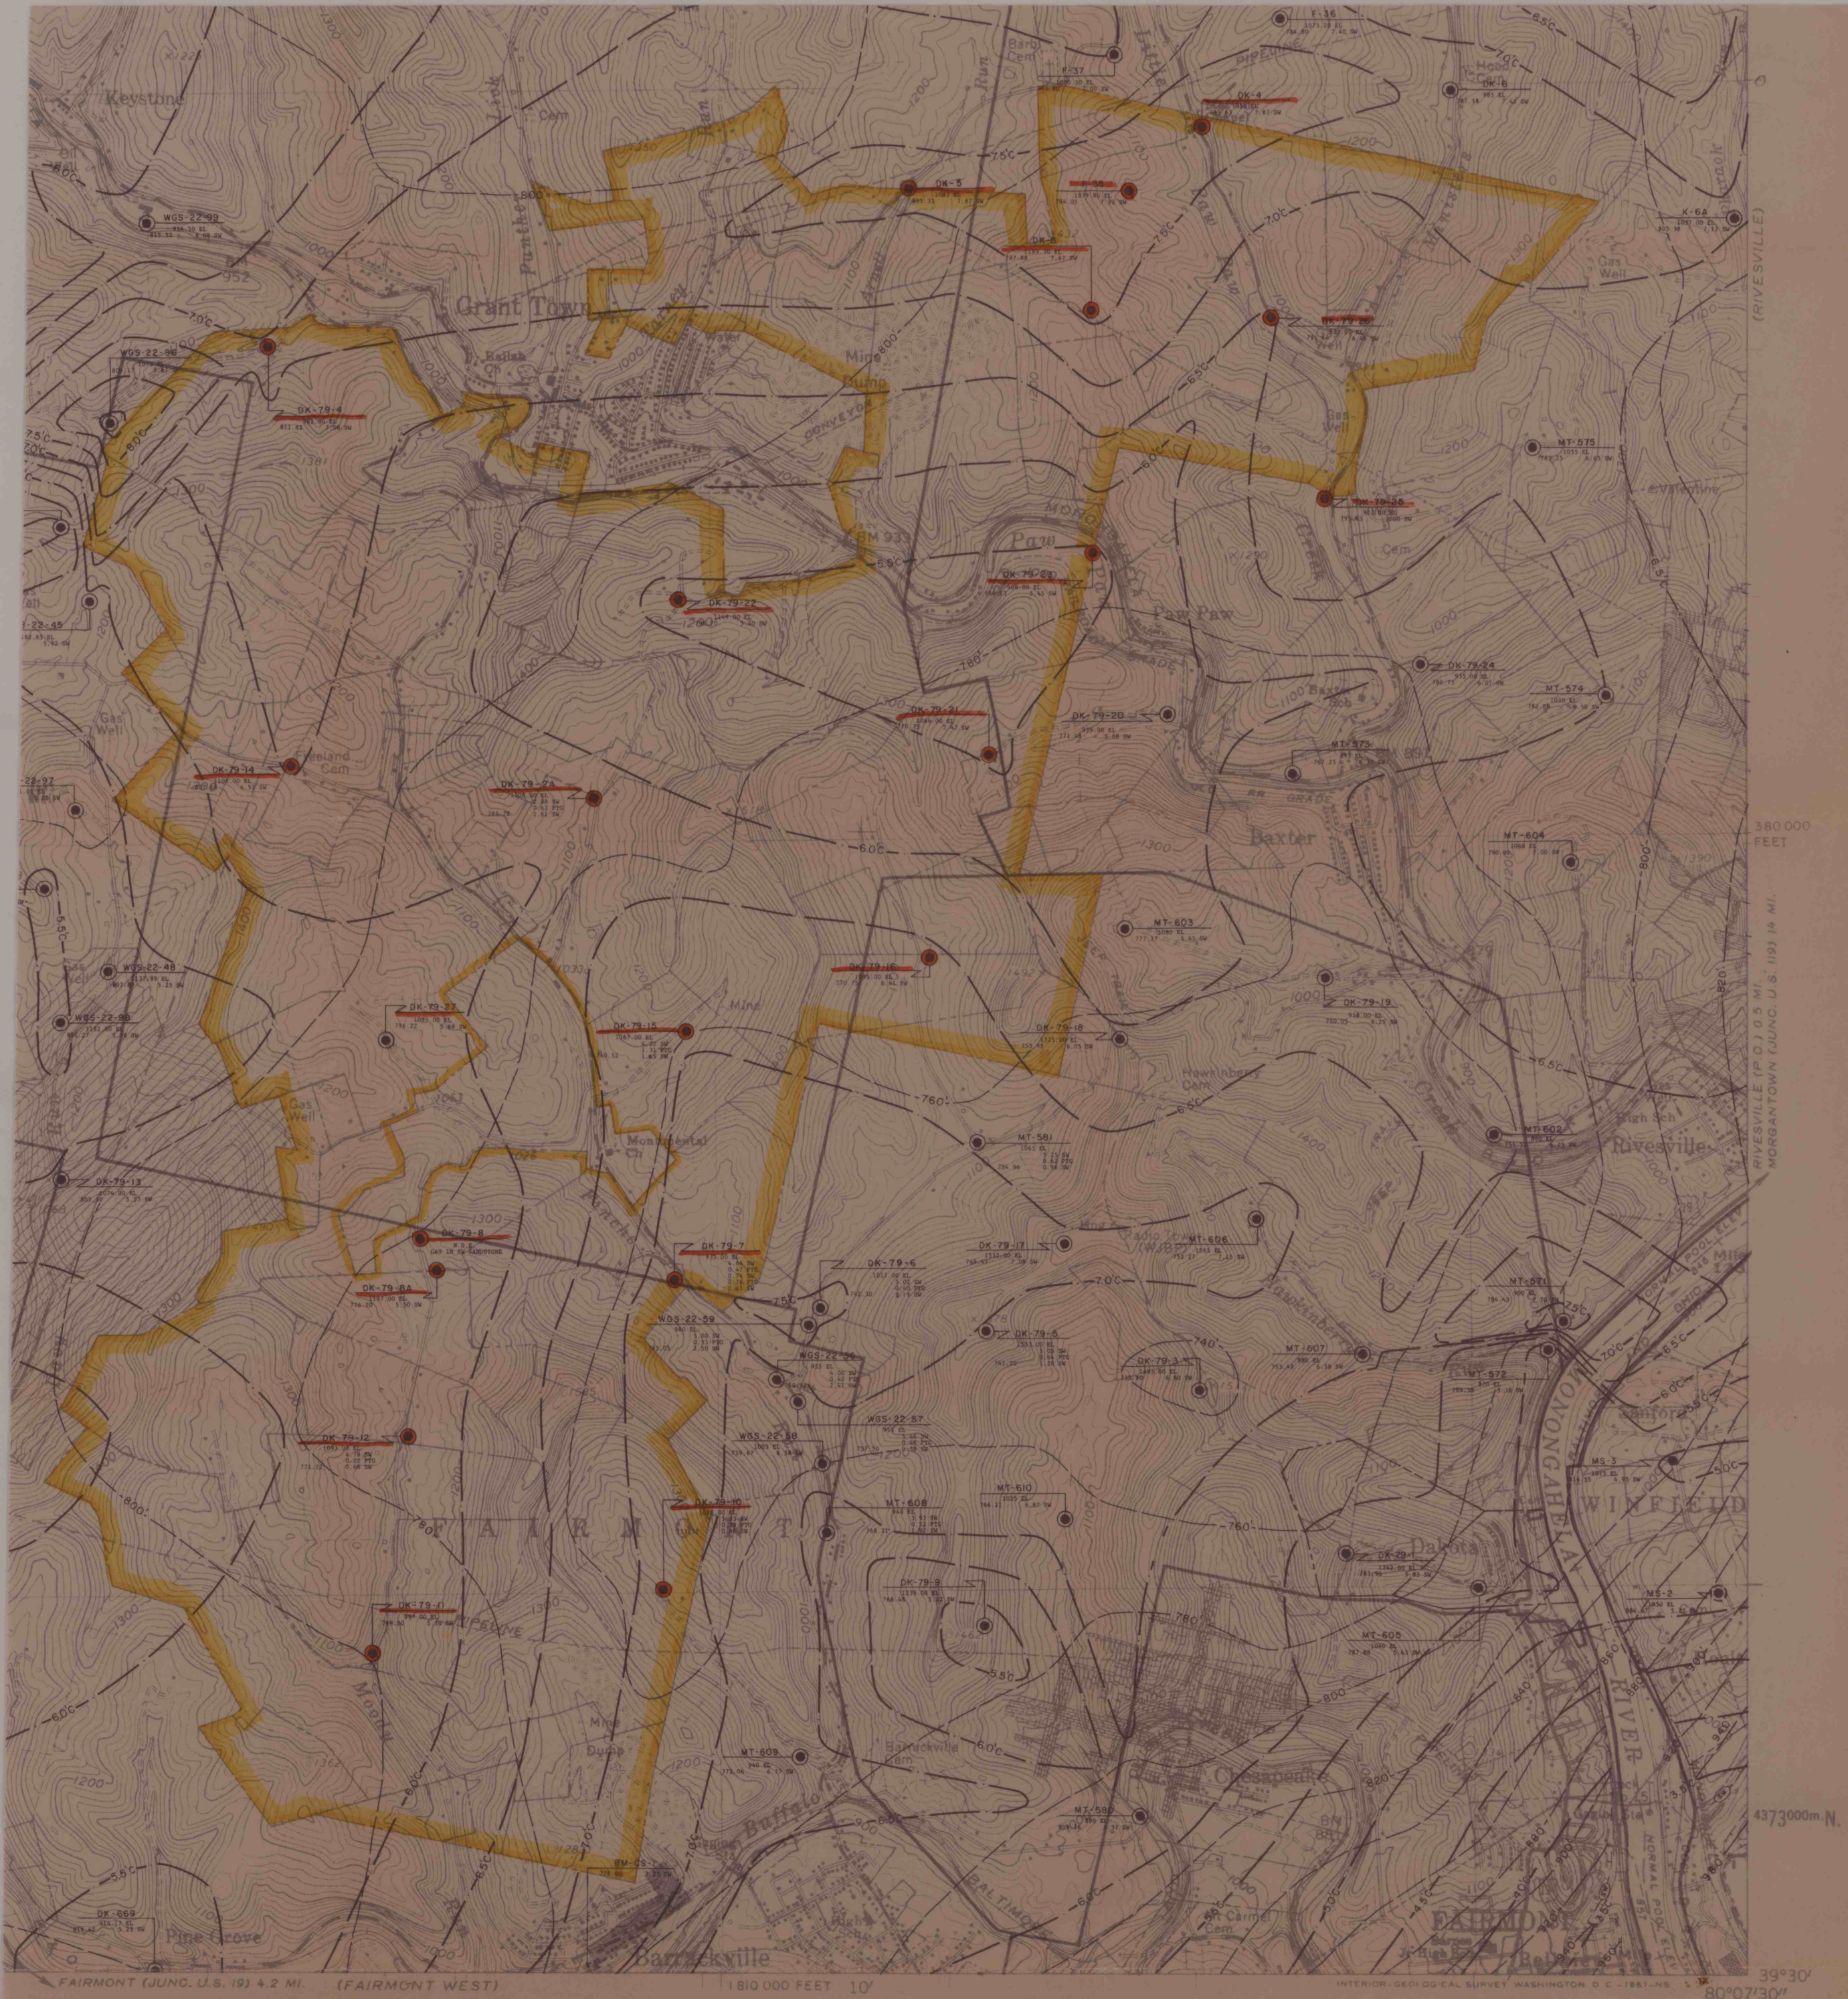

EXPLANATION


- DRILL HOLE CC-328 DRILL HOLE NO.
- SURFACE ELEVATION
- BOTTOM OF COAL ELEVATION SW COAL ID & THICKNESS
- TOTAL THICKNESS OF SEWICKLEY COAL COAL BENCHES
- BOTTOM OF COAL ELEVATION SHALE PARTING
- PROPERTY BOUNDARY
- PITTSBURGH MINE/RESERVE BOUNDARY
- MAIN BENCH COAL ISOPACH CONTOUR INTERVAL 0.5 FEET
- BOTTOM OF COAL STRUCTURE CONTOUR INTERVAL 20 FEET
- SEWICKLEY COAL BED CROP LINE

- ROTARY SPOT CORE
- ROTARY HOLE
- CORE HOLE
- DRILLERS LOG ELEVATION ESTIMATED
- GEOPHYSICAL LOG ELEVATION SURVEYED
- MINE OR CROP SAMPLE (FROM W.V.A., GEOL. SURVEY)



R & P SEWICKLEY COAL LEASED BY CONSOL
(LEASE DROPPED IN 1992)

CONSOLIDATION COAL COMPANY NORTHERN APPALACHIAN EXPLORATION SEWICKLEY COAL BED REGIONAL STUDY GRANT TOWN QUADRANGLE MONONGALIA & MARION COS., W.VA. GEOLOGY MAP

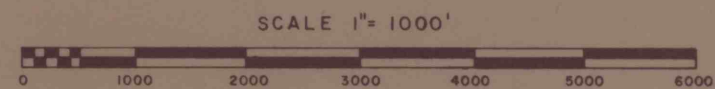

TOPO BASE CONTOUR INTERVAL 20'

PREPARED BY E. THOMAS
DRAWN BY H. WALTER
JANUARY 1985