


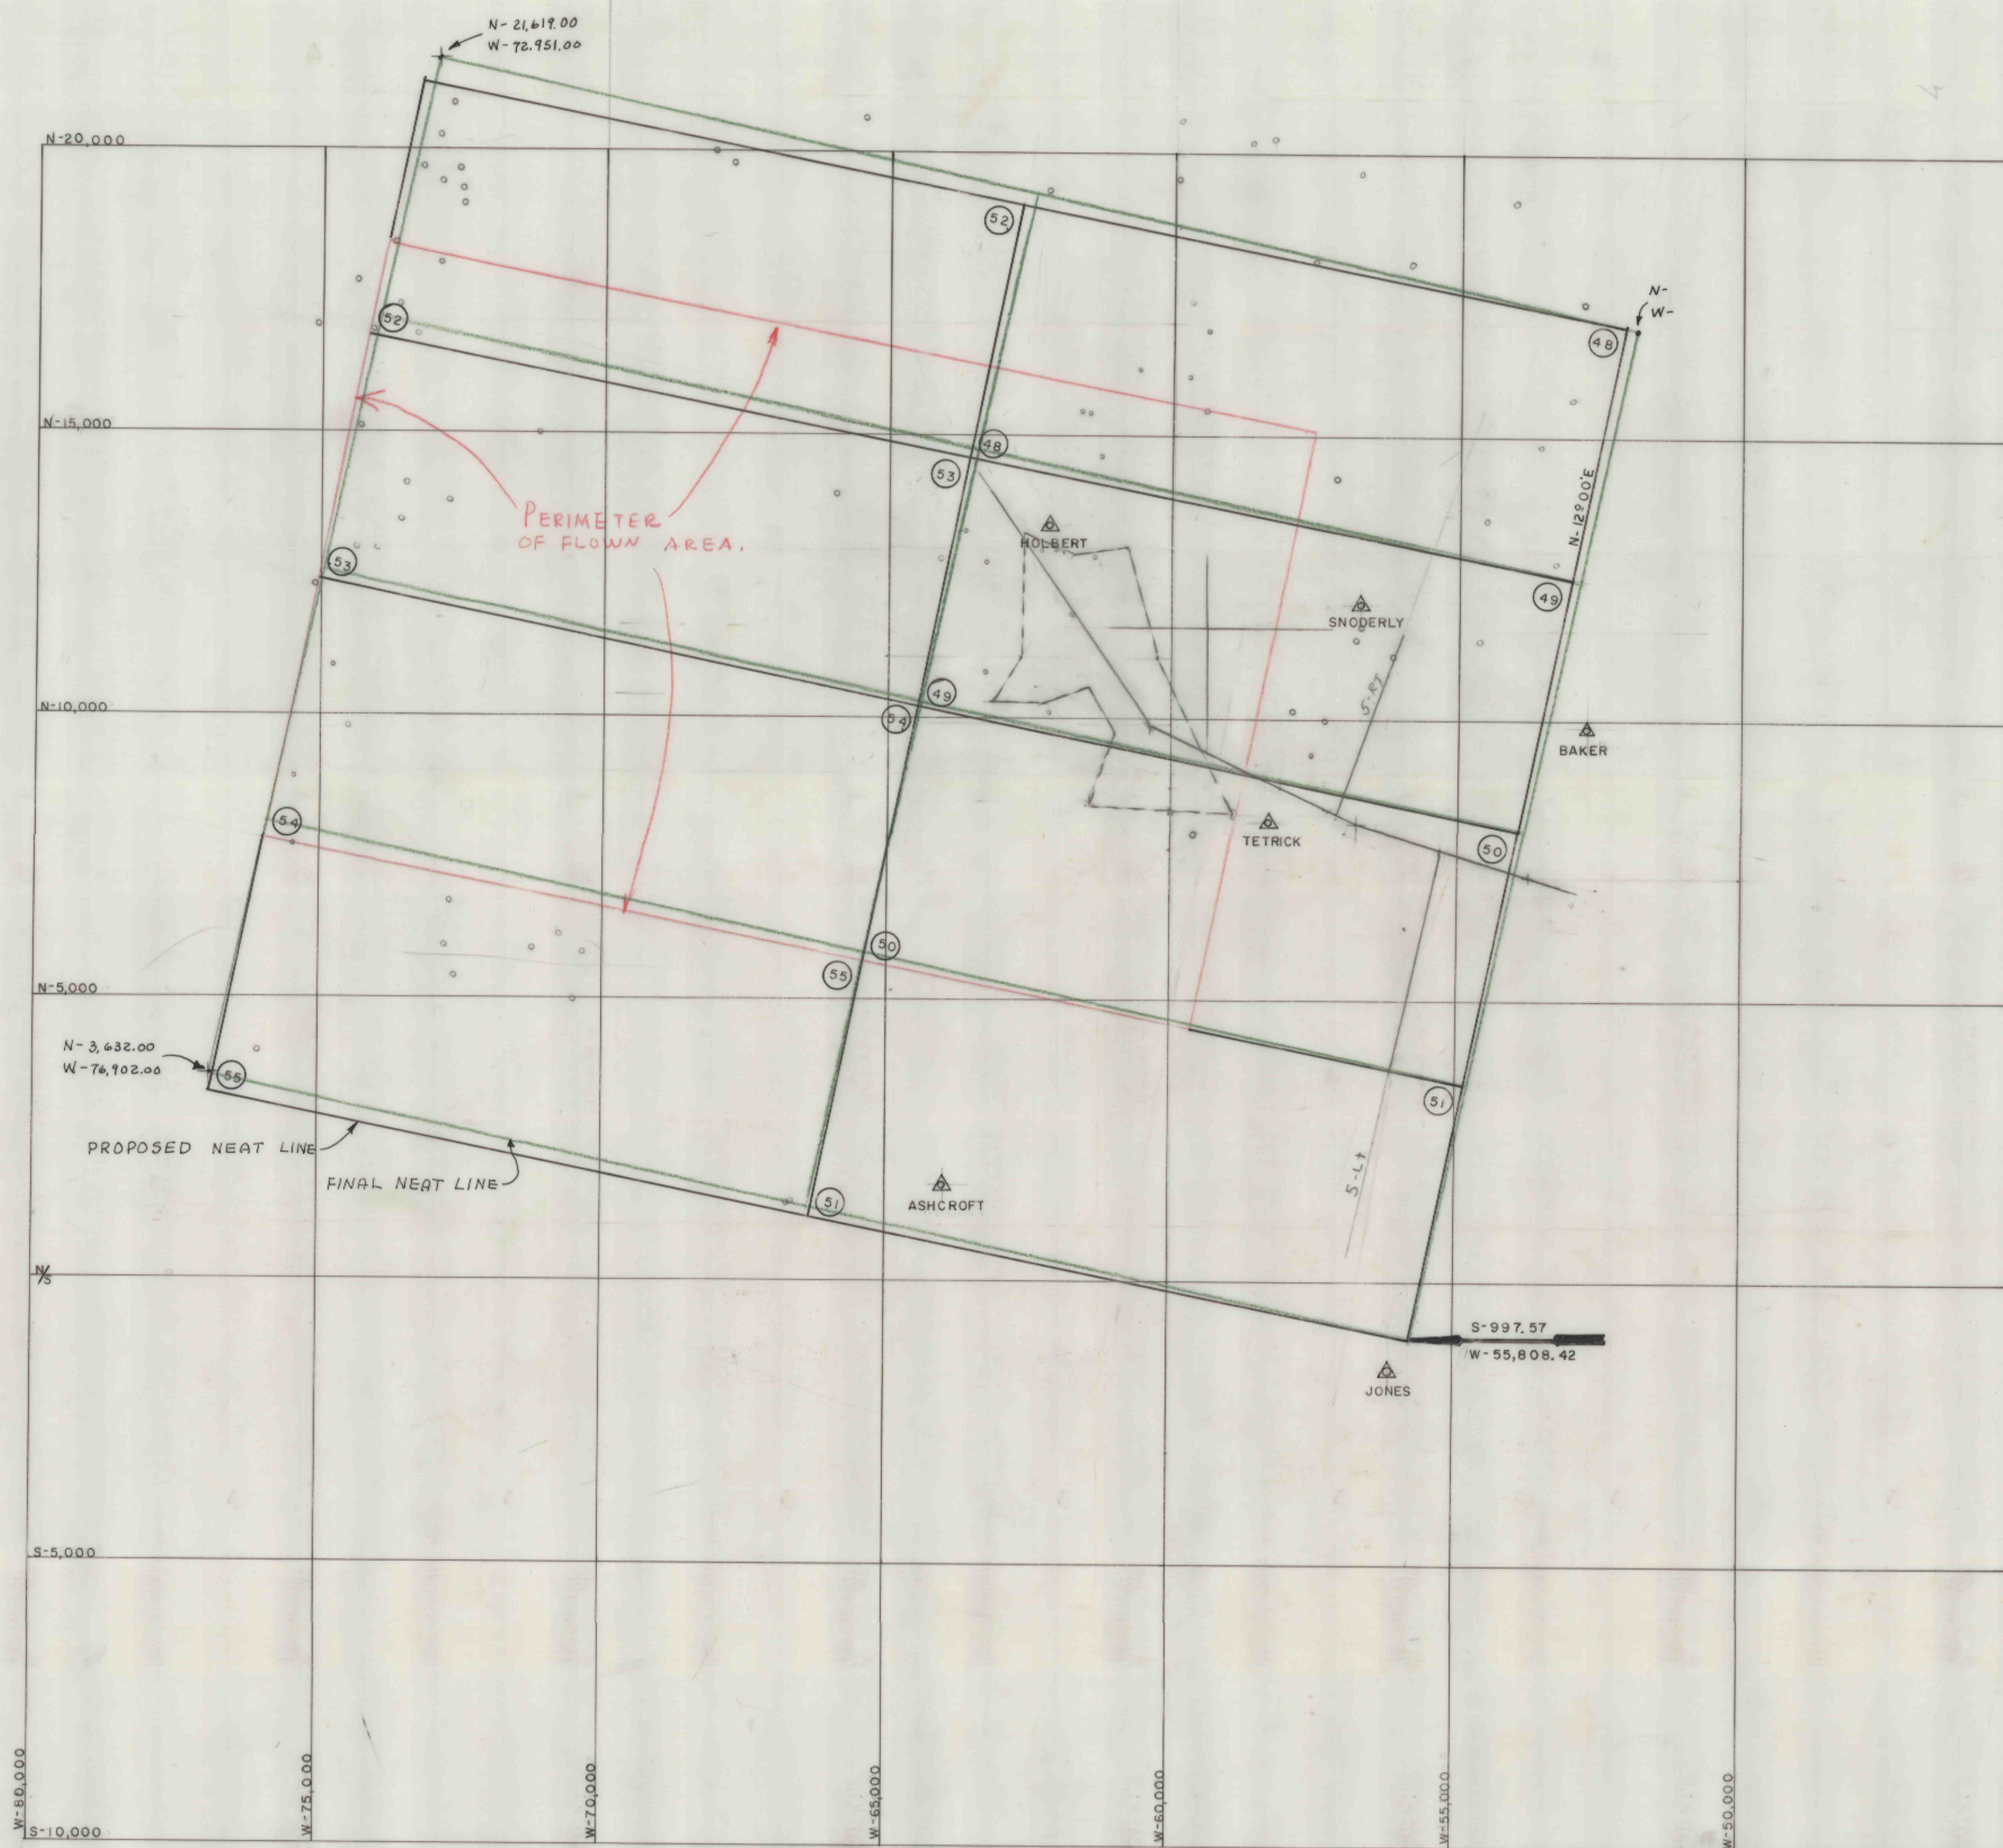

IMAPS # 17236