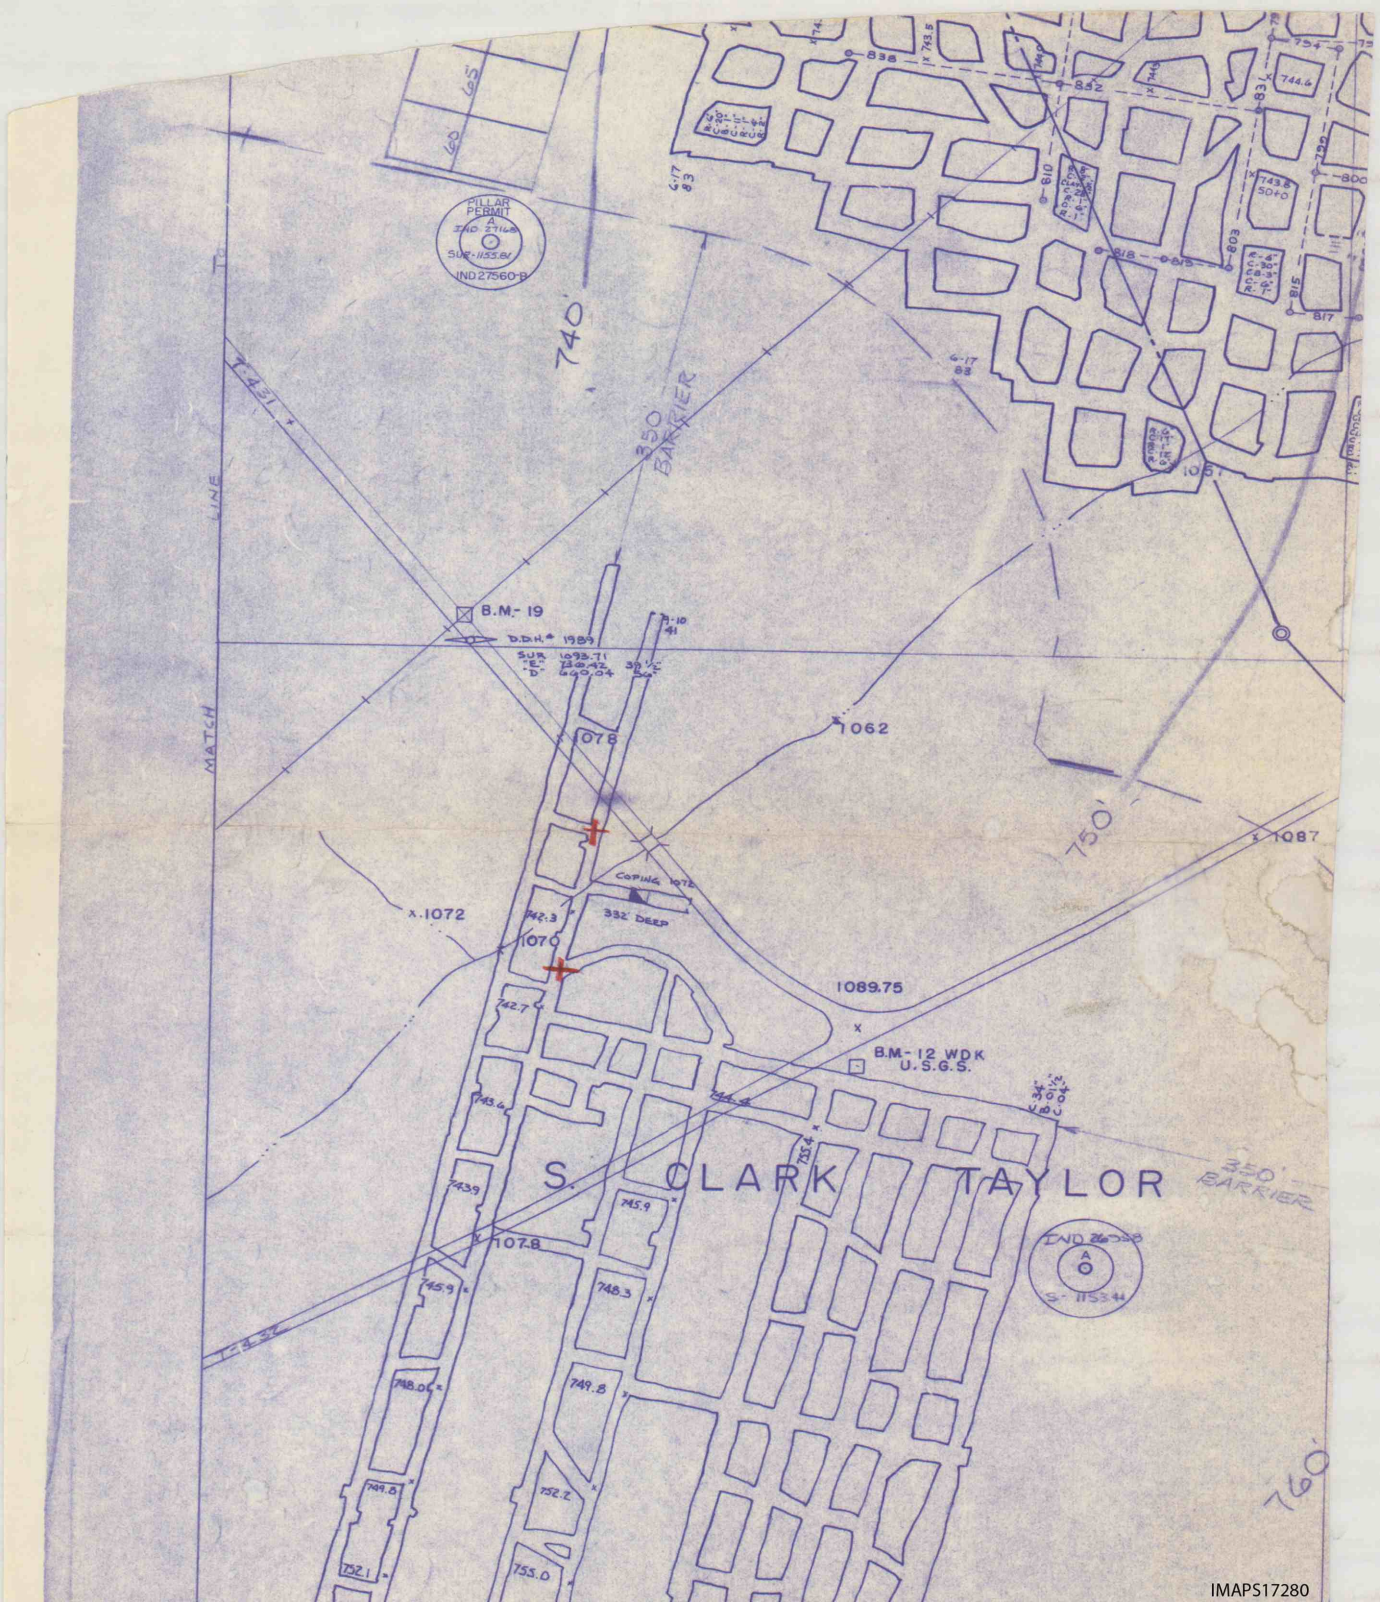
PILLAR PERMIT A IND 27560 SUB-1155.84 IND 27560-B
740'
350' BARRIER
MATCH LINE
B.M.- 19
D.D.H.# 1989
SUB 1093.71 E 1300.42 D 600.04
1062
1076
1087
750'
COPING 1076
332' DEEP
1072
1070
1089.75
B.M.-12 WDK U.S.G.S.
S. CLARK TAYLOR
350' BARRIER
END 26538 A S-1155.44
750'

IMAPS17280