


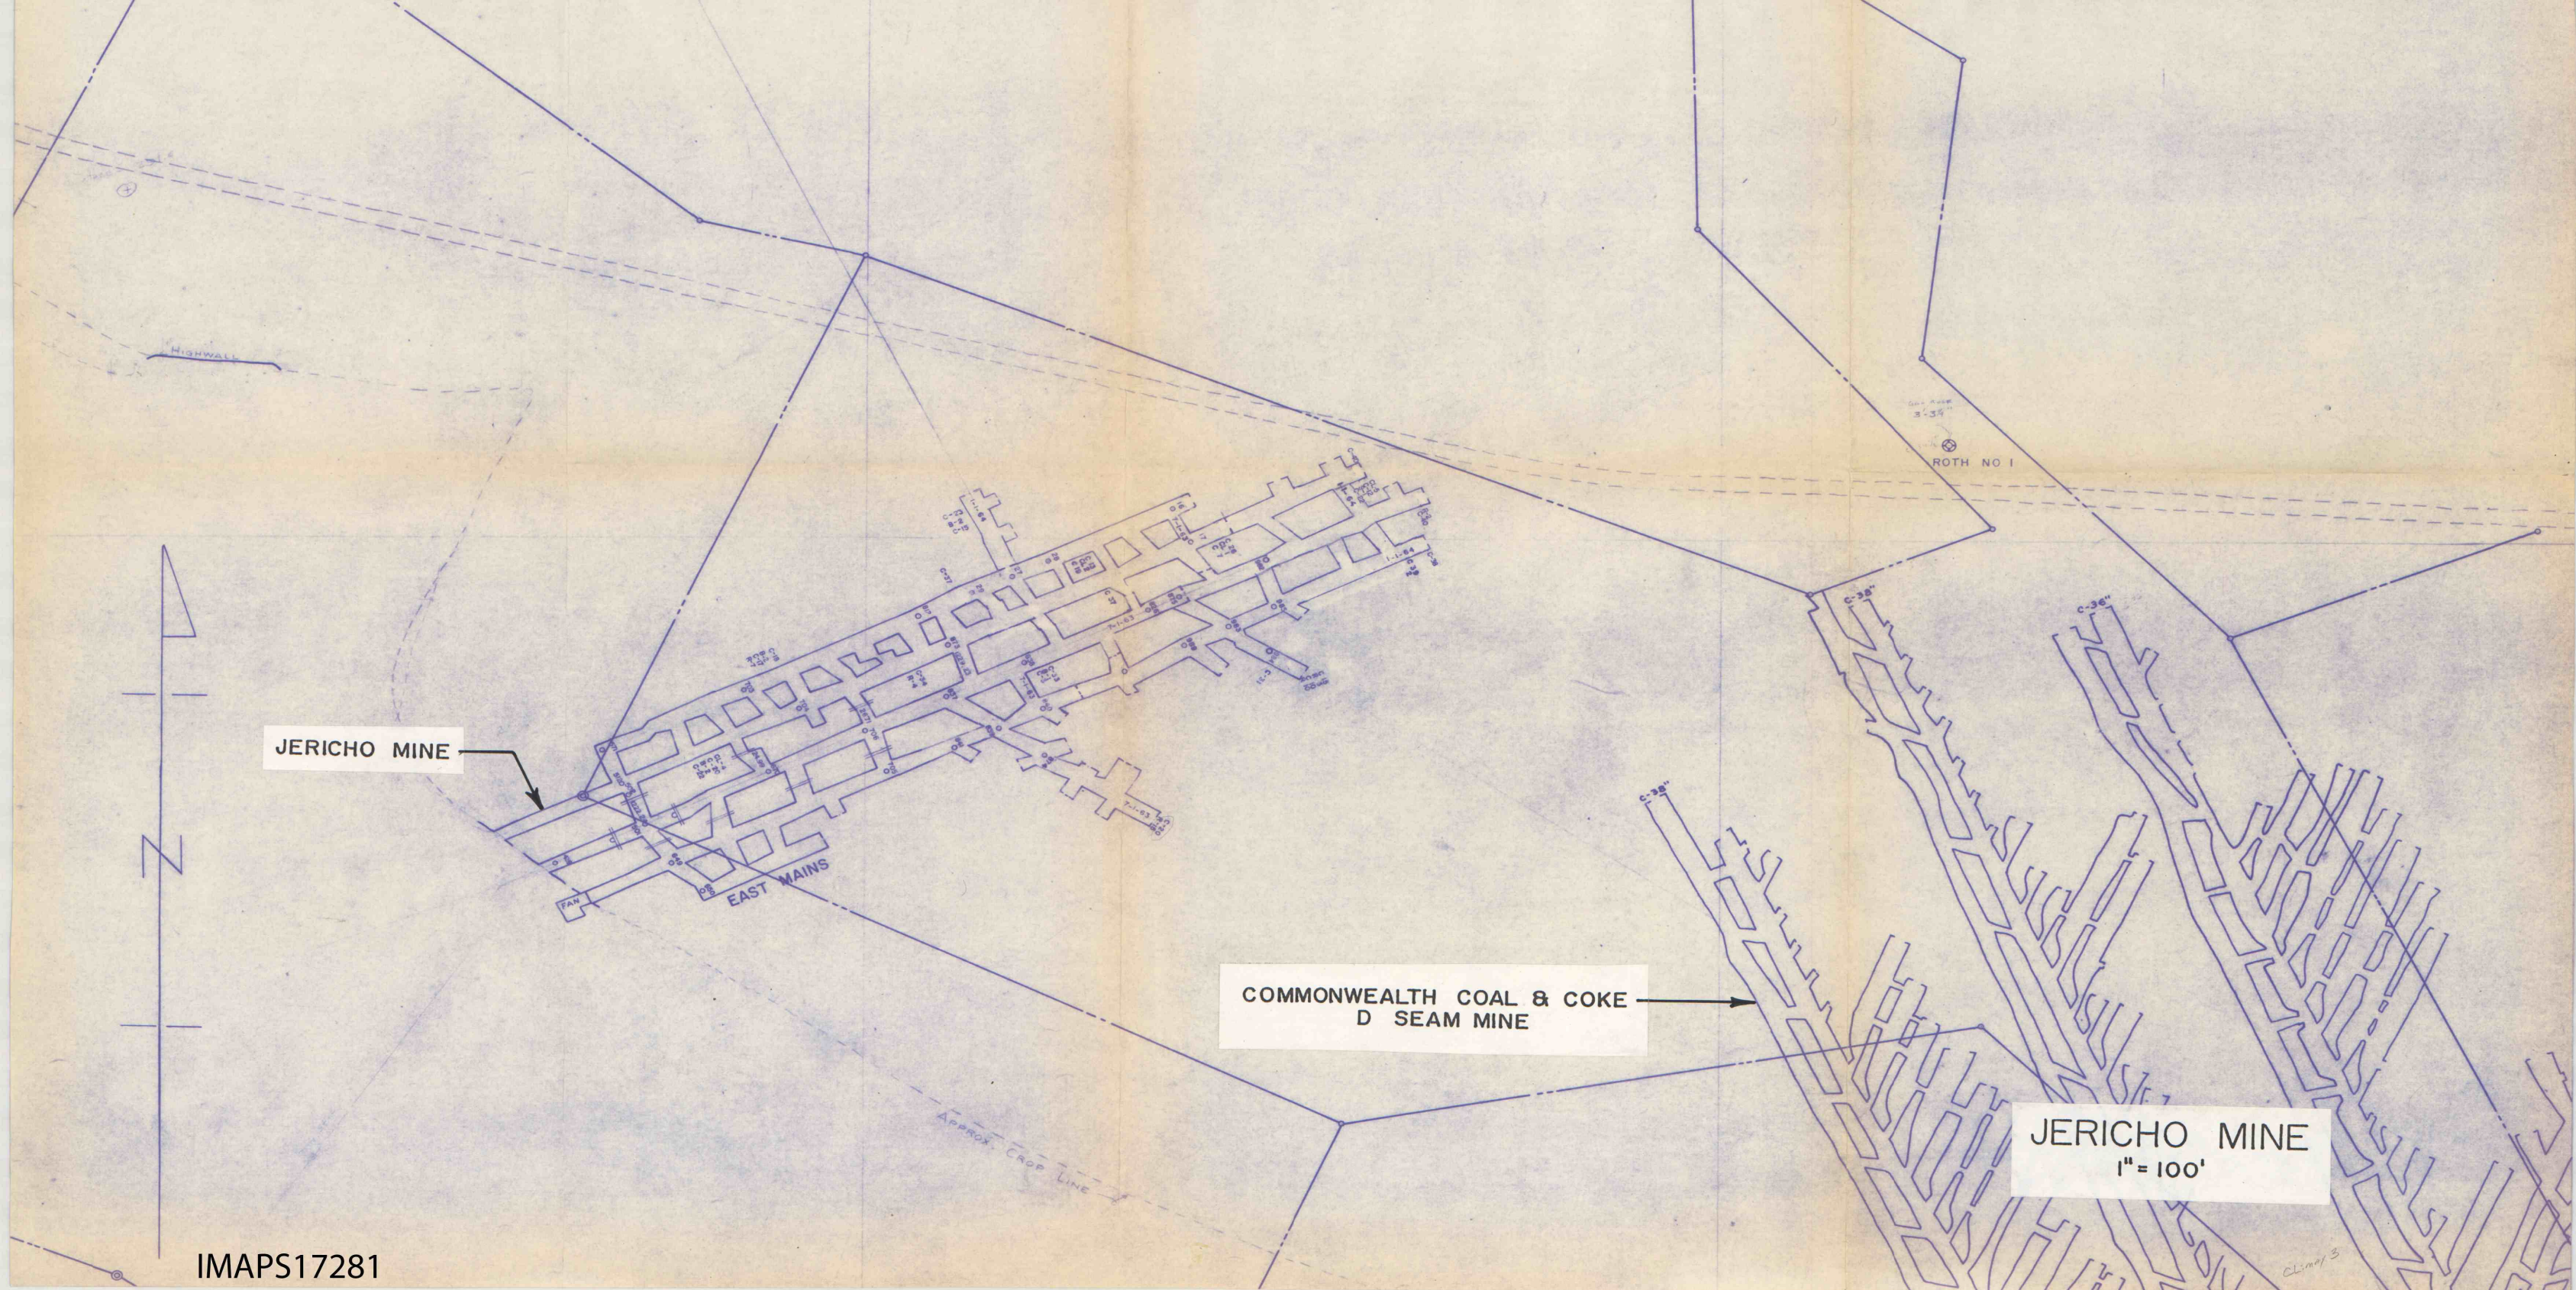

JERICO MINE

COMMONWEALTH COAL & COKE
D SEAM MINE

JERICO MINE
1" = 100'