


D. D. Hole, V.C. No. 5.
On Johnston & Weier Tract
Co-ord. EIV. 1800.00

D. D. Hole, V.C. No. 4.
On Eliza Underwood Tract
Co-ord.

D. D. Hole, V.C. No. 3.
On Cunningham Tract
Co-ord.

D. D. Hole, V.C. No. 2.
On McCormack Tract
Co-ord.

D. D. Hole, V.C. No. 1.
Below No 16 Mine
Co-ord.

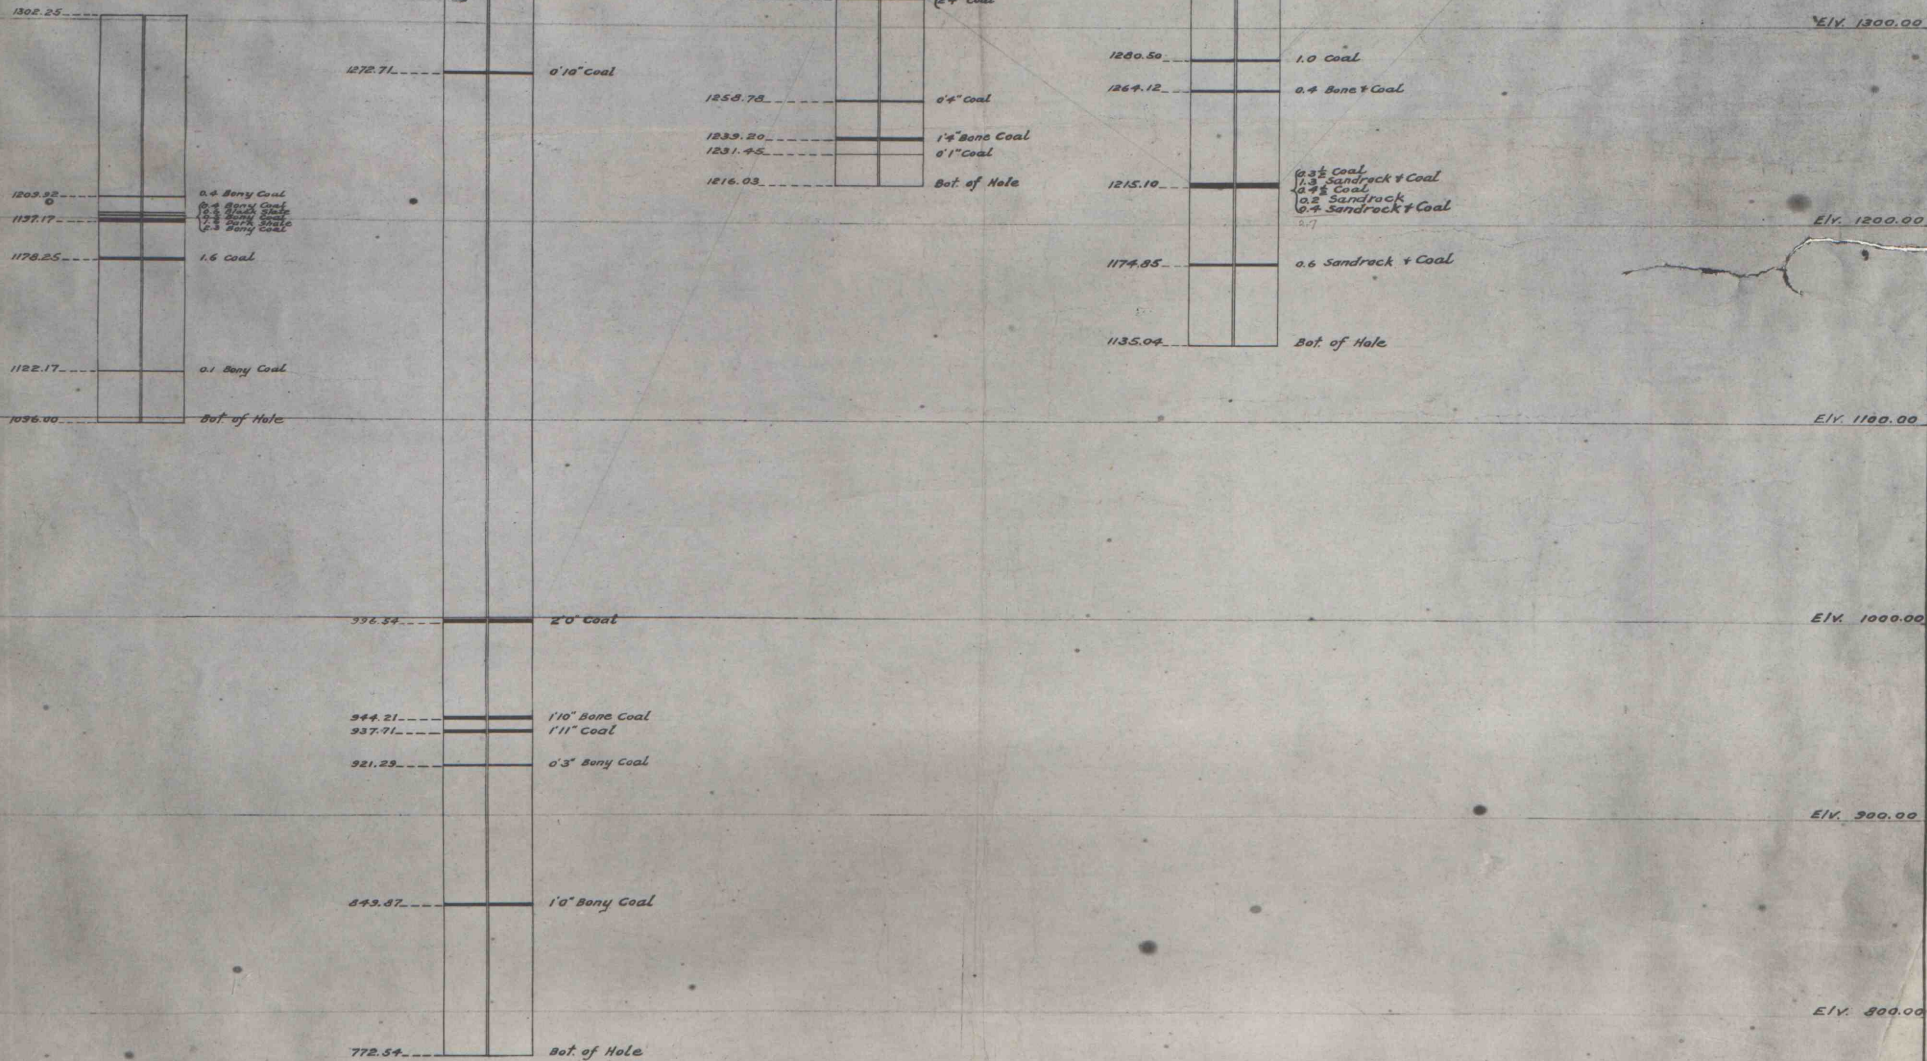

Vinton Colliery Company
Tidal Elevations of
Bore Holes & Coal Openings

IMAPS # 17286